

PERMANENT STEEL SHEET PILING

STA. 599+79 - 601+20, LT  
 STA. 600+14 - 600+99, RT

15" CPEP (SL)  
 STA. 599+50 - 599+56.5, LT

STONE FILL, TYPE I

STA. 599+50 - 603+20, L & RT  
 STA. 599+56.5 - 603+20, LT

DEMOLISHED PER  
 AGREEMENT WITH DISTRICT  
 3 GARAGE, CASTLETON.

STONE FILL, TYPE I (TYP)

BRUSH

CLASS II WETLAND

3' x 3'  
 STONE  
 BOX

CLARENDON & PITTSFORD RAILROAD

TO CASTLETON


TO HYDEVILLE

PERMANENT STEEL SHEET  
 PILING (TYP)

FRA DOT #248-948G  
 MP A88.86

CLASS II WETLAND

PI  
 STA 603+88.35

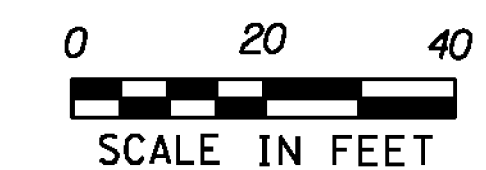

PROJECT NAME: CASTLETON  
 PROJECT NUMBER: BRF 015-2(10)

FILE NAME: z12b138bdr\_nul.dgn  
 PROJECT LEADER: S.E. BURBANK  
 DESIGNED BY: E.A. FIALA  
 RAIL LAYOUT SHEET (3 OF 4)

PLOT DATE: 9/19/2014  
 DRAWN BY: E.A. FIALA  
 CHECKED BY: S.E. BURBANK  
 SHEET 20 OF 82

