


NEW SURVEY NEEDED AS ELEVATIONS
WHERE LEFT LOW OF PLAN BELOW AND
BRIDGE APPROACH.

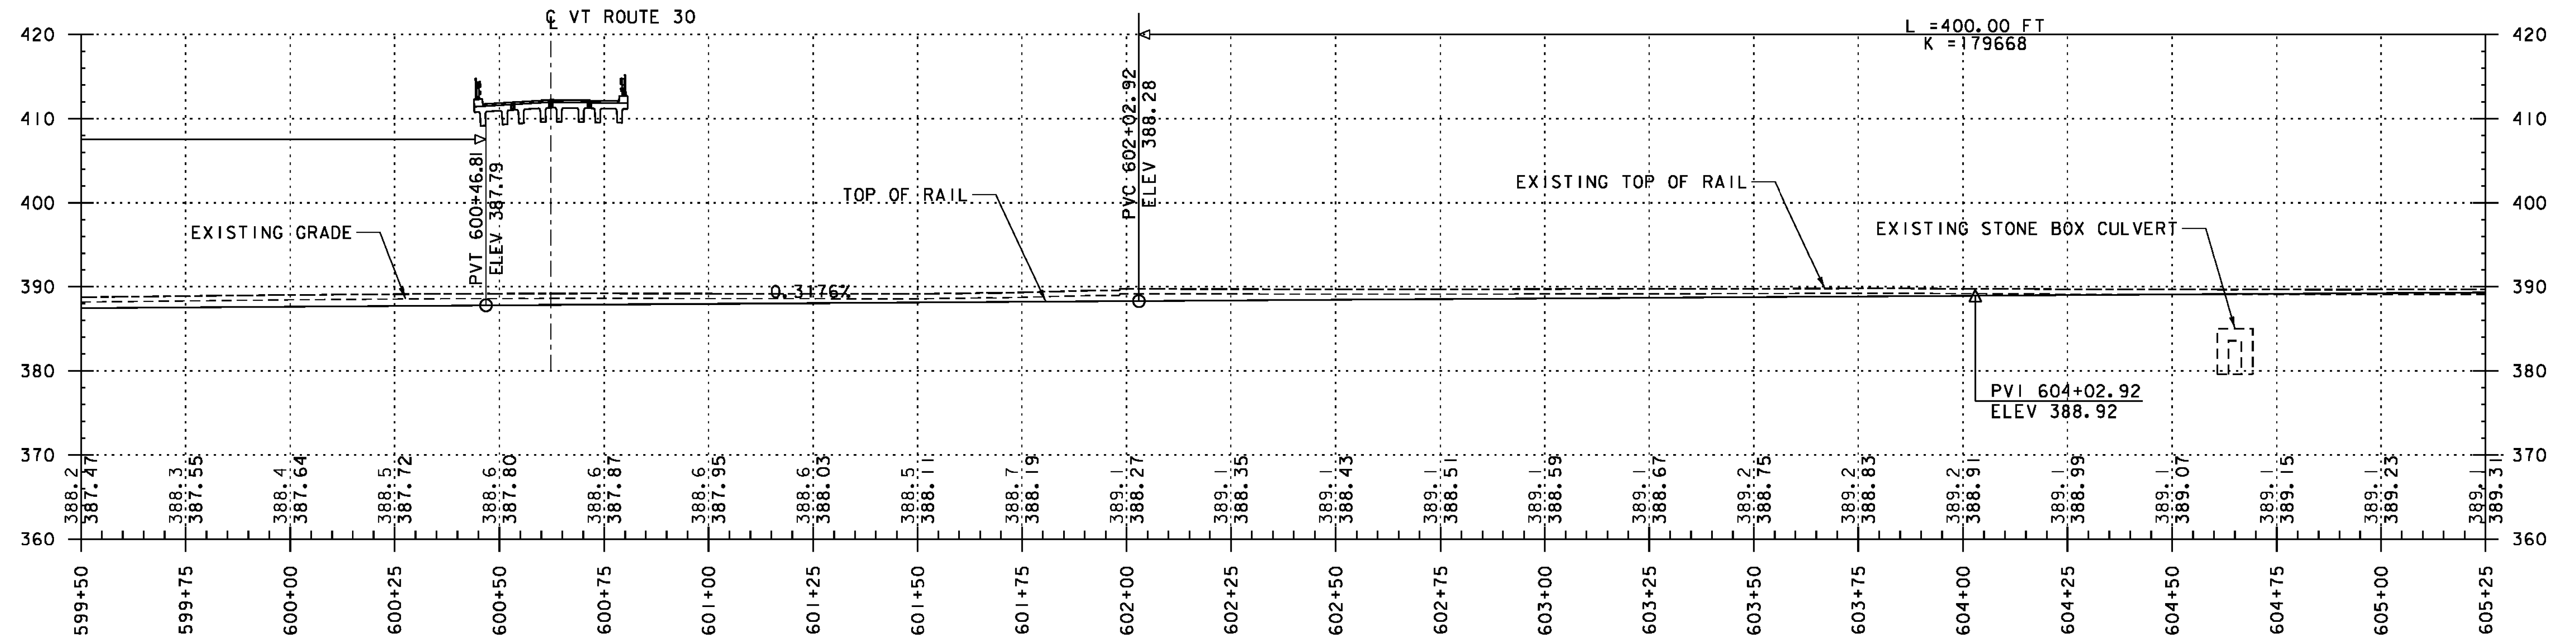

RAIL PROFILE
SCALE 1" = 20' VERTICAL
1" = 10' HORIZONTAL

NOTE:

GRADES SHOWN TO THE NEAREST
TENTH ARE EXISTING GRADE ALONG ϕ

GRADES SHOWN TO THE NEAREST
HUNDREDTH ARE HIGHEST TOP OF RAIL ALONG ϕ

PROJECT NAME: CASTLETON
PROJECT NUMBER: BRF 015-2(10)

FILE NAME: z12b138pro_rail.dgn
PROJECT LEADER: S.E. BURBANK
DESIGNED BY: E.A. FIALA
RAIL PROFILE SHEET (2 OF 3)

PLOT DATE: 9/19/2014
DRAWN BY: E.A. FIALA
CHECKED BY: S.E. BURBANK
SHEET 23 OF 82

