

**TRAFFIC CONTROL NOTES:**

1. INSTALL CONFIRMATORY ROUTE MARKERS ALONG THE DETOUR ROUTE AT THE INTERSECTIONS AND MILE MARKERS AS INDICATED ON THIS PLAN.
2. WHEN EXISTING ROUTE MARKER ASSEMBLIES ARE LOCATED AT THE INTERSECTIONS OR ALONG THE DETOUR ROUTE THE DETOUR ROUTE MARKER ASSEMBLIES SHALL BE INSTALLED ADJACENT TO THE EXISTING ROUTE MARKER ASSEMBLIES.
3. SEE TCP (2 OF 6) AND TCP (3 OF 6) FOR DETAILS A THROUGH F.
4. THE REGIONAL DETOUR FOR THIS PROJECT EXTENDS INTO NEW YORK STATE AND UTILIZES WASHINGTON COUNTY ROUTE 18A AND NEW YORK STATE ROUTE 22A. VTRANS HAS COORDINATED WITH THE WASHINGTON COUNTY DEPARTMENT OF PUBLIC WORKS AND THE NEW YORK STATE DEPARTMENT OF TRANSPORTATION (NYSOT) AND HAVE BEEN AUTHORIZED TO DETOUR TRAFFIC FROM VERMONT ONTO THESE ROUTES. IN ORDER TO PERFORM ANY WORK (INSTALLATION OF THE DETOUR SIGNS, ETC.) ON THESE ROADWAYS, THE CONTRACTOR WILL NEED AUTHORIZATION FROM BOTH THE WASHINGTON COUNTY DEPARTMENT OF PUBLIC WORKS AND NYSOT. THE CONTRACTOR SHALL SUBMIT THE FOLLOWING FORMS:


WASHINGTON COUNTY DEPARTMENT OF PUBLIC WORKS PERMIT. POINT OF CONTACT SHOULD BE SCOTT TRACY, DEPUTY SUPERINTENDENT OF THE DEPARTMENT OF PUBLIC WORKS. PHONE NUMBER IS 518-746-2440.

NYSOT HIGHWAY WORK PERMIT APPLICATION FOR NON-UTILITY WORK (FORM PERM 33) AND NYSOT CERTIFICATE OF INSURANCE FOR HIGHWAY WORK PERMIT (PERM 17). POINT OF CONTACT SHOULD BE JOE THOMPSON, NYSOT ASSISTANT RESIDENT ENGINEER IN WASHINGTON COUNTY. PHONE NUMBER IS 518-747-4724.

THE ABOVE LISTED FORMS ARE INCLUDED IN THE PROPOSAL DOCUMENTS AND SHALL BE SUBMITTED A MINIMUM OF FOUR (4) WEEKS PRIOR TO THE ANTICIPATED DATE WORK (INSTALLATION OF SIGNS) SHALL START AND A MINIMUM OF SIX (6) WEEKS PRIOR TO THE BRIDGE CLOSURE PERIOD. THE CONTRACTOR SHALL PERFORM THE SHOULDER CLOSURE FOR THE INSTALLATION AND REMOVAL OF THE DETOUR SIGNS ON NY STATE ROUTE 22A IN ACCORDANCE WITH THE TAST-C7 DOCUMENT INCLUDED IN THE PROPOSAL DOCUMENTS. THIS DOCUMENT SHOULD BE INCLUDED IN THE HIGHWAY WORK PERMIT APPLICATION TO NYSOT.

**LEGEND**

⊕ CONFIRMATORY ROUTE MARKER ASSEMBLY (SEE NOTES 1 & 2 ABOVE)

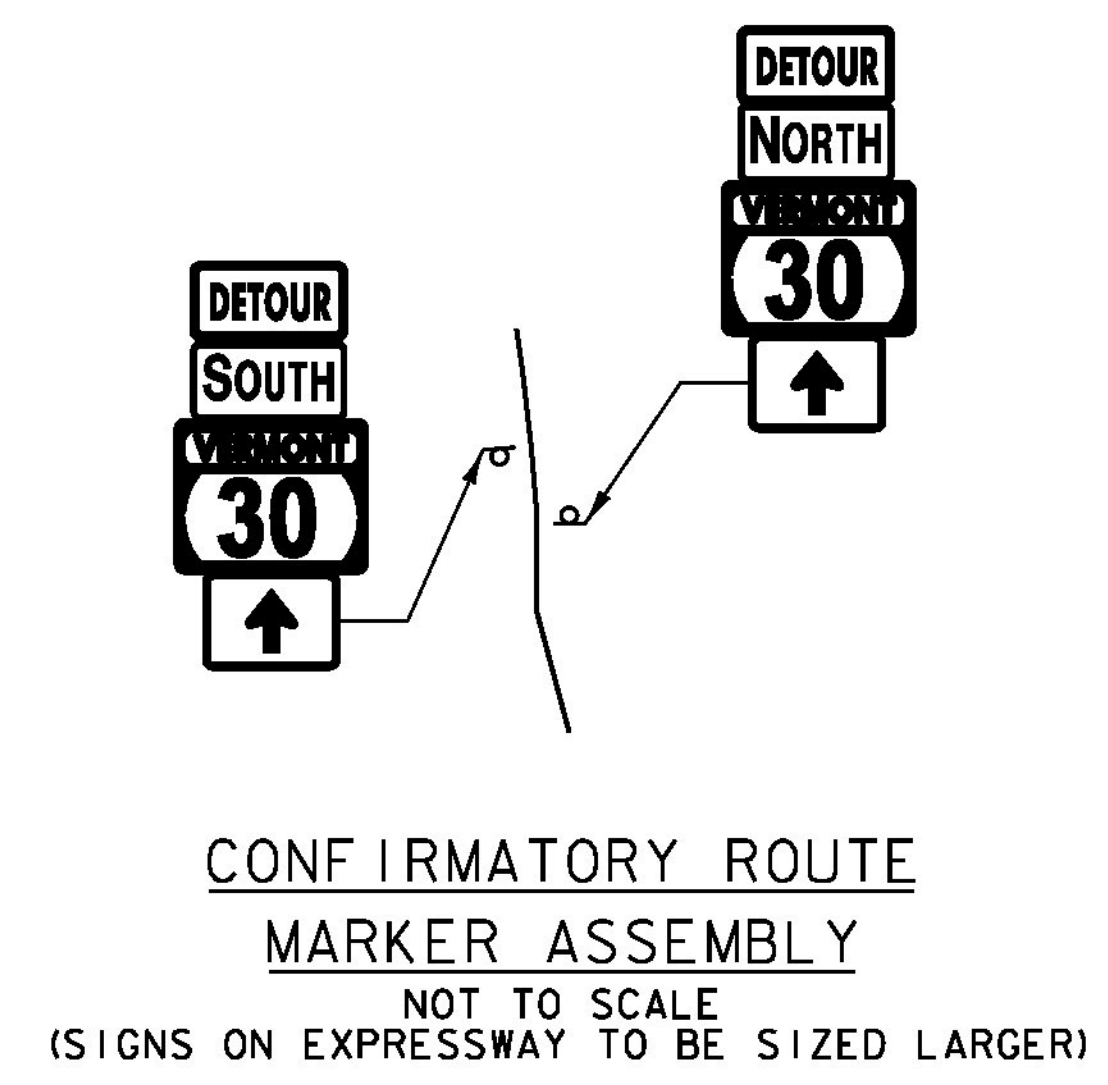

**REGIONAL DETOUR & TRAFFIC CONTROL PLAN**



PROJECT NAME: CASTLETON	
PROJECT NUMBER: BRF 015-2(10)	
FILE NAME: z12bi38+tcp.dgn	PLOT DATE: 10/29/2014
PROJECT LEADER: S.E. BURBANK	DRAWN BY: D.A. GINGRAS
DESIGNED BY: VTRANS	CHECKED BY: S.E. BURBANK
TRAFFIC CONTROL PLAN (1 OF 6)	SHEET 25 OF 82