



INSULATION BOARD
 STA. 599+39 - 599+50, RT
 STA. 599+43 - 599+54, LT

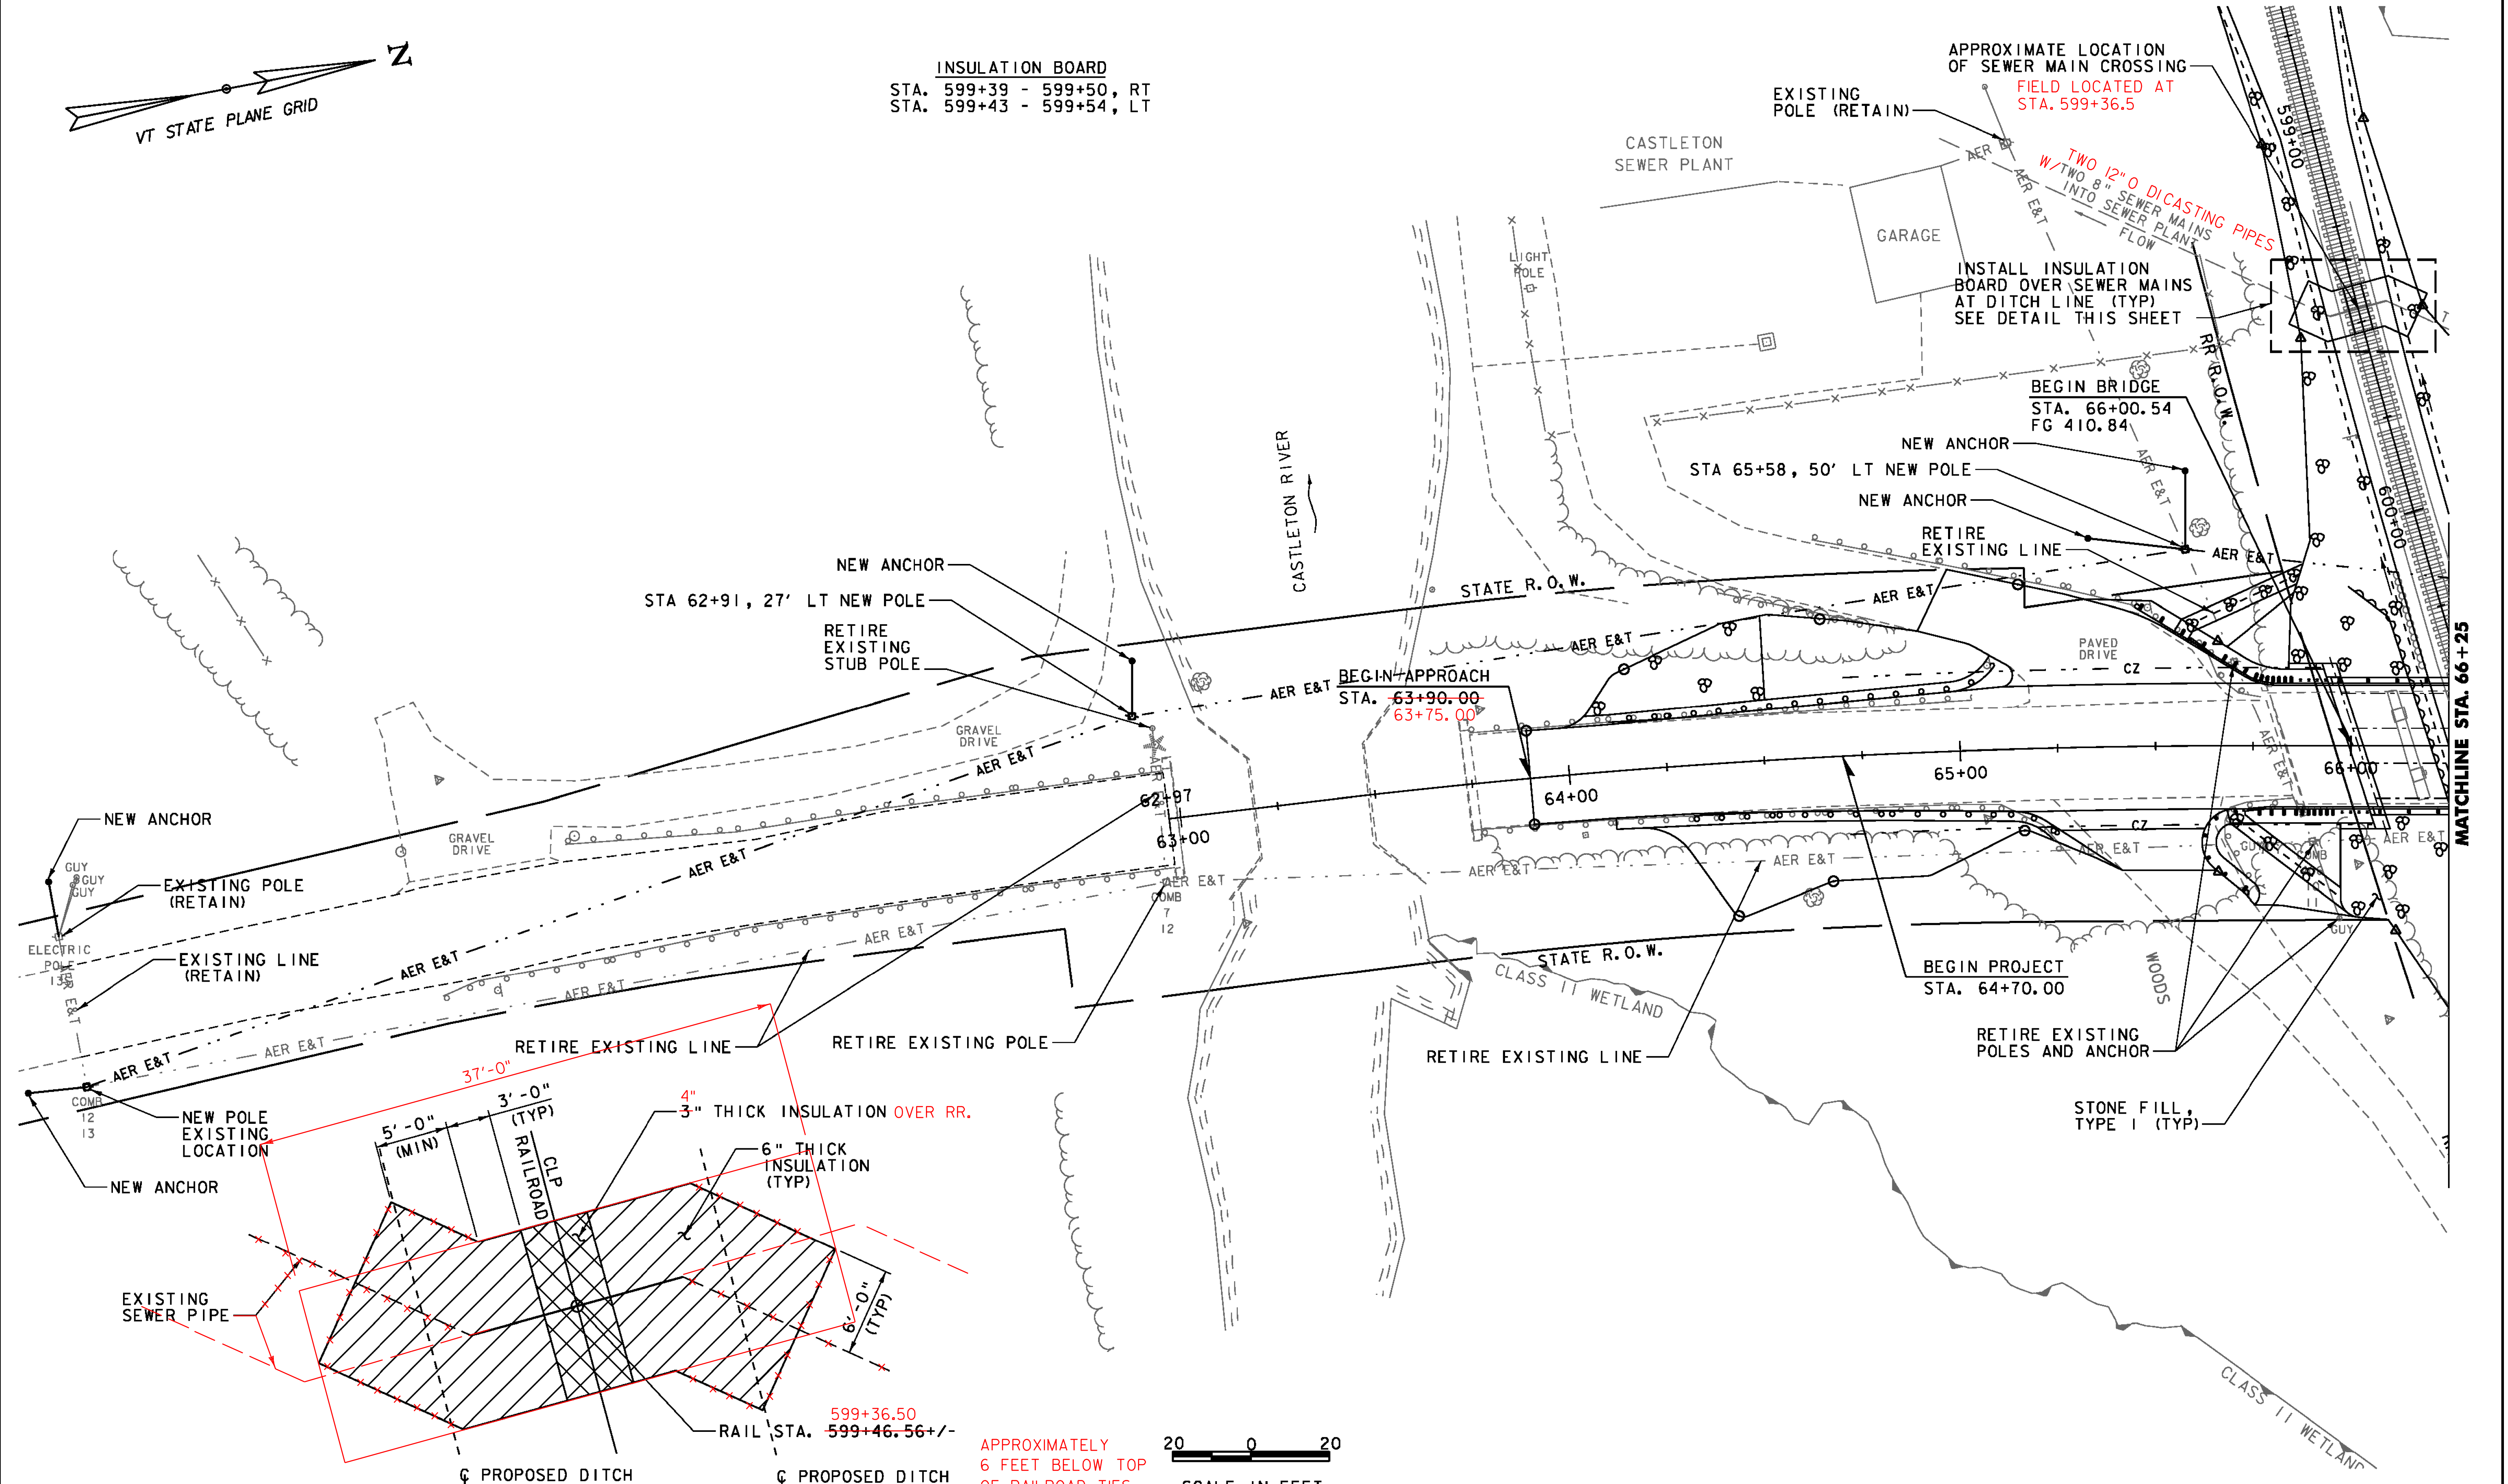

NOTE:
 1. STAGGER INSULATION JOINTS TO PROVIDE OVERLAPPING LAYERS.
 2. INSULATION BOARD SHALL HAVE A MINIMUM COMPRESSIVE STRENGTH OF 60 PSI AND BE IN ACCORDANCE WITH ASTM D1621.

INSULATION BOARD DETAIL
 SCALE 3/16" = 1'-0"

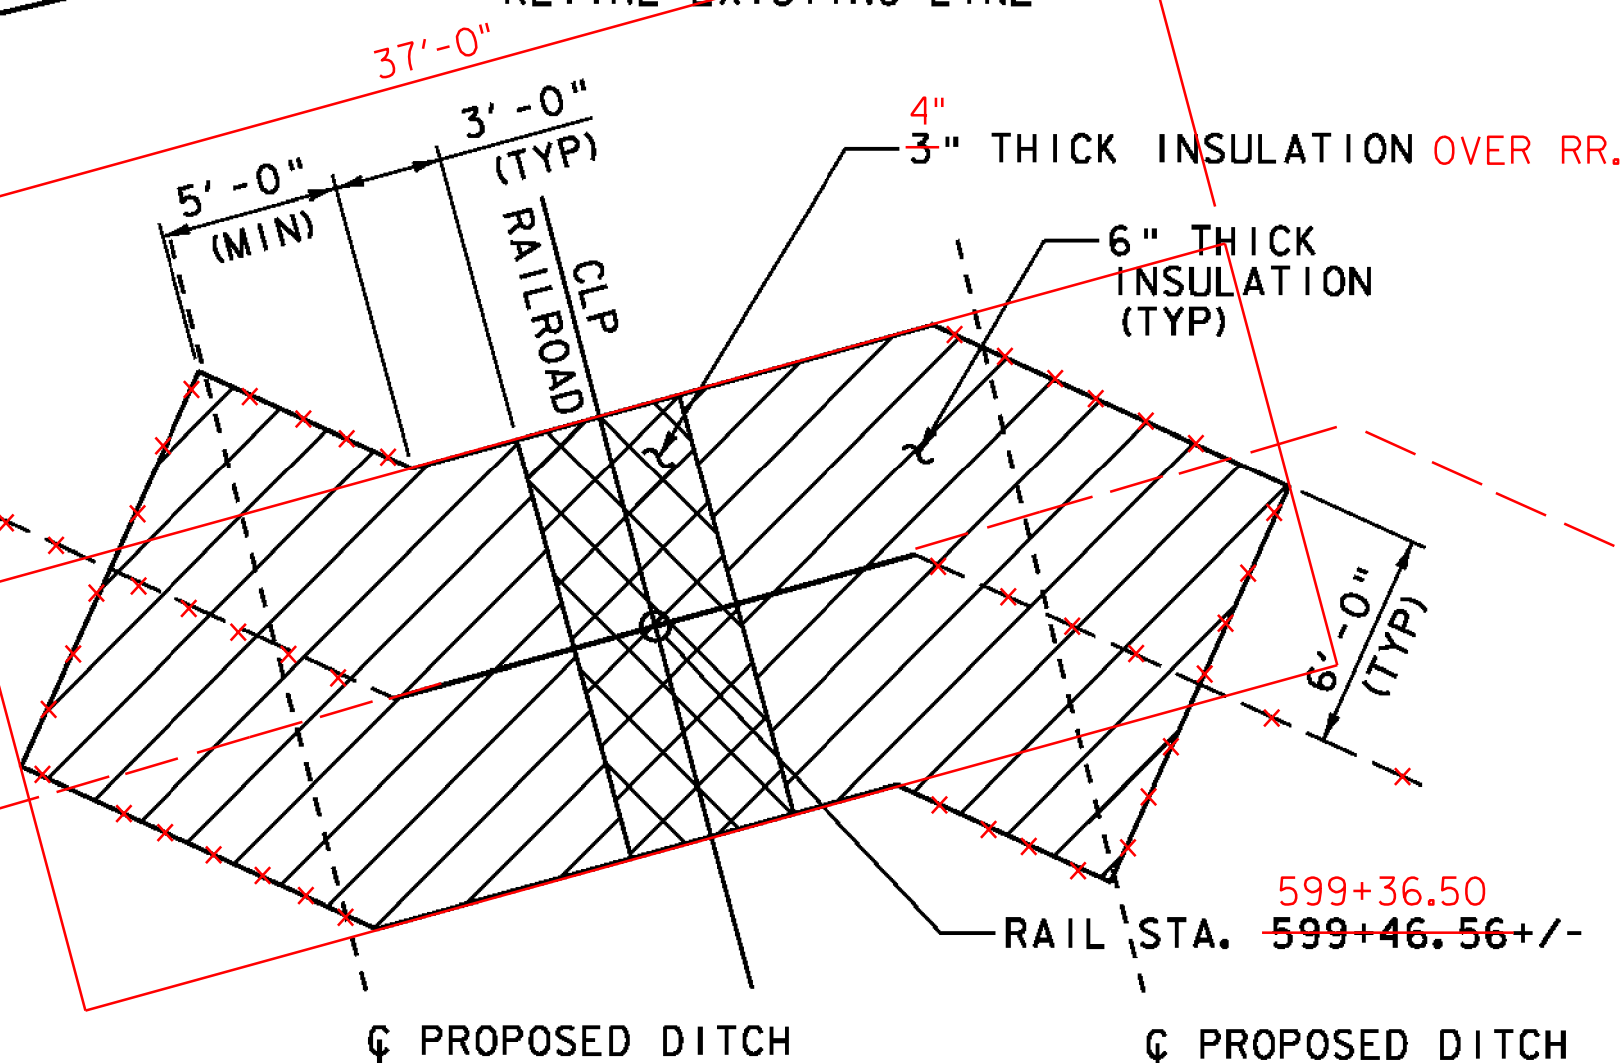

APPROXIMATELY 6 FEET BELOW TOP OF RAILROAD TIES
 ELEVATION 383.83 AT 12'3" LT
 SCALE IN FEET

PROJECT NAME: CASTLETON	PLOT DATE: 9/21/2014
PROJECT NUMBER: BRF 015-2(10)	DRAWN BY: E.A. FIALA
FILE NAME: z12b138bdr_util11ty.dgn	CHECKED BY: S.E. BURBANK
PROJECT LEADER: S.E. BURBANK	SHEET 31 OF 82
DESIGNED BY: E.A. FIALA	UTILITY LAYOUT SHEET (1 OF 2)

