



CHANGING ELEVATION  
OF SEWER MANHOLES  
STA. 67+53, LT

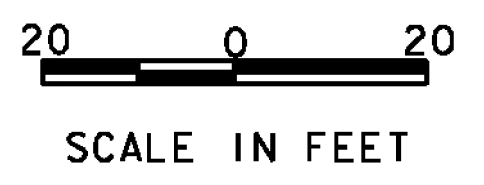

PROJECT NAME: CASTLETON	PLOT DATE: 9/21/2014
PROJECT NUMBER: BRF 015-2(10)	DRAWN BY: E.A. FIALA
FILE NAME: z12b138bdr_utility.dgn	CHECKED BY: S.E. BURBANK
PROJECT LEADER: S.E. BURBANK	SHEET 32 OF 82
DESIGNED BY: E.A. FIALA	
UTILITY LAYOUT SHEET (2 OF 2)	

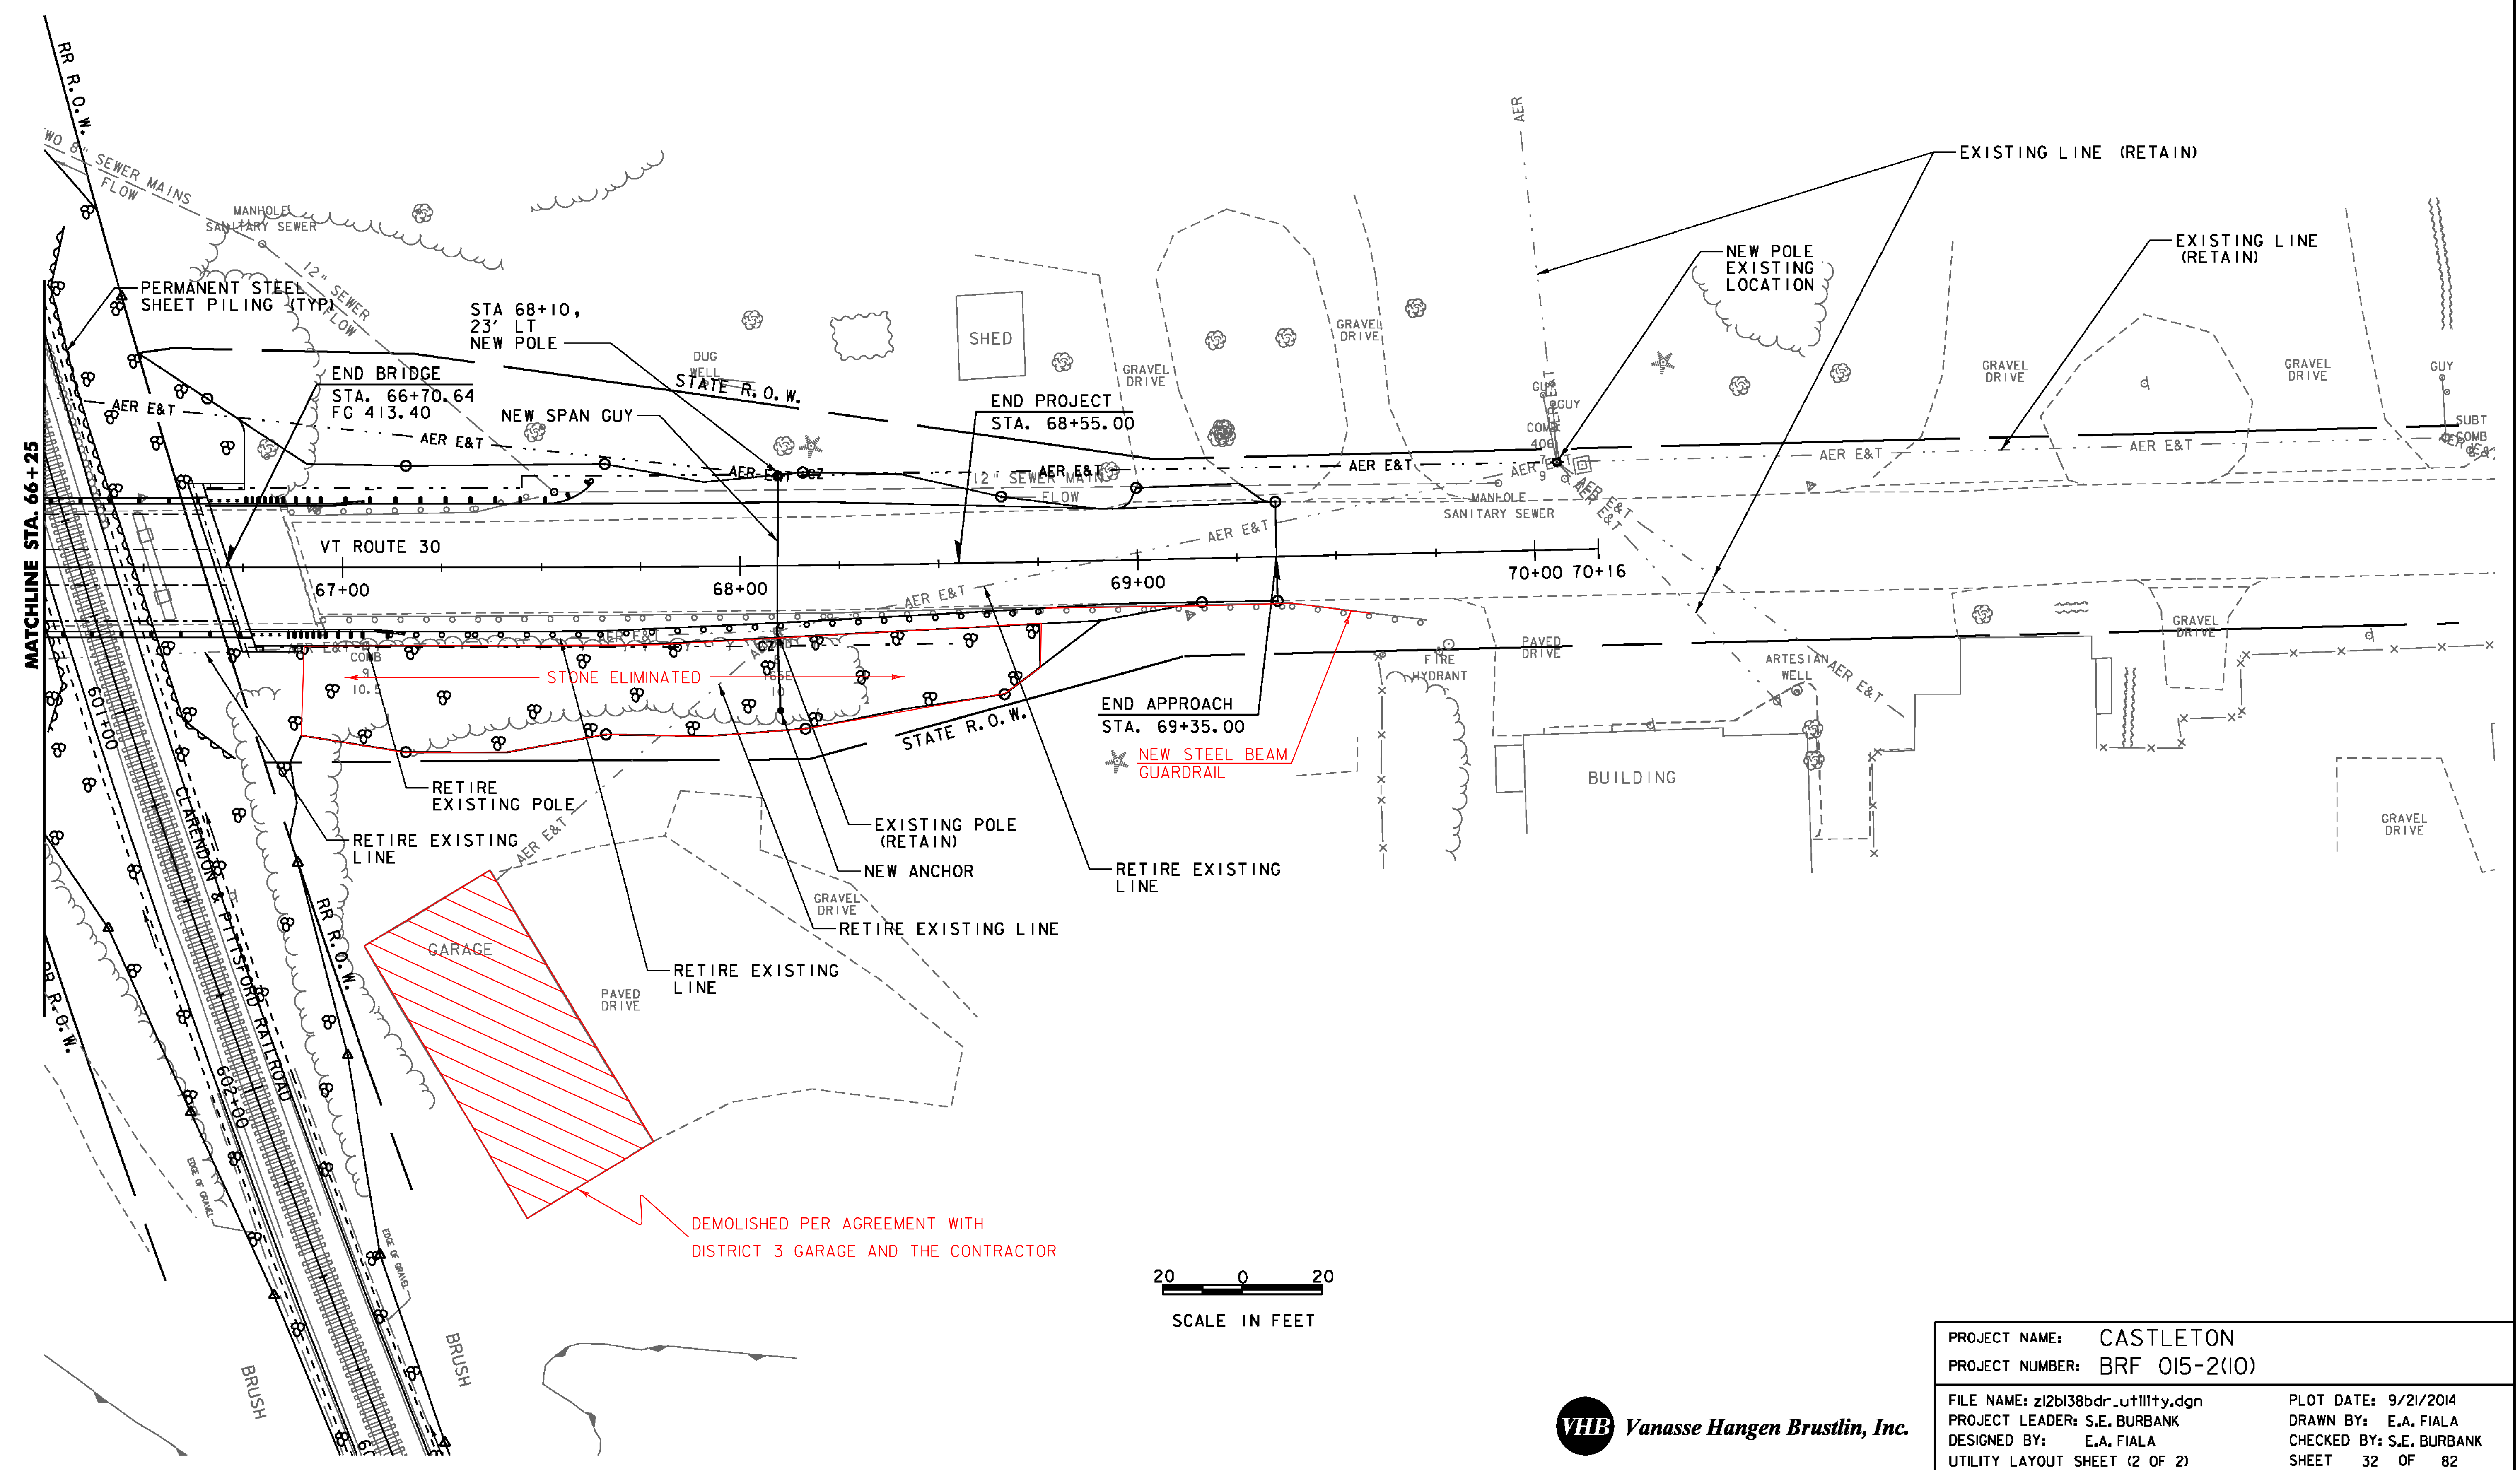