


4 INCH YELLOW LINE  
 STA. 63+90 - 69+35, LT & RT  
 4 INCH WHITE LINE  
 STA. 63+90 - 69+35, LT & RT  
 TRAFFIC SIGNS, TYPE A  
 STA. 64+16, RT  
 STA. 65+95, RT  
 STA. 66+76, LT  
 STA. 68+65, LT

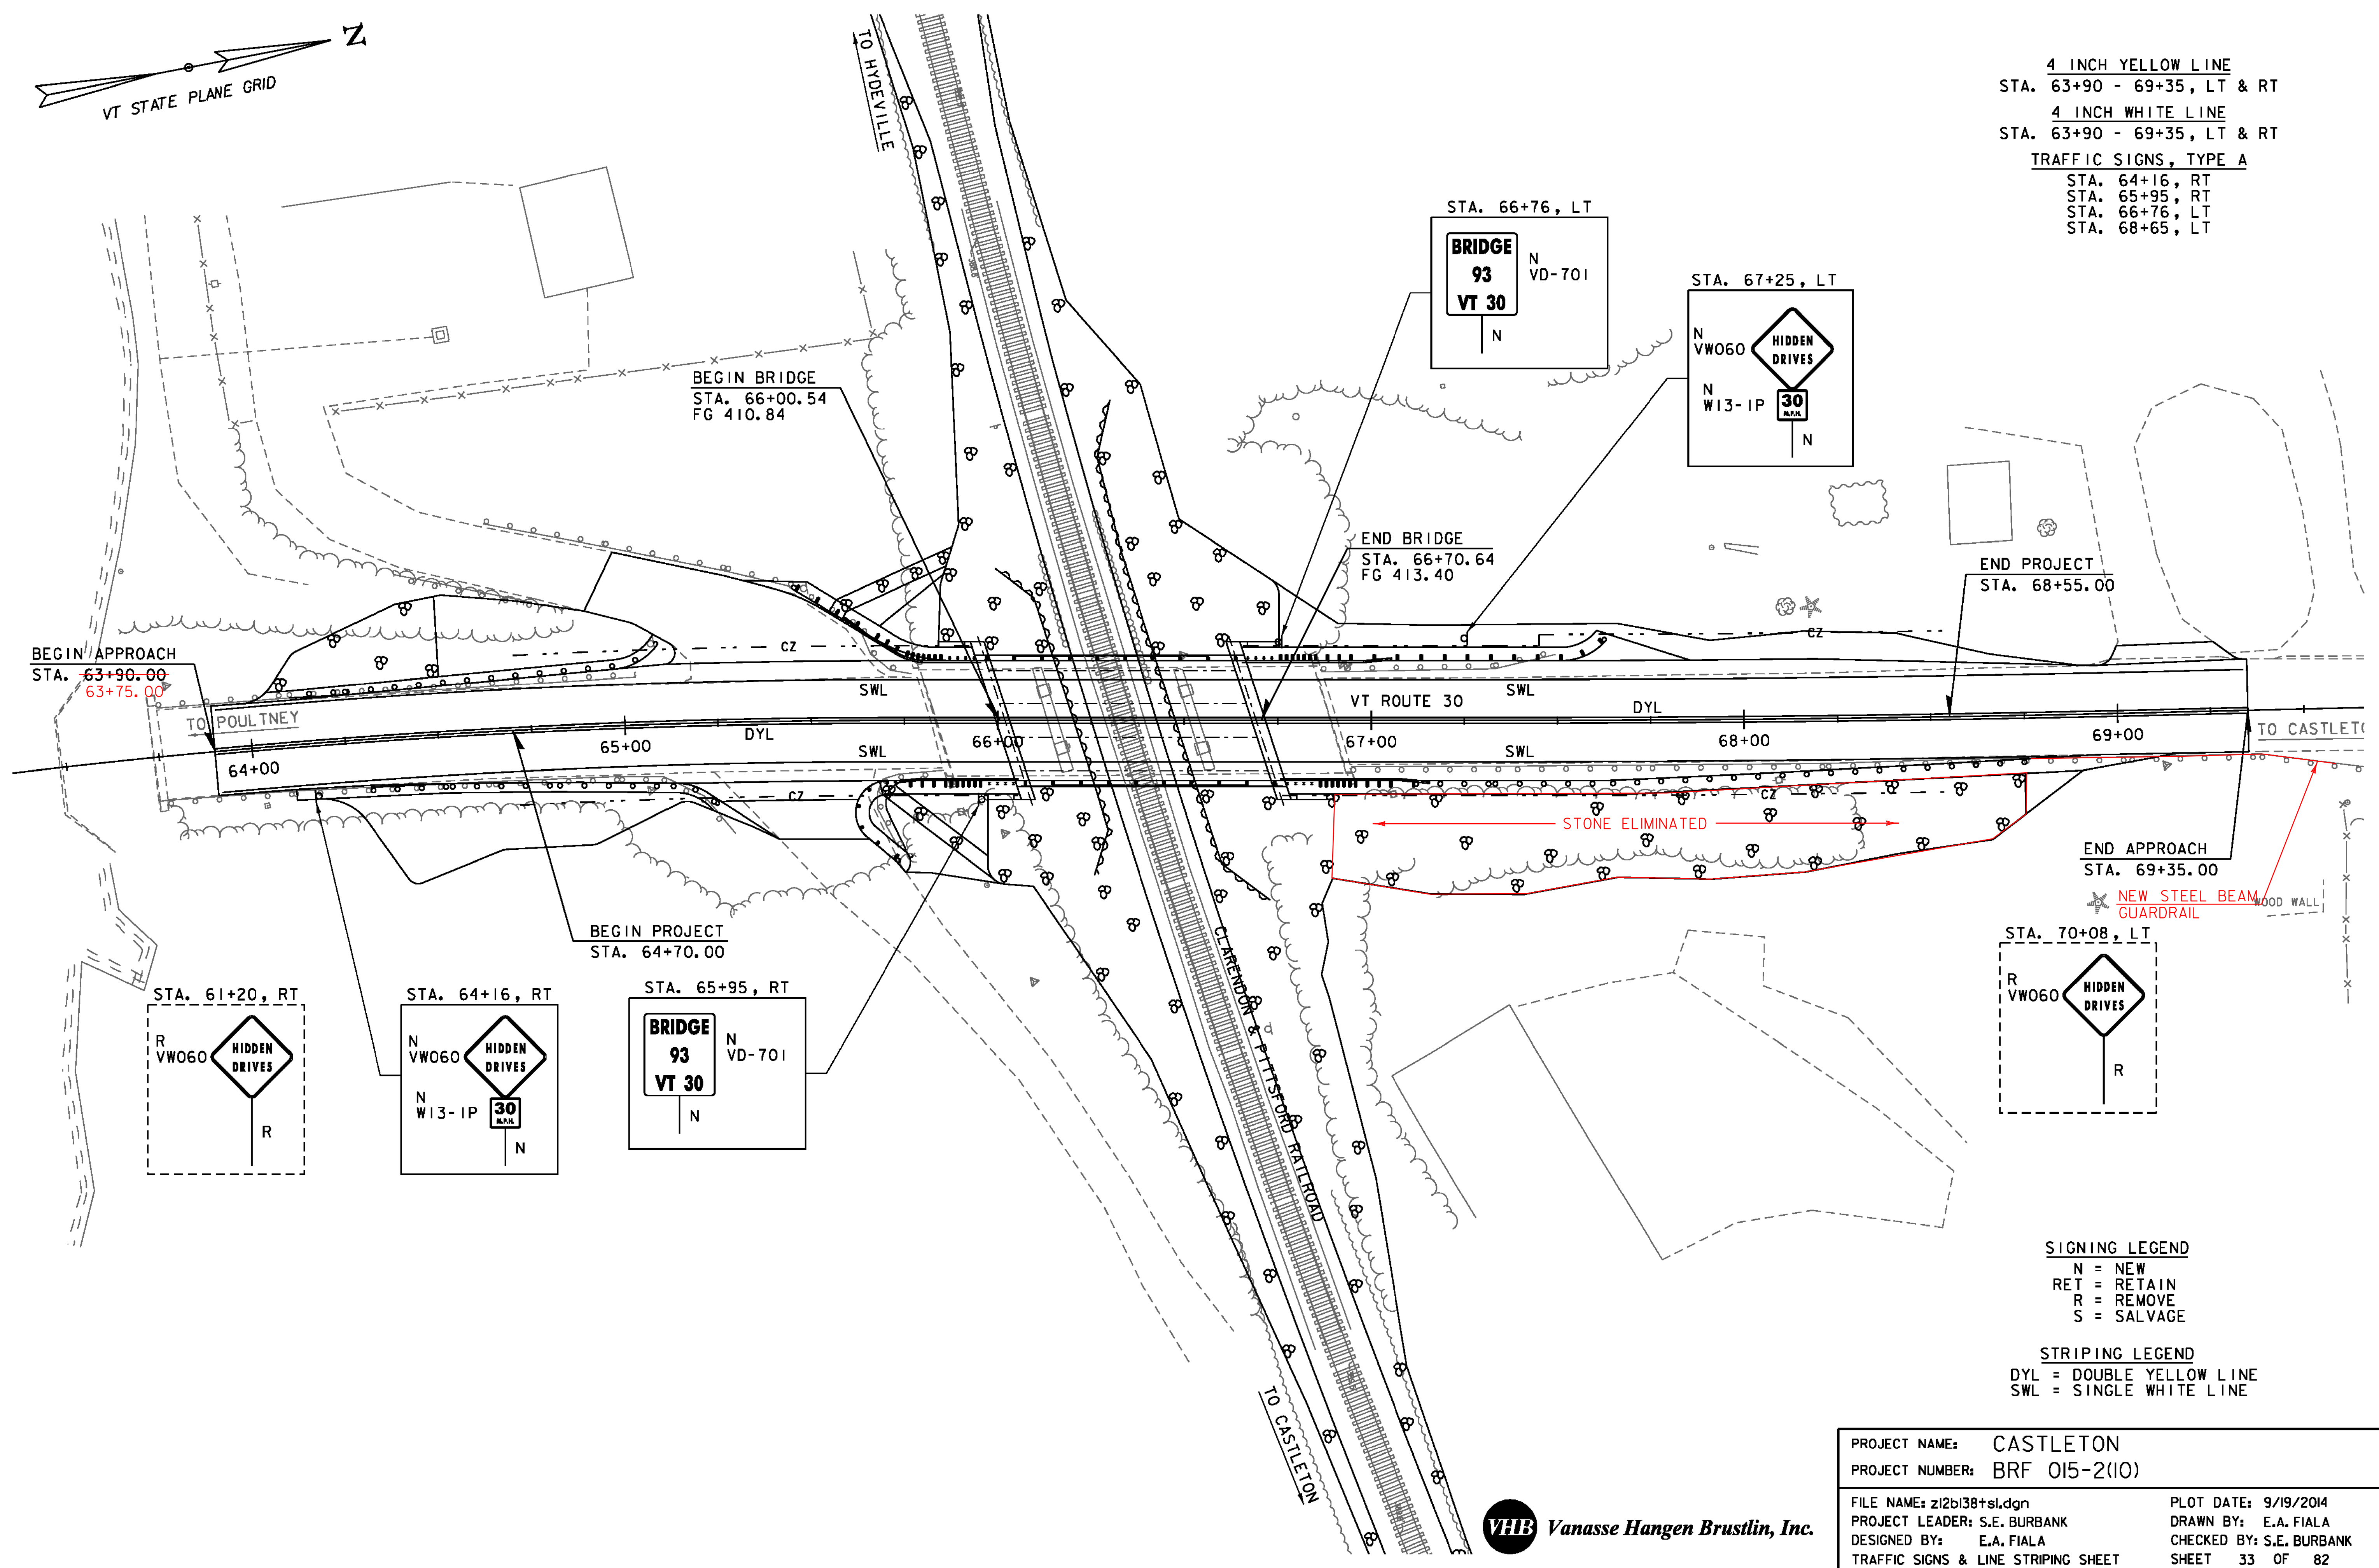

**SIGNING LEGEND**  
 N = NEW  
 RET = RETAIN  
 R = REMOVE  
 S = SALVAGE

**STRIPING LEGEND**  
 DYL = DOUBLE YELLOW LINE  
 SWL = SINGLE WHITE LINE

PROJECT NAME: CASTLETON	FILE NAME: z12b138+sl.dgn	PLOT DATE: 9/19/2014
PROJECT NUMBER: BRF 015-2(10)	PROJECT LEADER: S.E. BURBANK	DRAWN BY: E.A. FIALA
	DESIGNED BY: E.A. FIALA	CHECKED BY: S.E. BURBANK
	TRAFFIC SIGNS & LINE STRIPING SHEET	SHEET 33 OF 82

