


PLAN
 SCALE 1" = 10'-0"



PROJECT NAME: CASTLETON	PLOT DATE: 9/21/2014
PROJECT NUMBER: BRF 015-2(10)	DRAWN BY: E.A. FIALA
FILE NAME: z12b138pe.dgn	CHECKED BY: S.E. BURBANK
PROJECT LEADER: S.E. BURBANK	SHEET 40 OF 82
DESIGNED BY: E.A. FIALA	
PLAN AND ELEVATION	

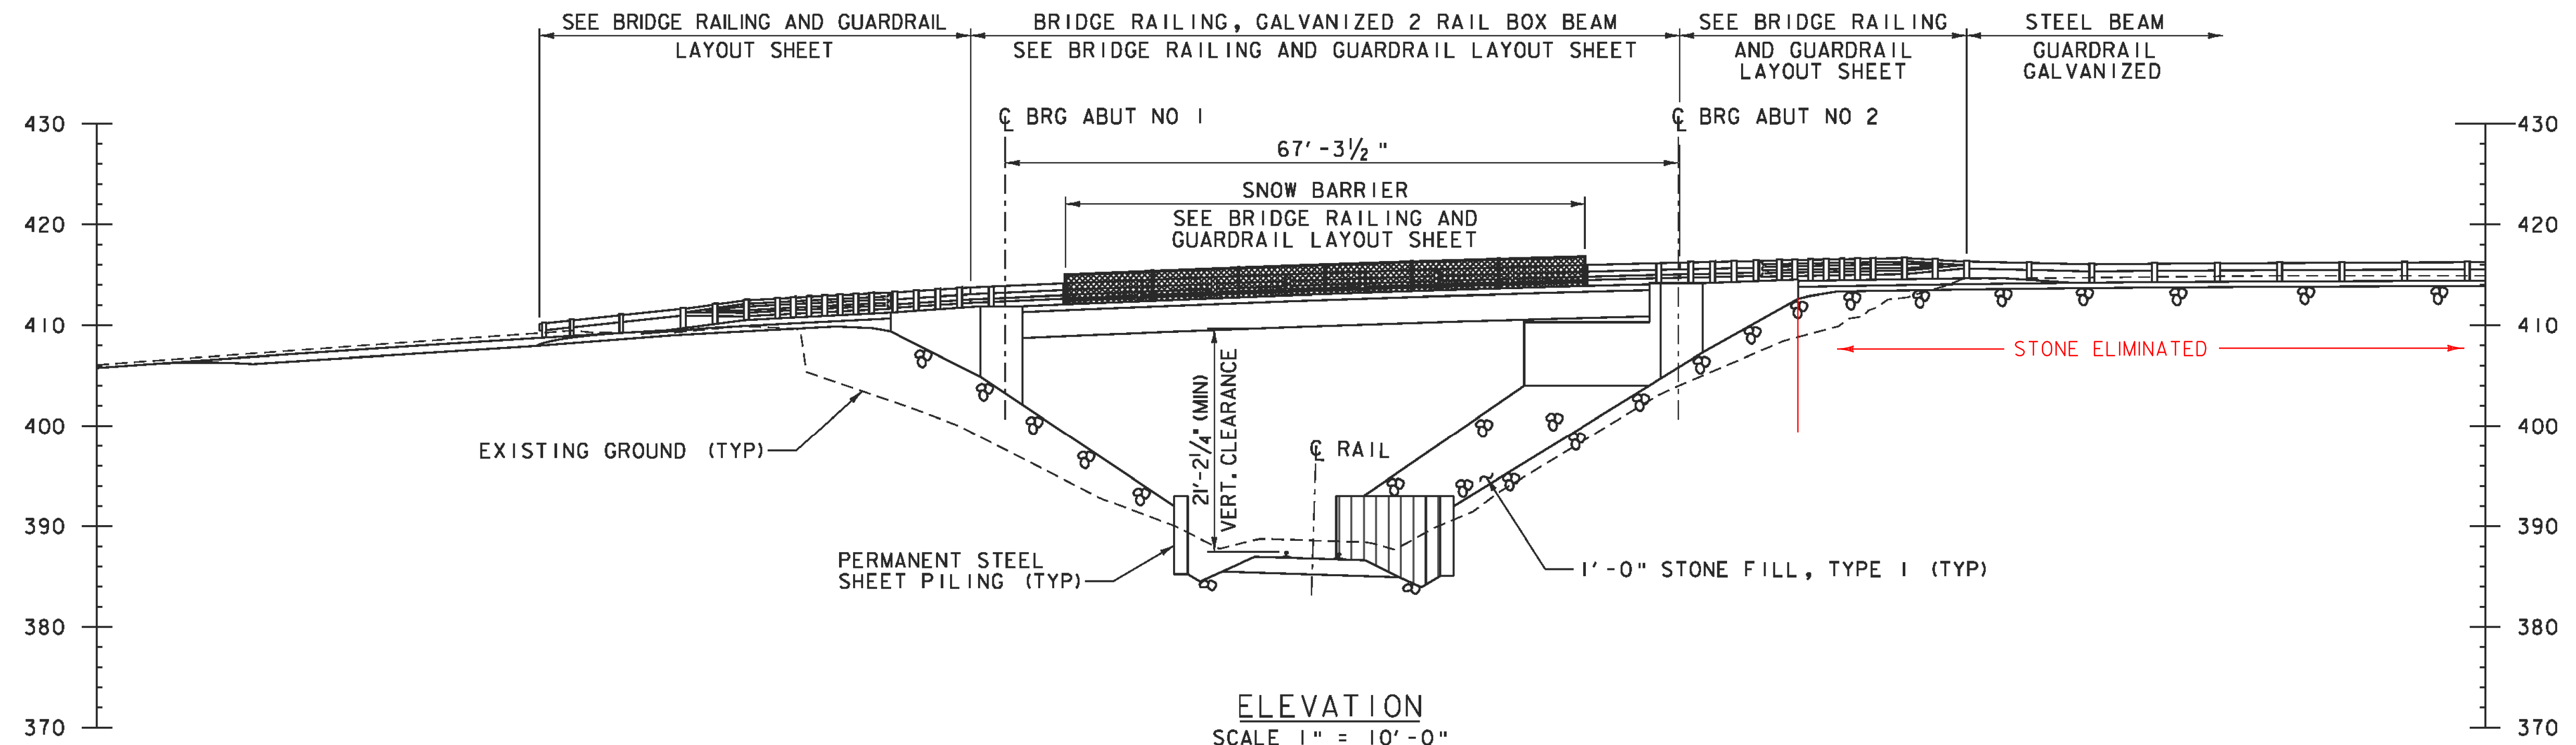