


ABUTMENT NO. 2 PLAN  
SCALE 1/2" = 1'-0"

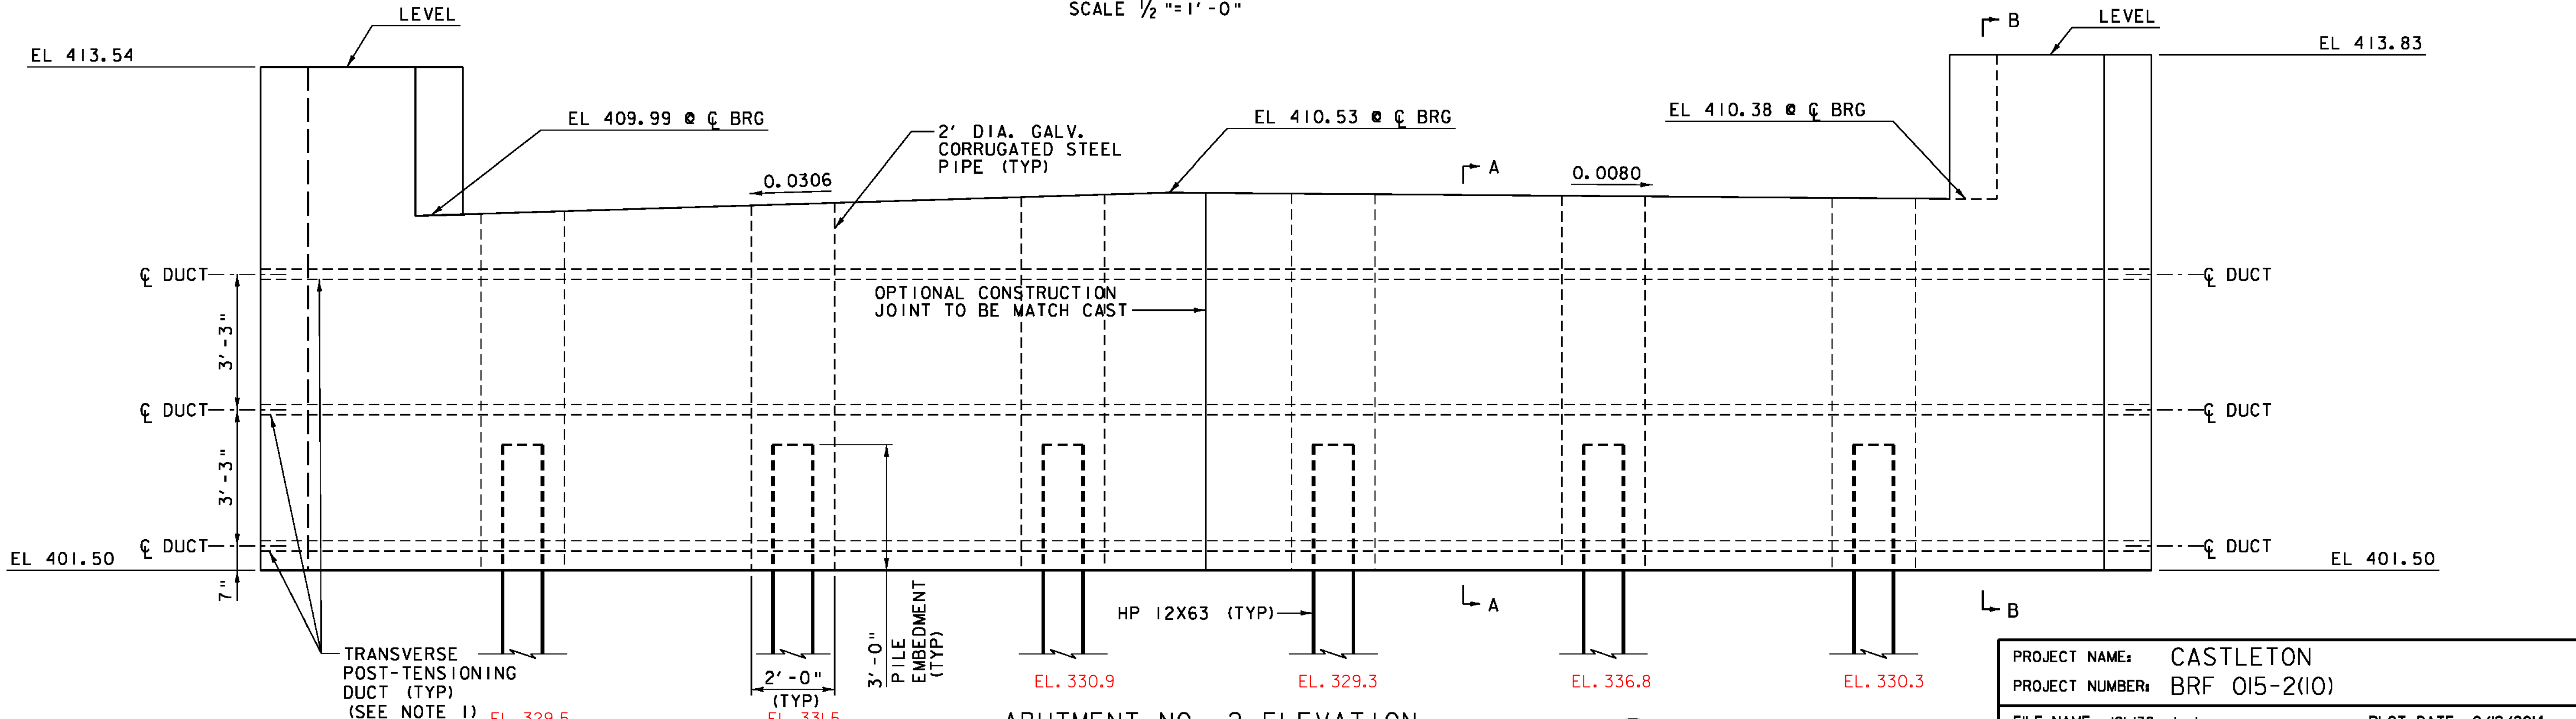

ABUTMENT NO. 2 ELEVATION  
SCALE 1/2" = 1'-0"

SEE ABUTMENT SECTIONS SHEET FOR SECTIONS A-A AND B-B.



PROJECT NAME: CASTLETON	PLOT DATE: 9/19/2014
PROJECT NUMBER: BRF 015-2(10)	DRAWN BY: M.C. SCOTT
FILE NAME: z12b138sub.dgn	CHECKED BY: S.E. BURBANK
PROJECT LEADER: S.E. BURBANK	SHEET 48 OF 82
DESIGNED BY: E.A. FIALA	
ABUTMENT NO 2 PLAN & ELEVATION	