


COMMON EXCAVATION = 15.45 SF
SUBBASE OF CRUSHED GRAVEL = 44.67 SF

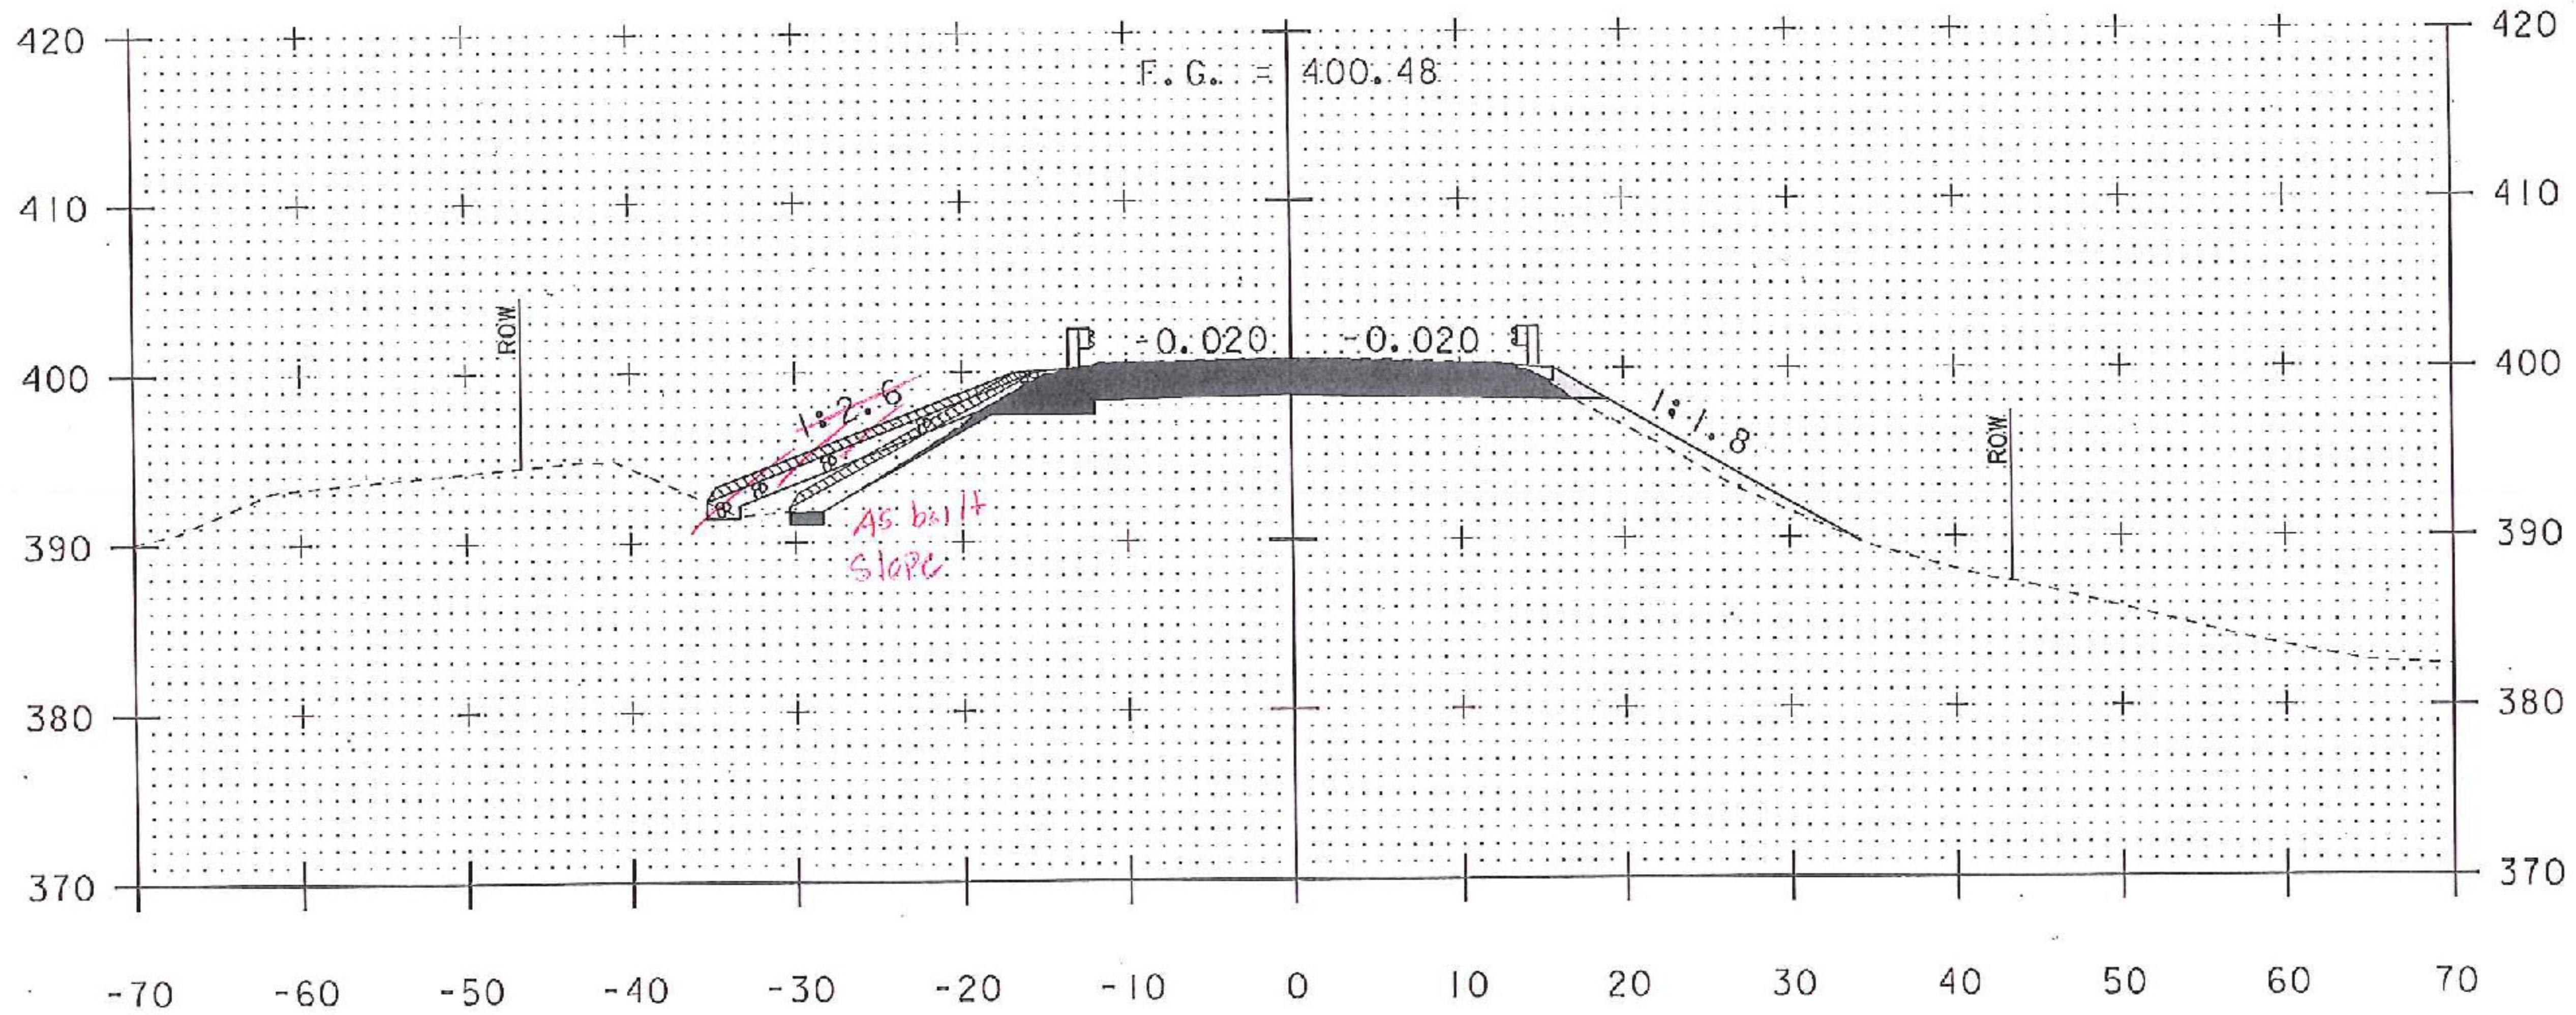

COMMON EXCAVATION = 15.45 SF

64+50