


COMMON EXCAVATION = 128.65 SF  
SUBBASE OF CRUSHED GRAVEL = 77.83 SF  
SAND BORROW = 27.48 SF

65+00

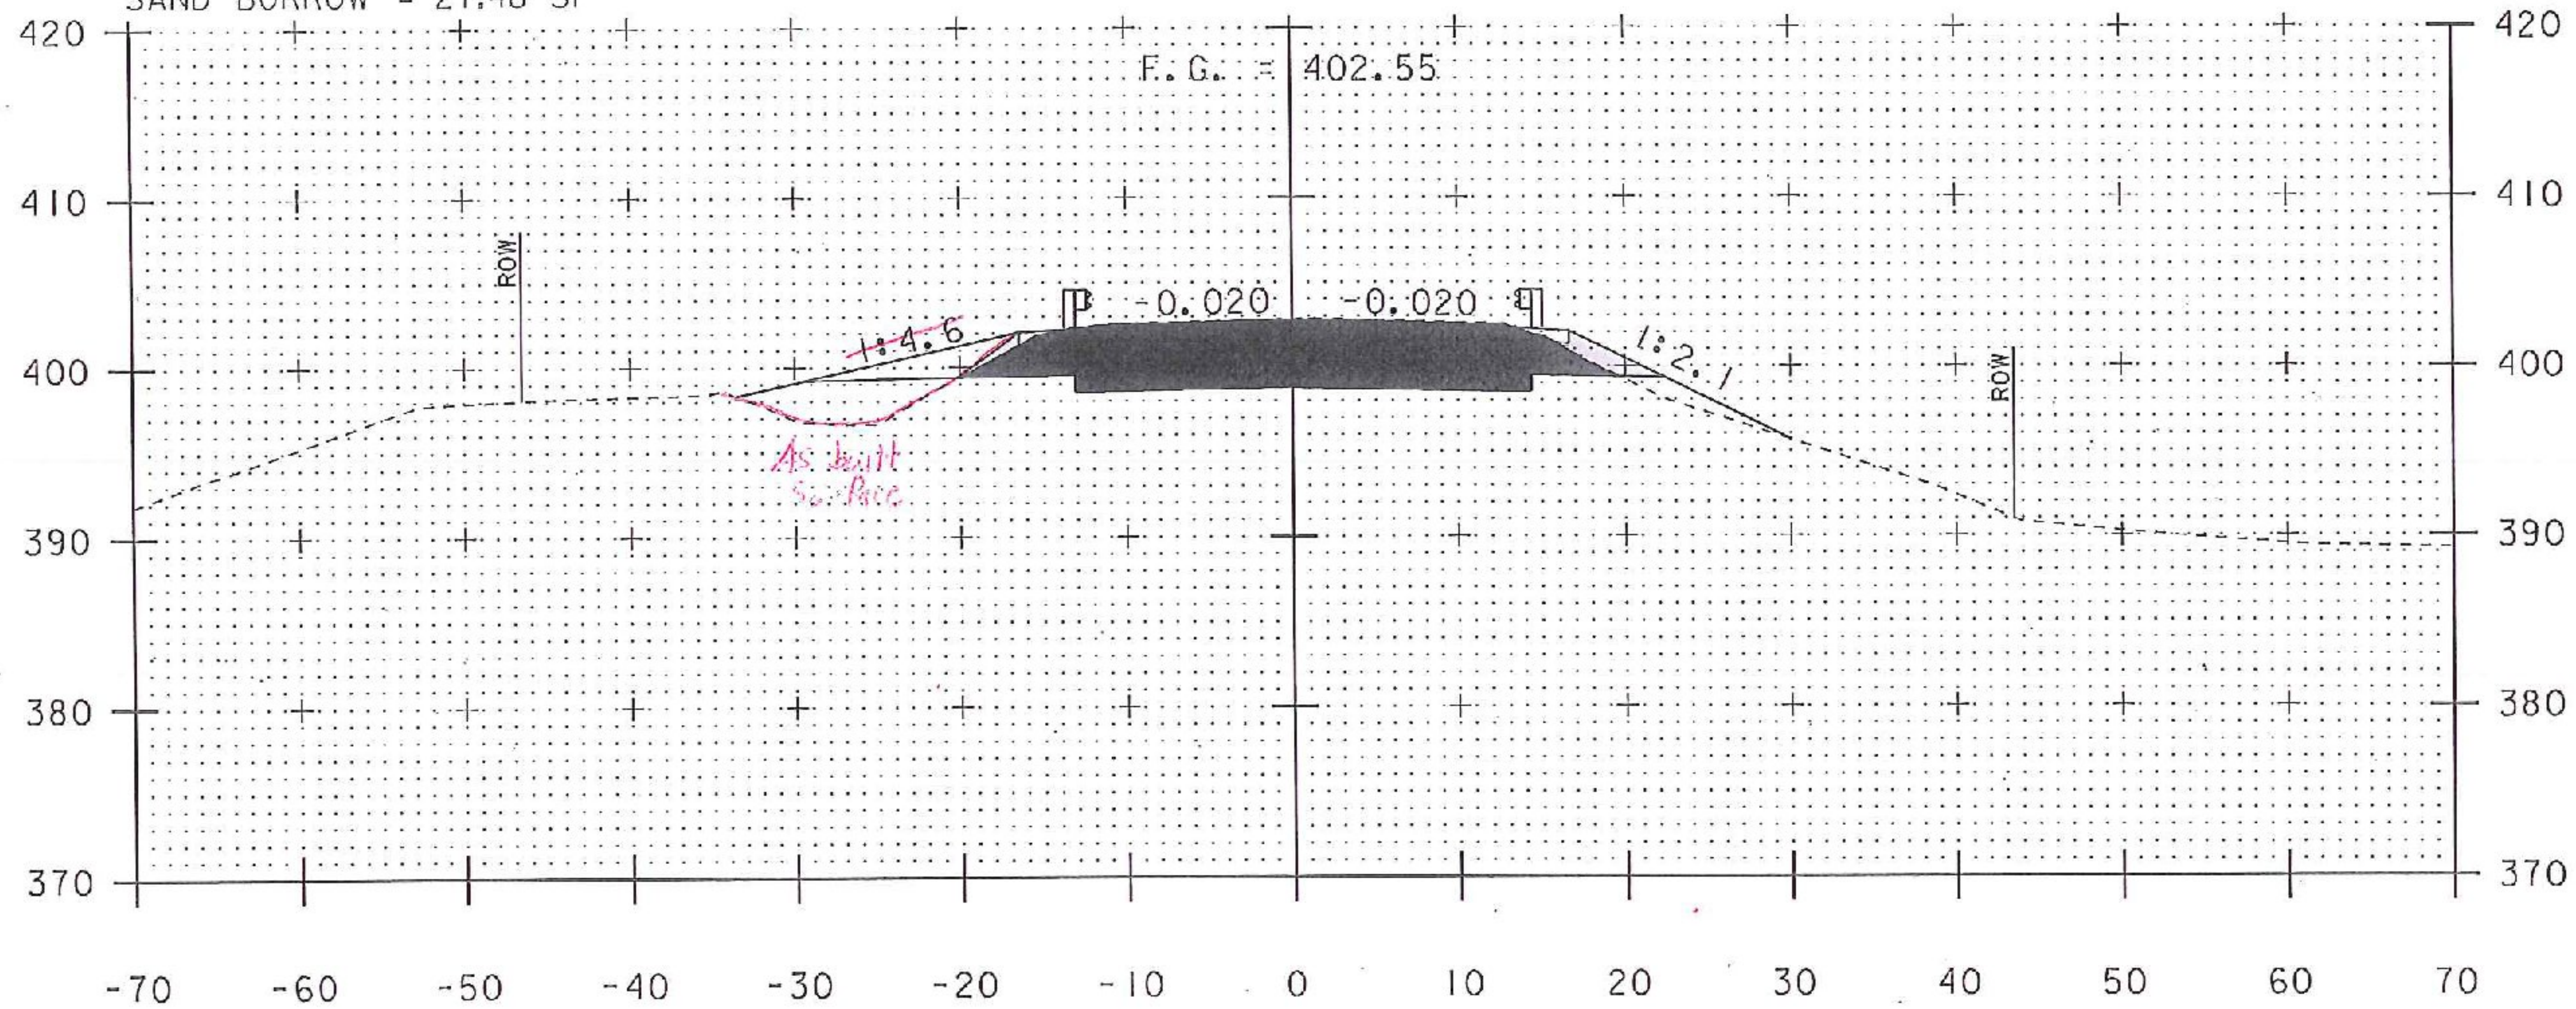

STA. 64+51, LT  
END GEOTEXTILE UNDER STONE FILL  
STONE FILL, TYPE I  
GRUBBING MATERIAL

64+75  
BEGIN PROJECT