


COMMON EXCAVATION = 140.06 SF  
SUBBASE OF CRUSHED GRAVEL = 84.48 SF  
SAND BORROW = 28.20 SF

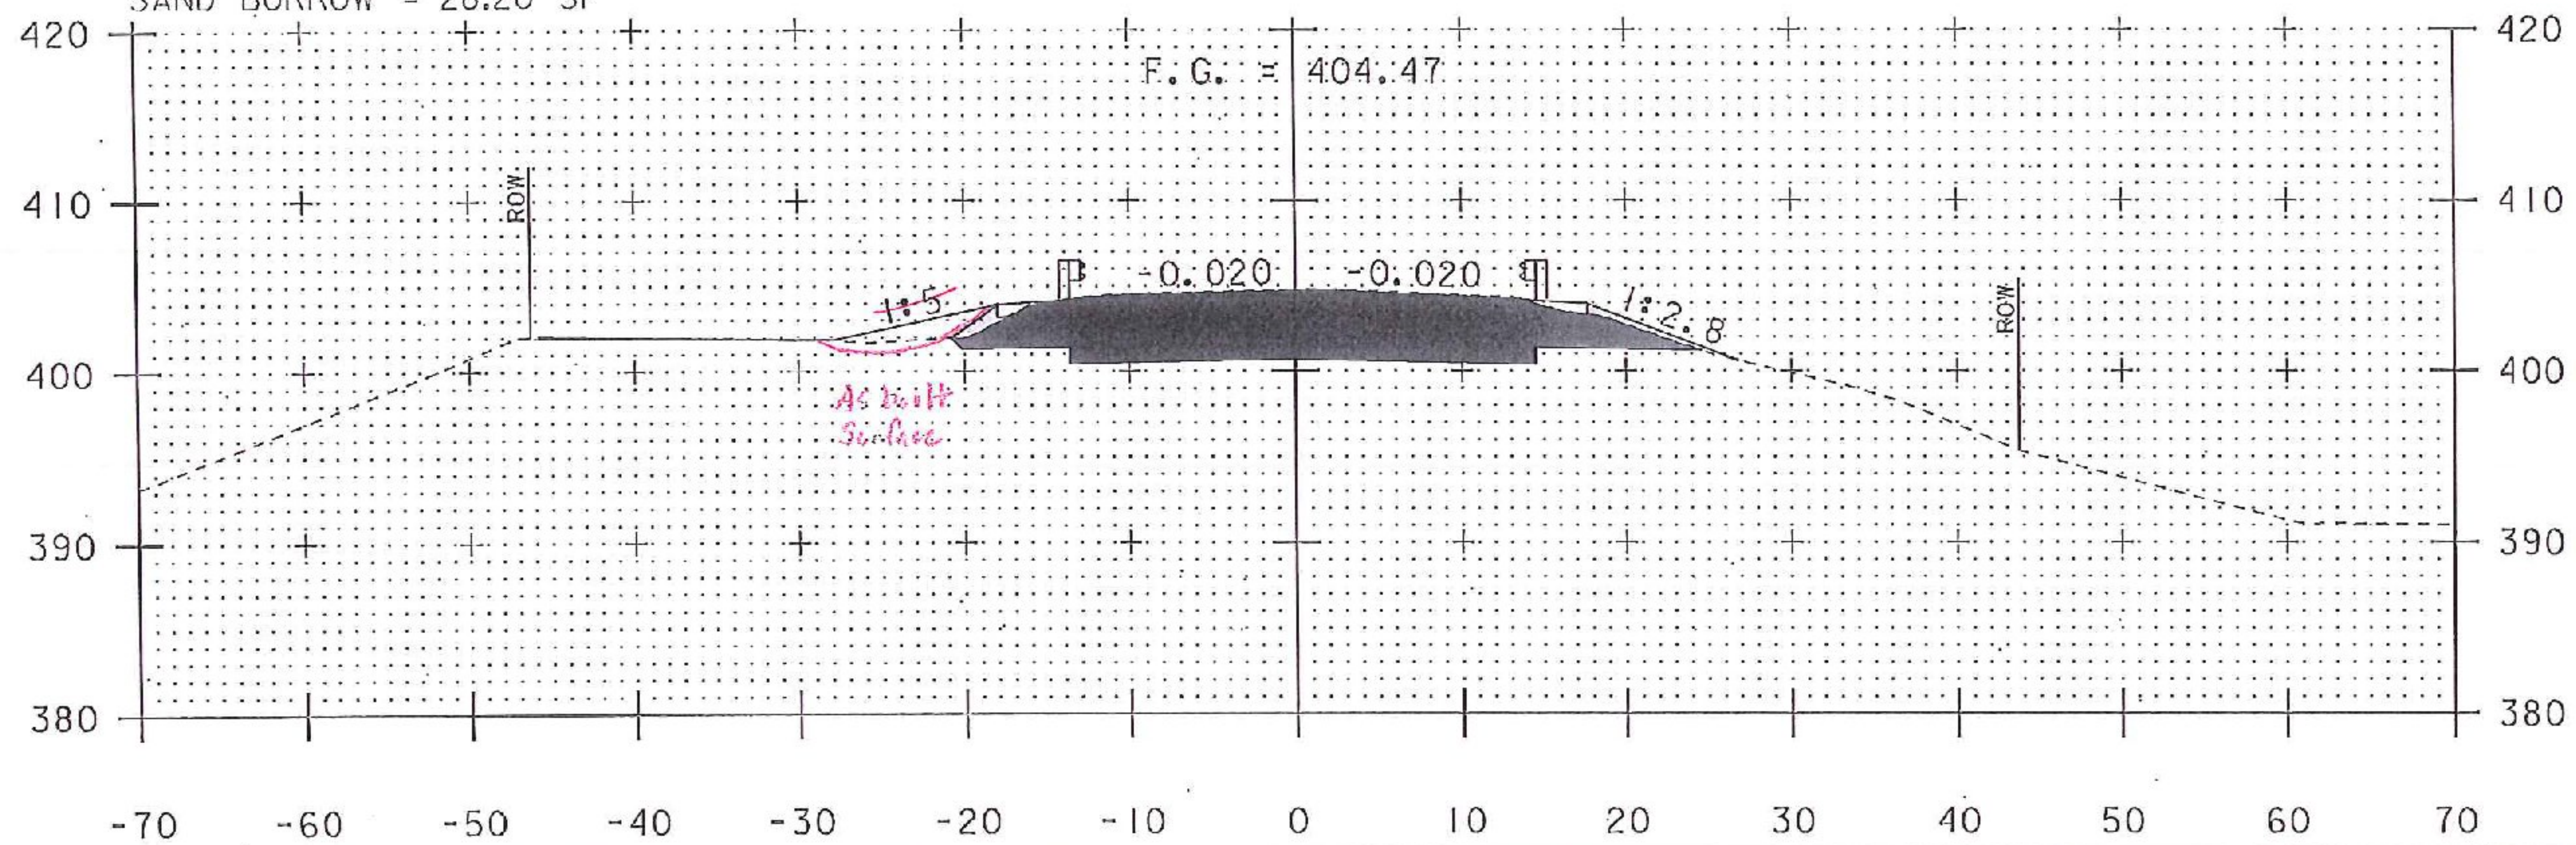

COMMON EXCAVATION = 128.65 SF  
SUBBASE OF CRUSHED GRAVEL = 77.83 SF  
SAND BORROW = 27.48 SF

65+00