




595+50

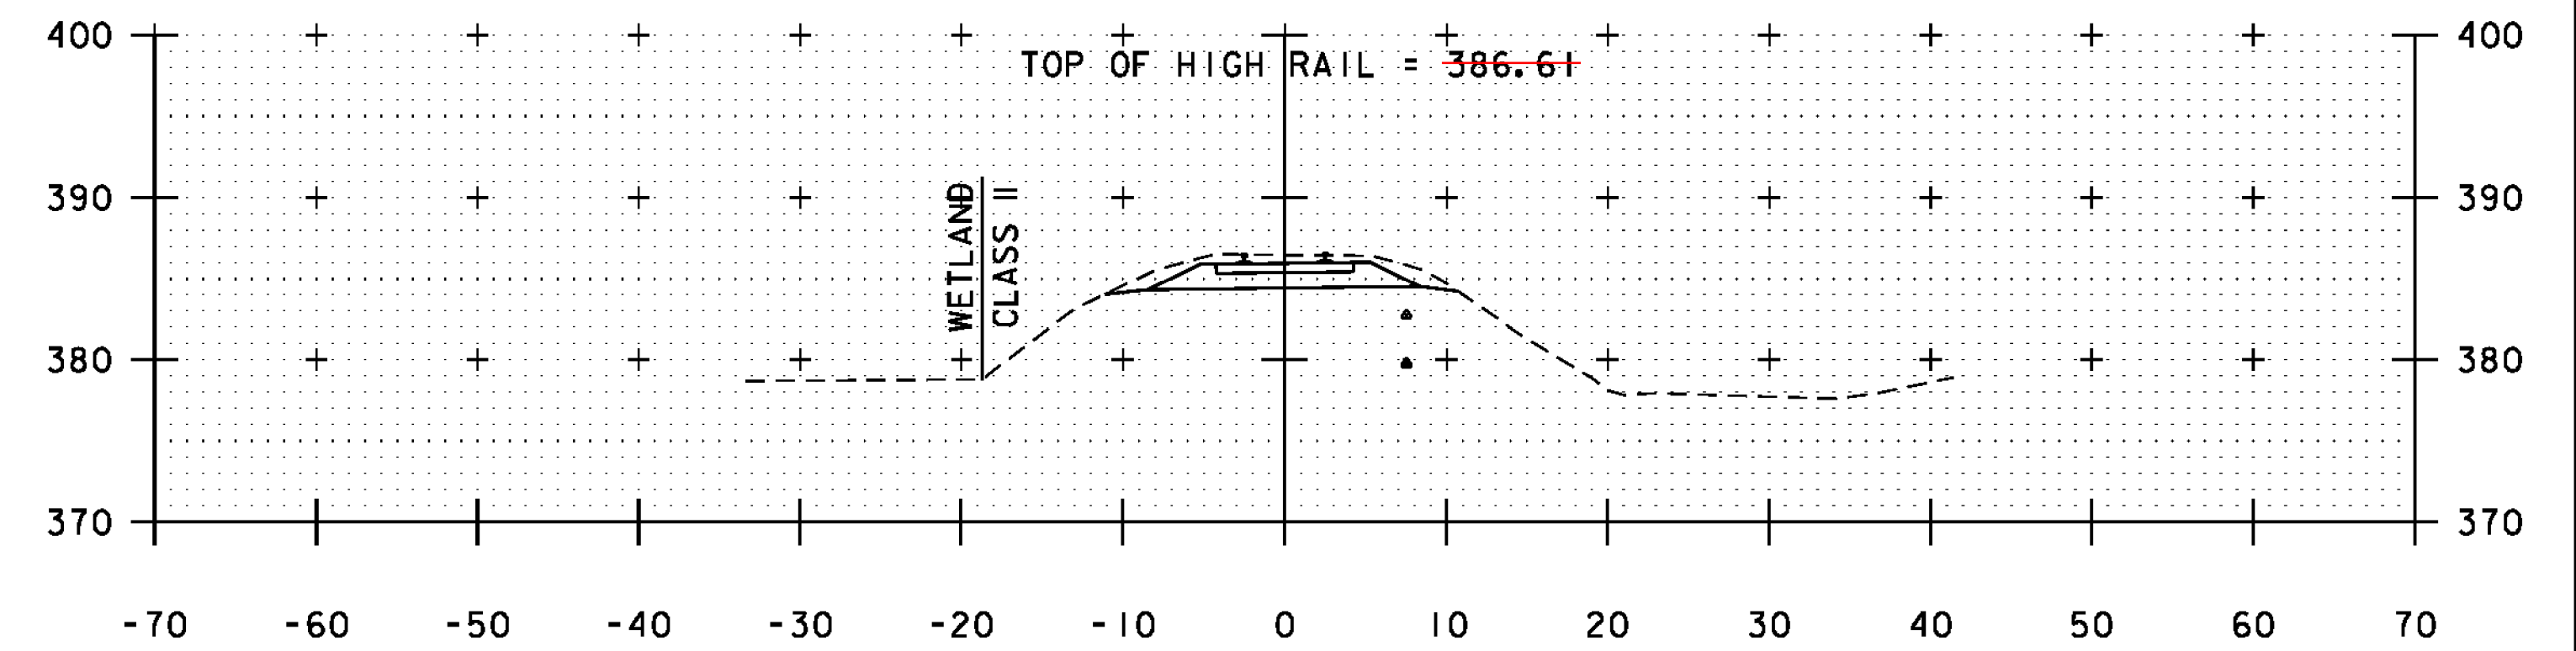


597+00

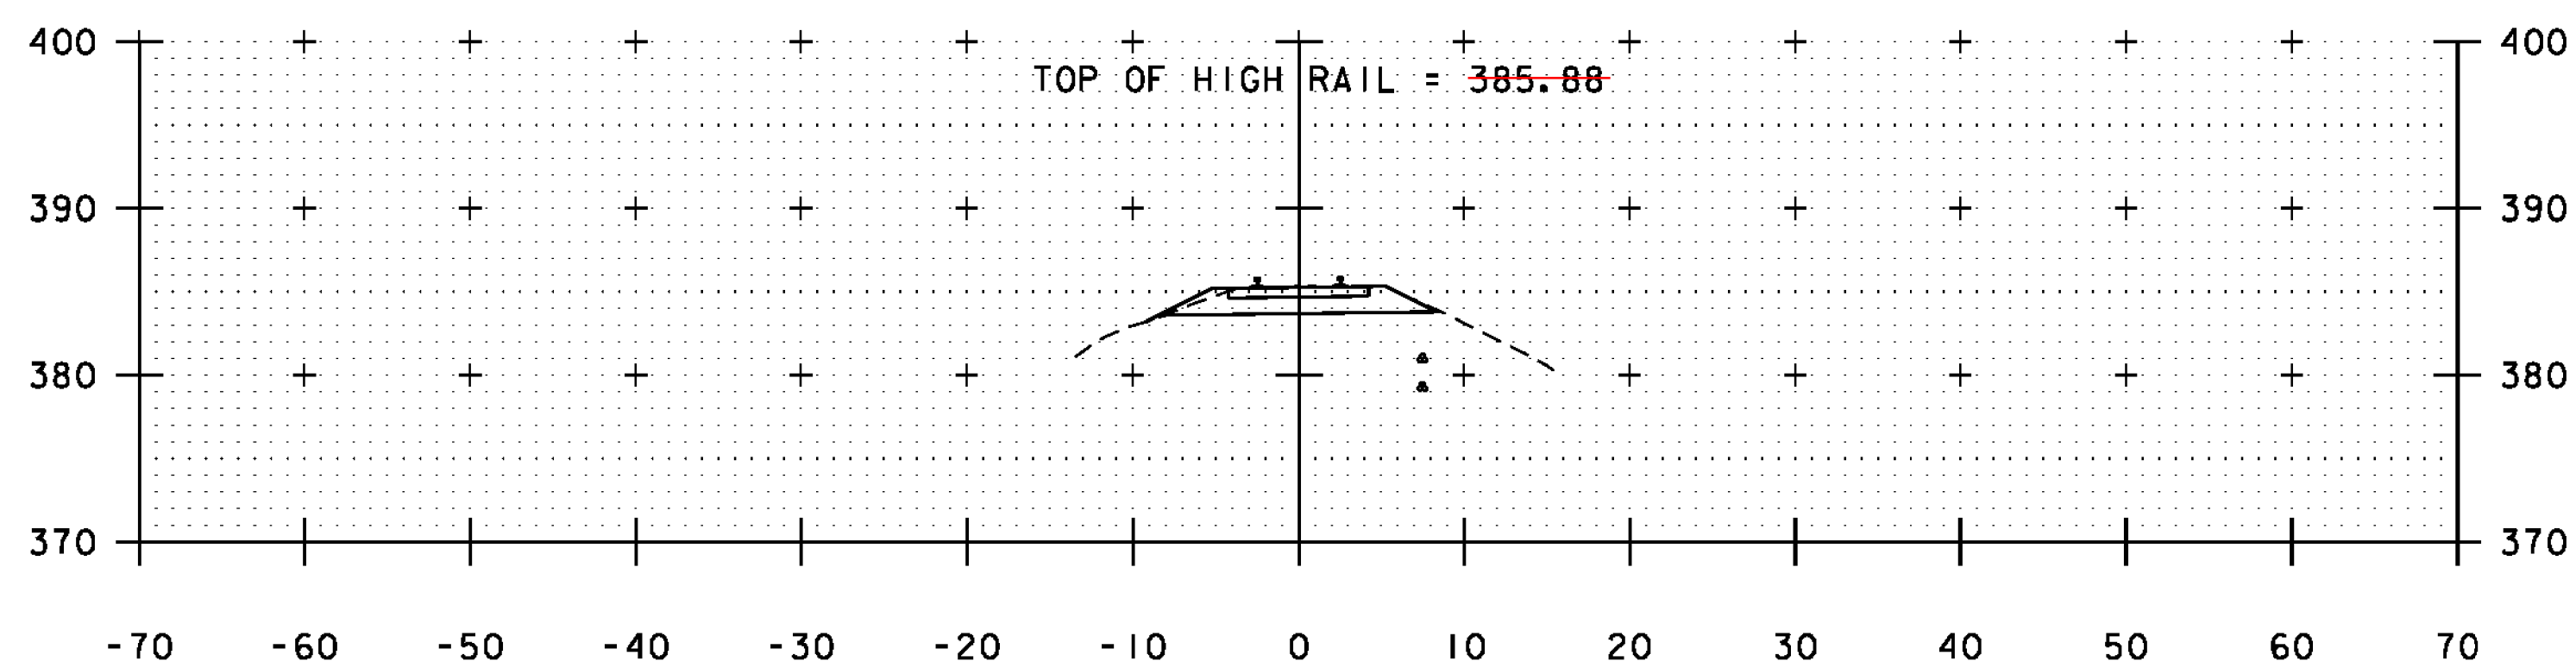


595+00

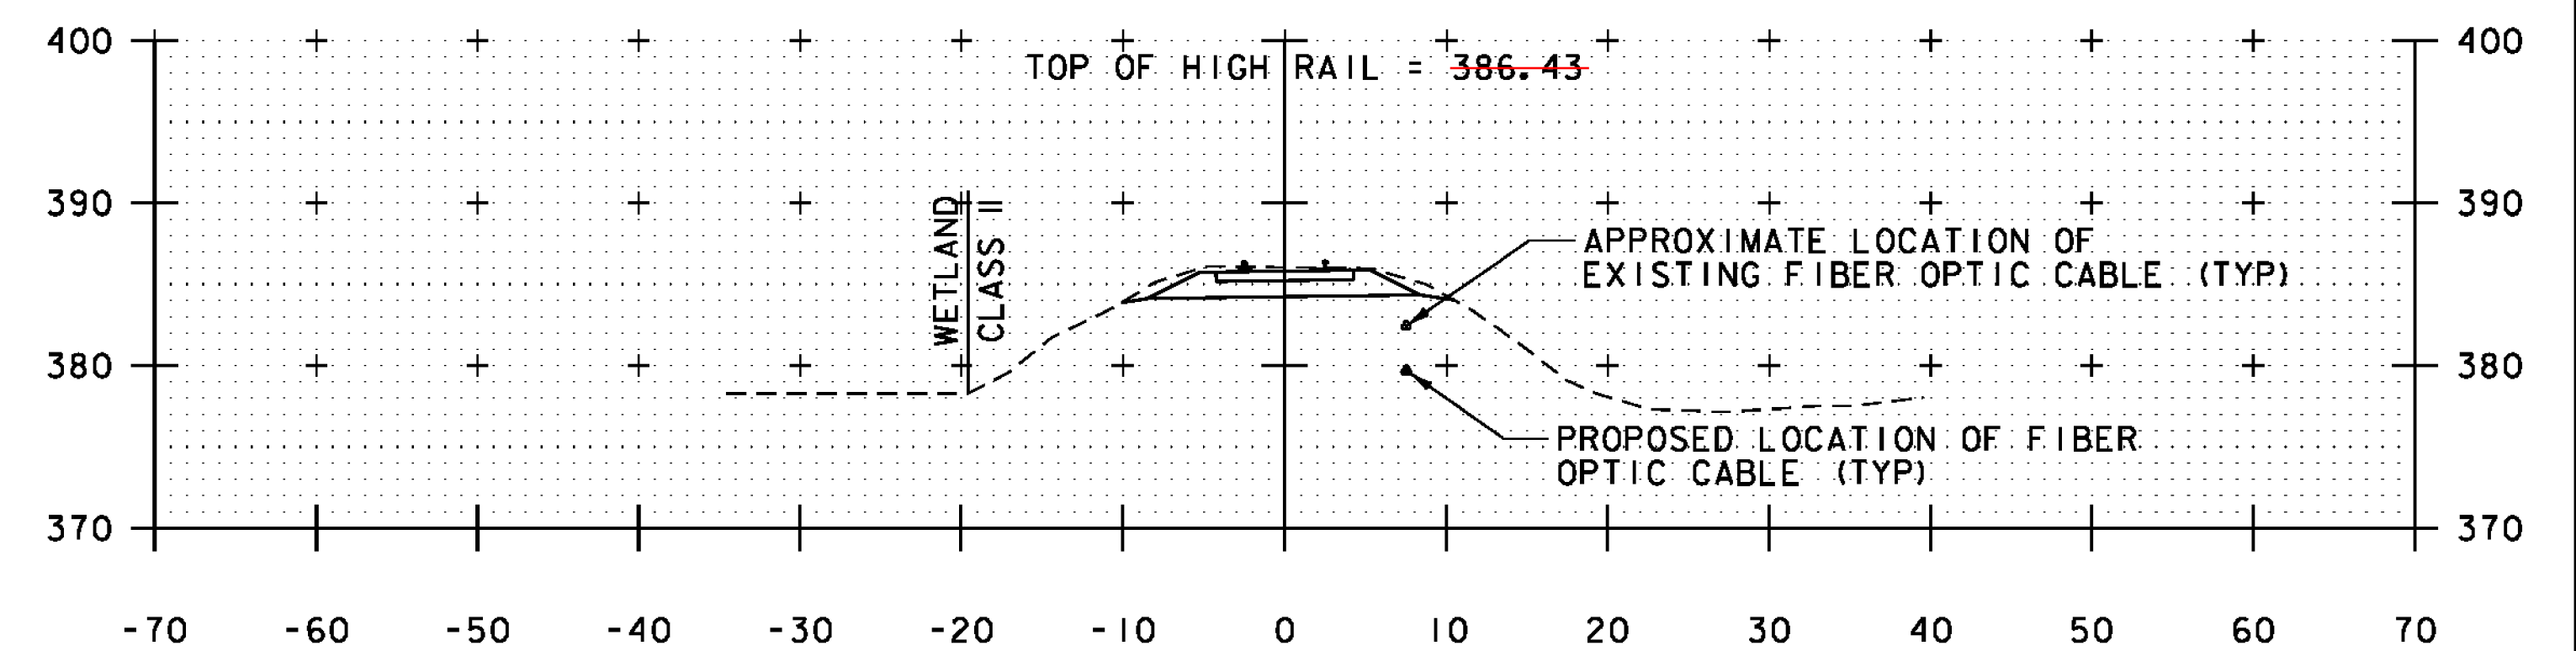

596+50

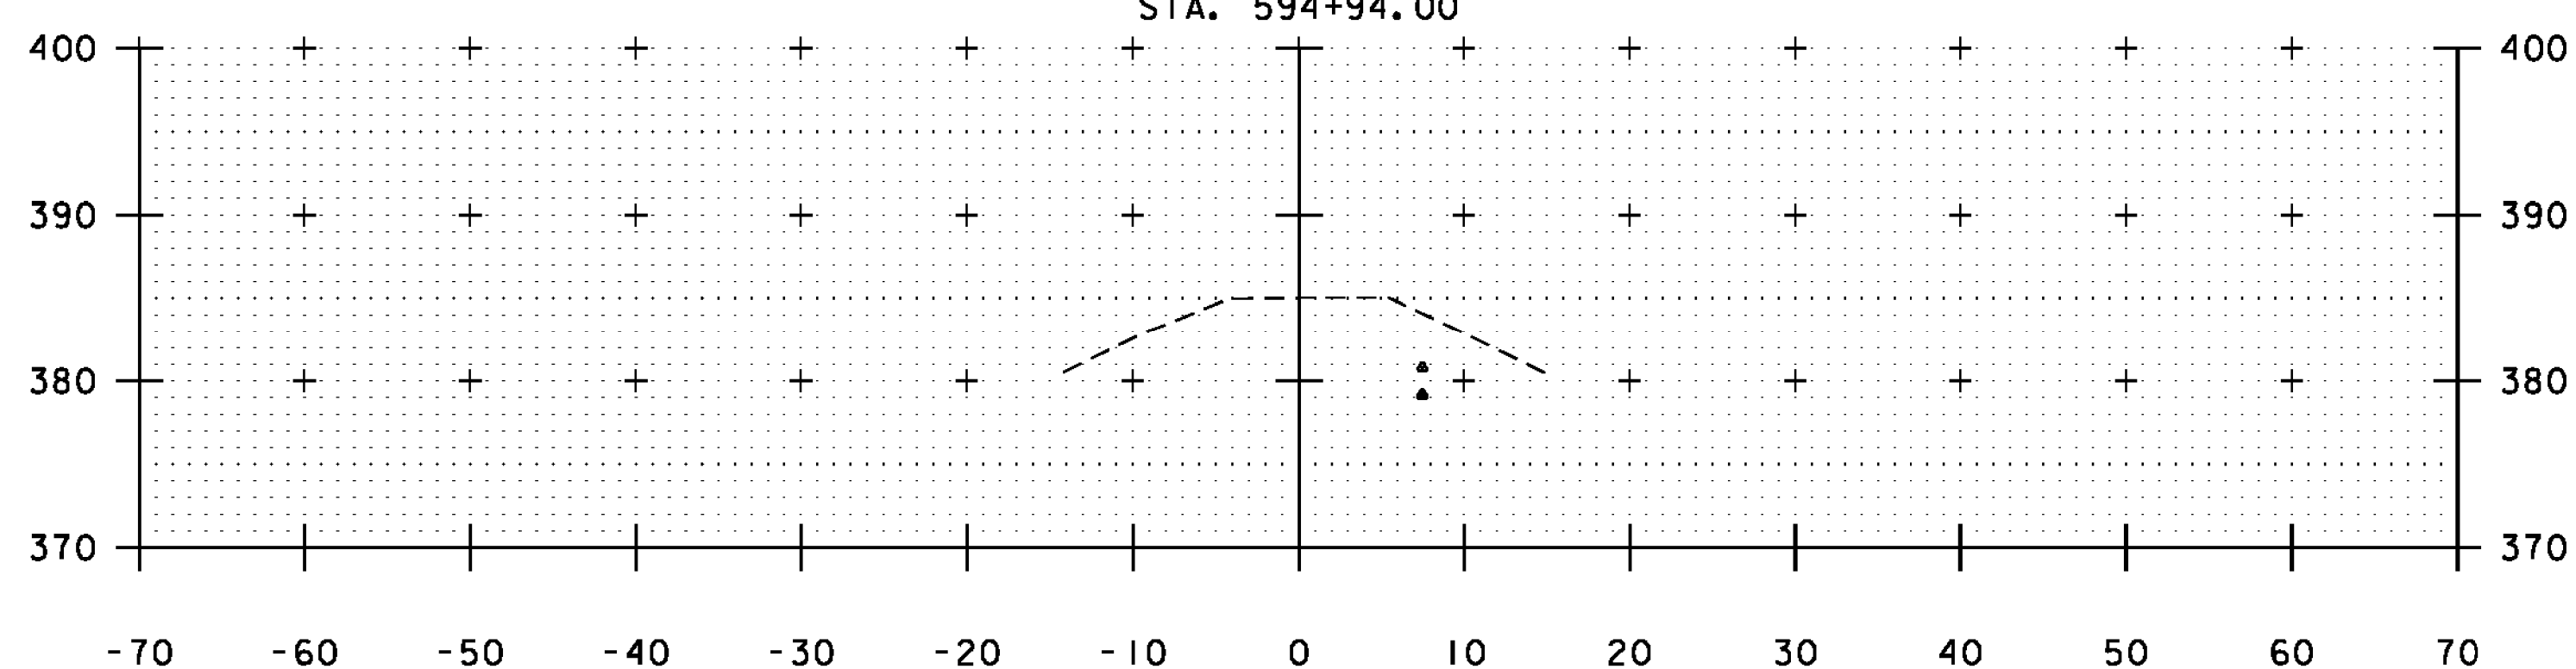

594+50

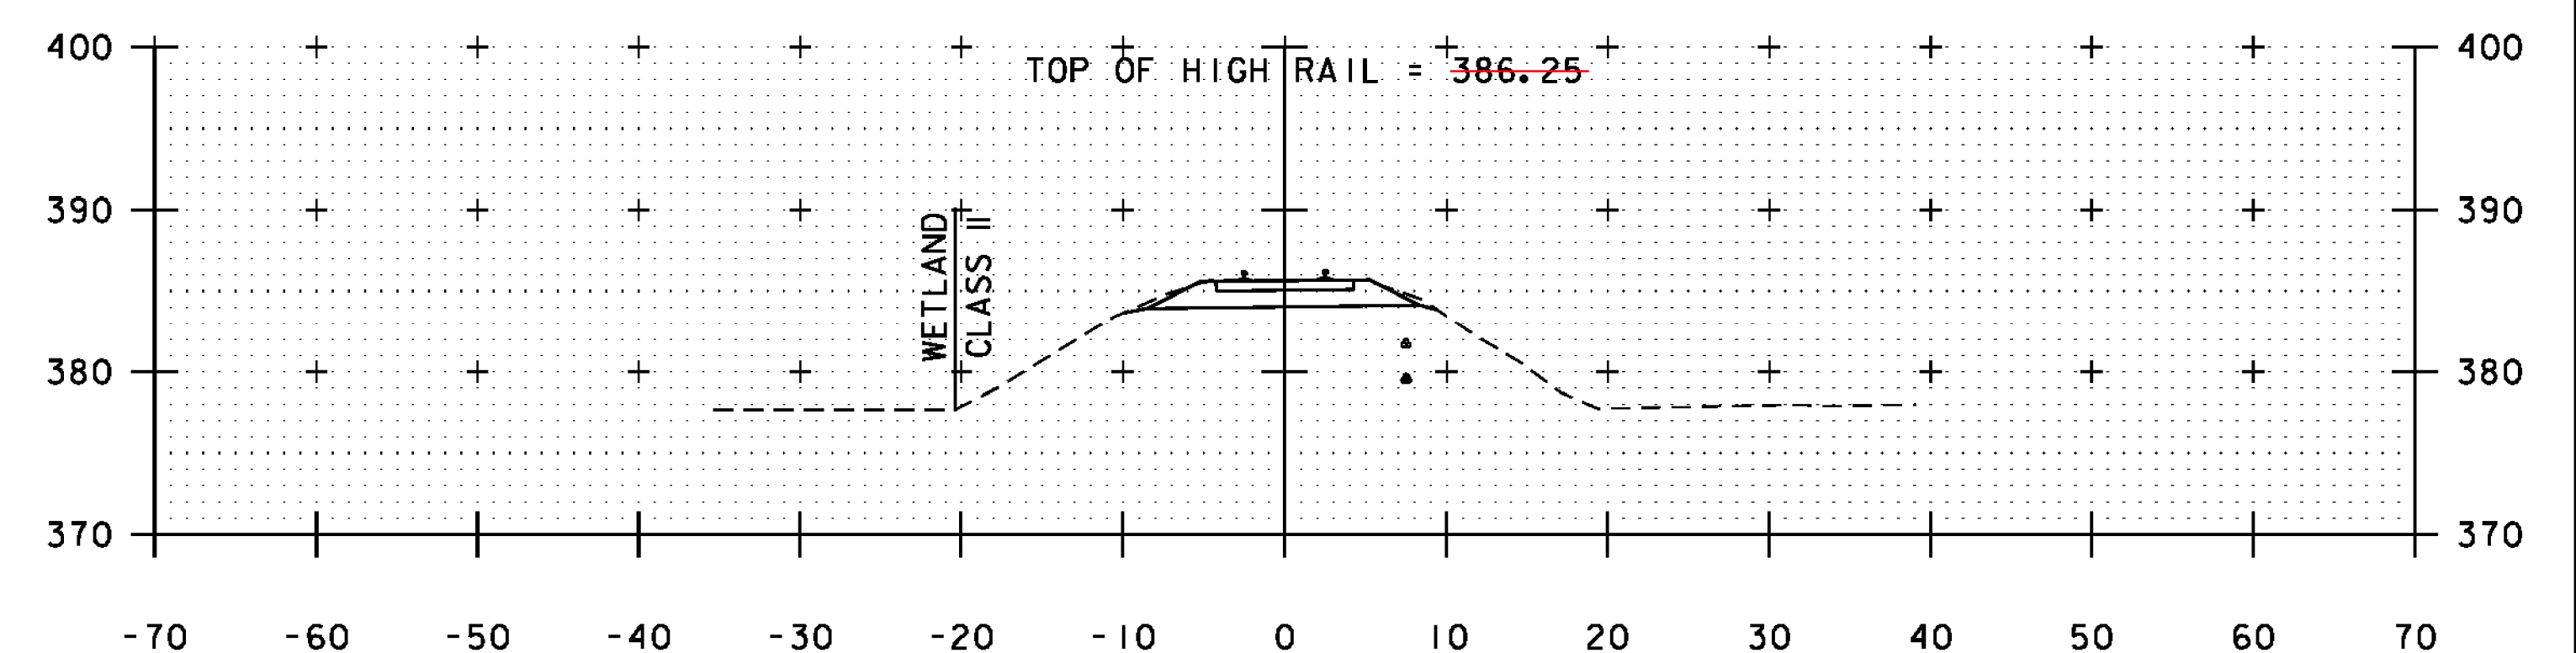

596+00

RAILROAD CROSS SECTIONS
SCALE 1" = 10'-0"
STA. 594+50 - 597+00



PROJECT NAME: CASTLETON	PLOT DATE: 9/19/2014
PROJECT NUMBER: BRF 015-2(10)	DRAWN BY: E.A. FIALA
FILE NAME: z12b138xs.dgn	CHECKED BY: S.E. BURBANK
PROJECT LEADER: S.E. BURBANK	SHEET 63 OF 82
DESIGNED BY: E.A. FIALA	
RAILROAD CROSS SECTIONS (1 OF 5)	