




604+00

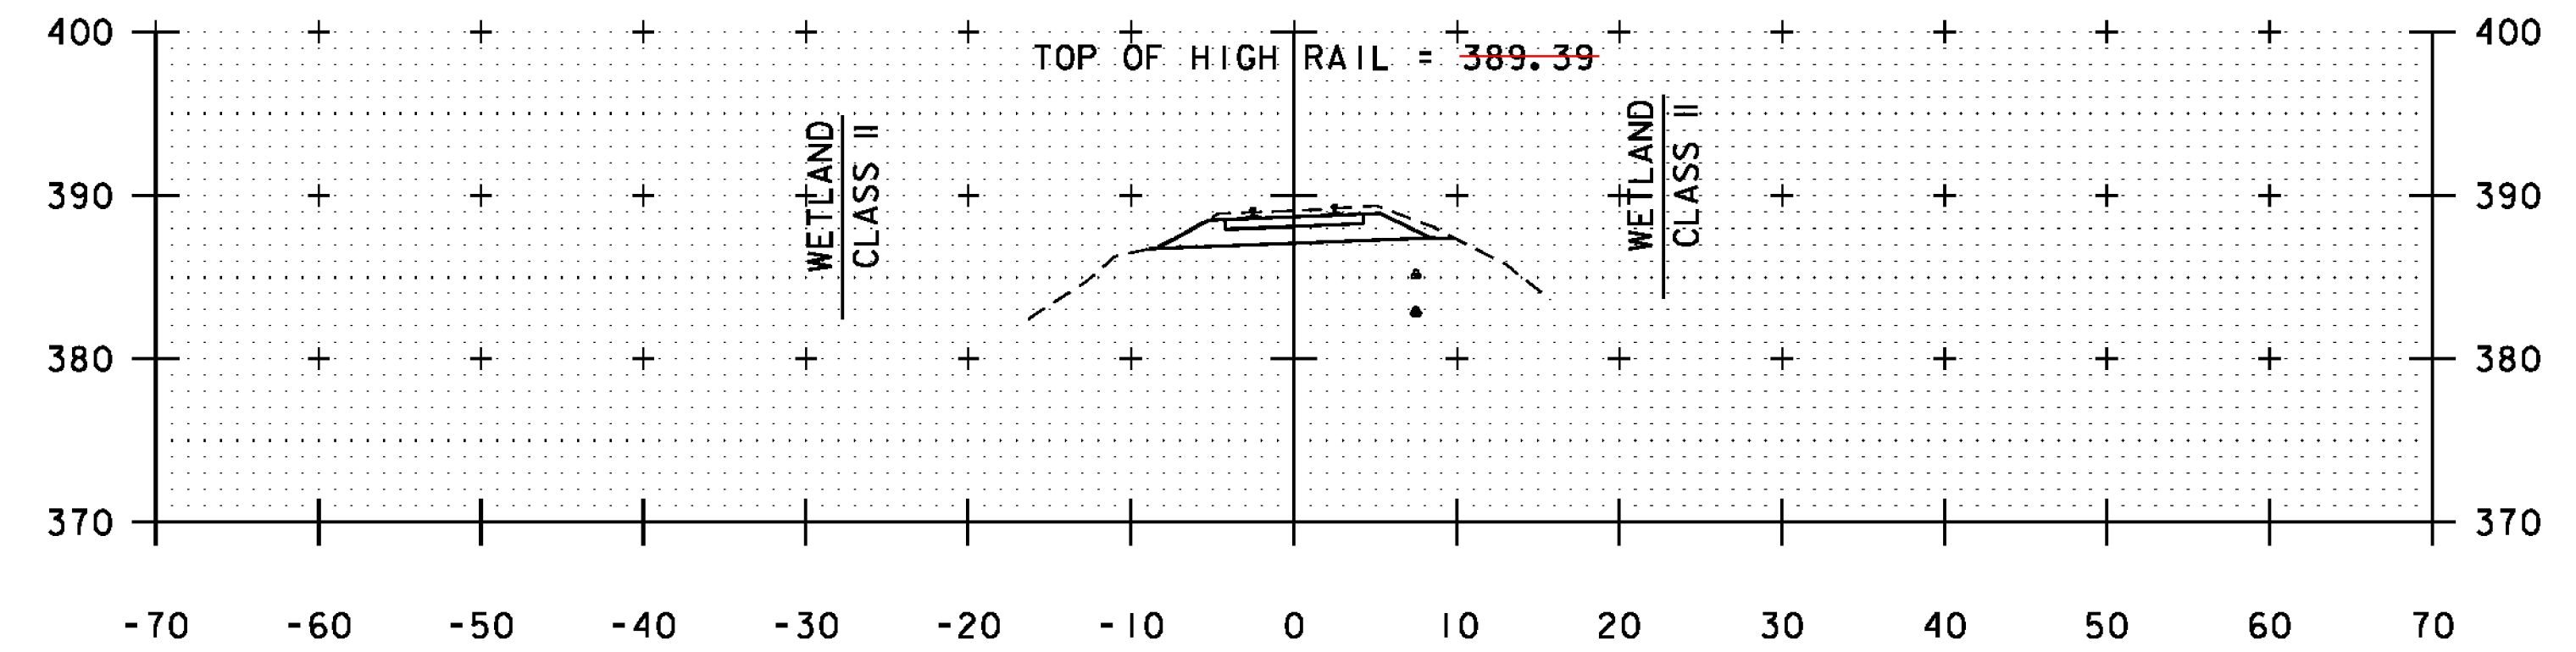


605+50

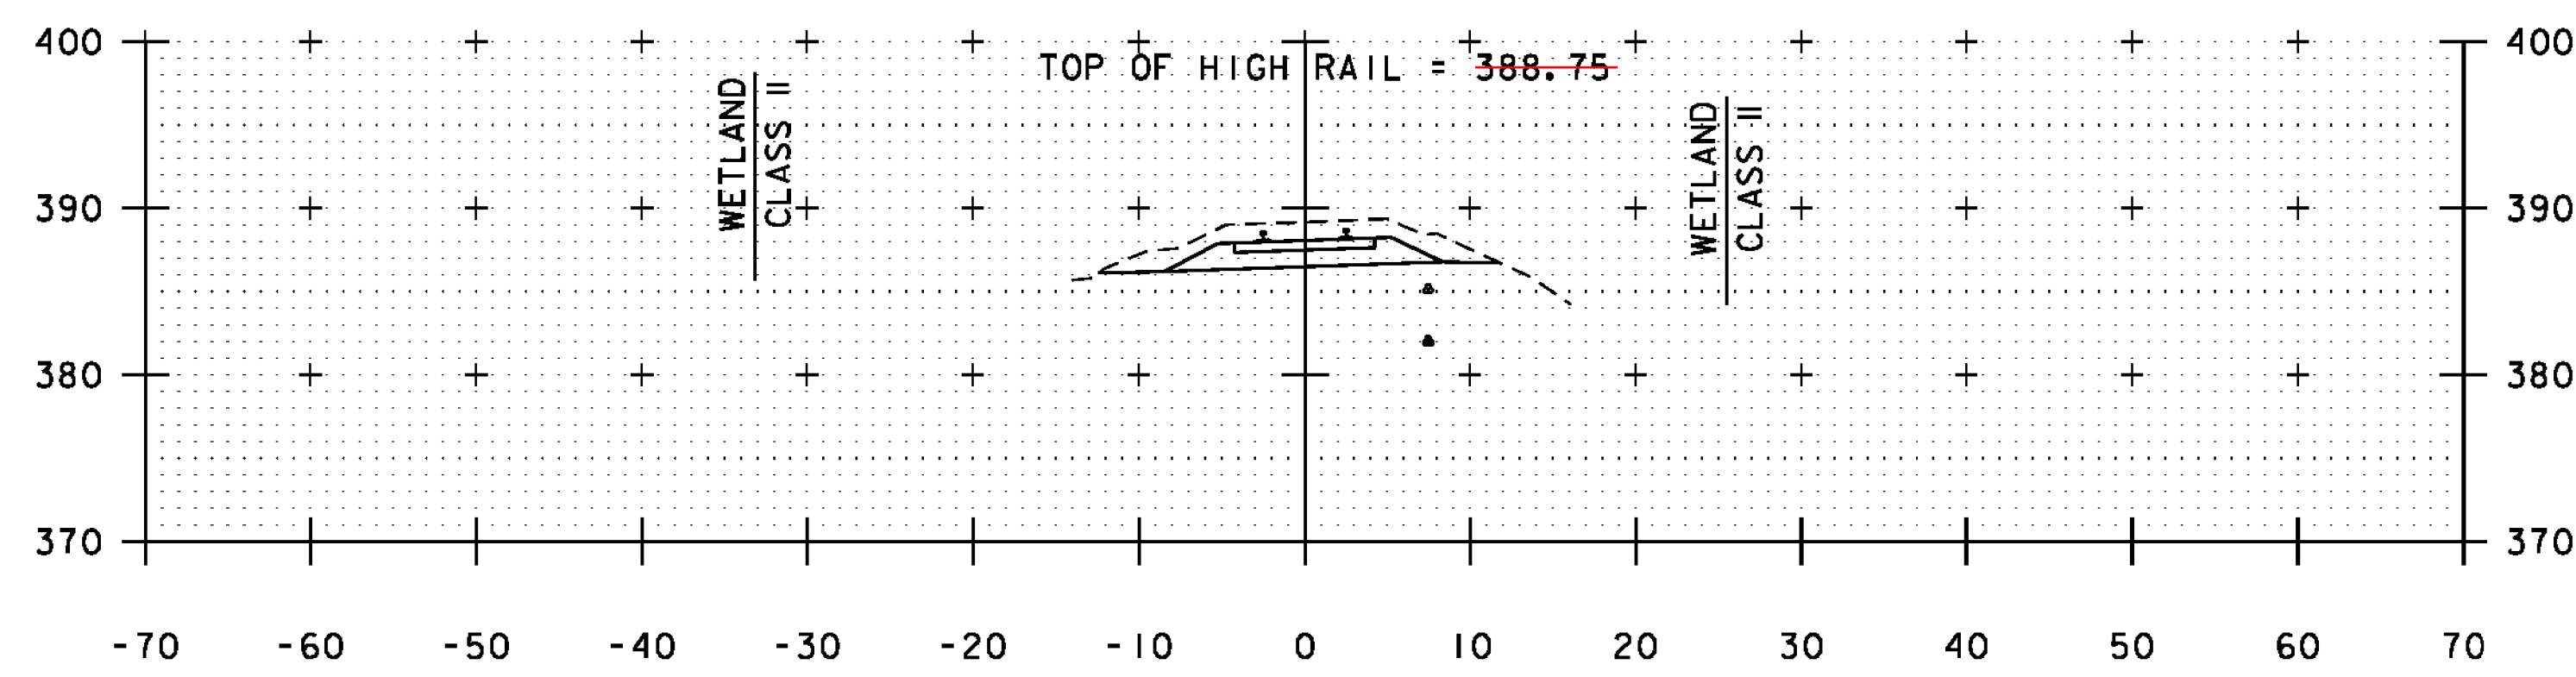


603+50

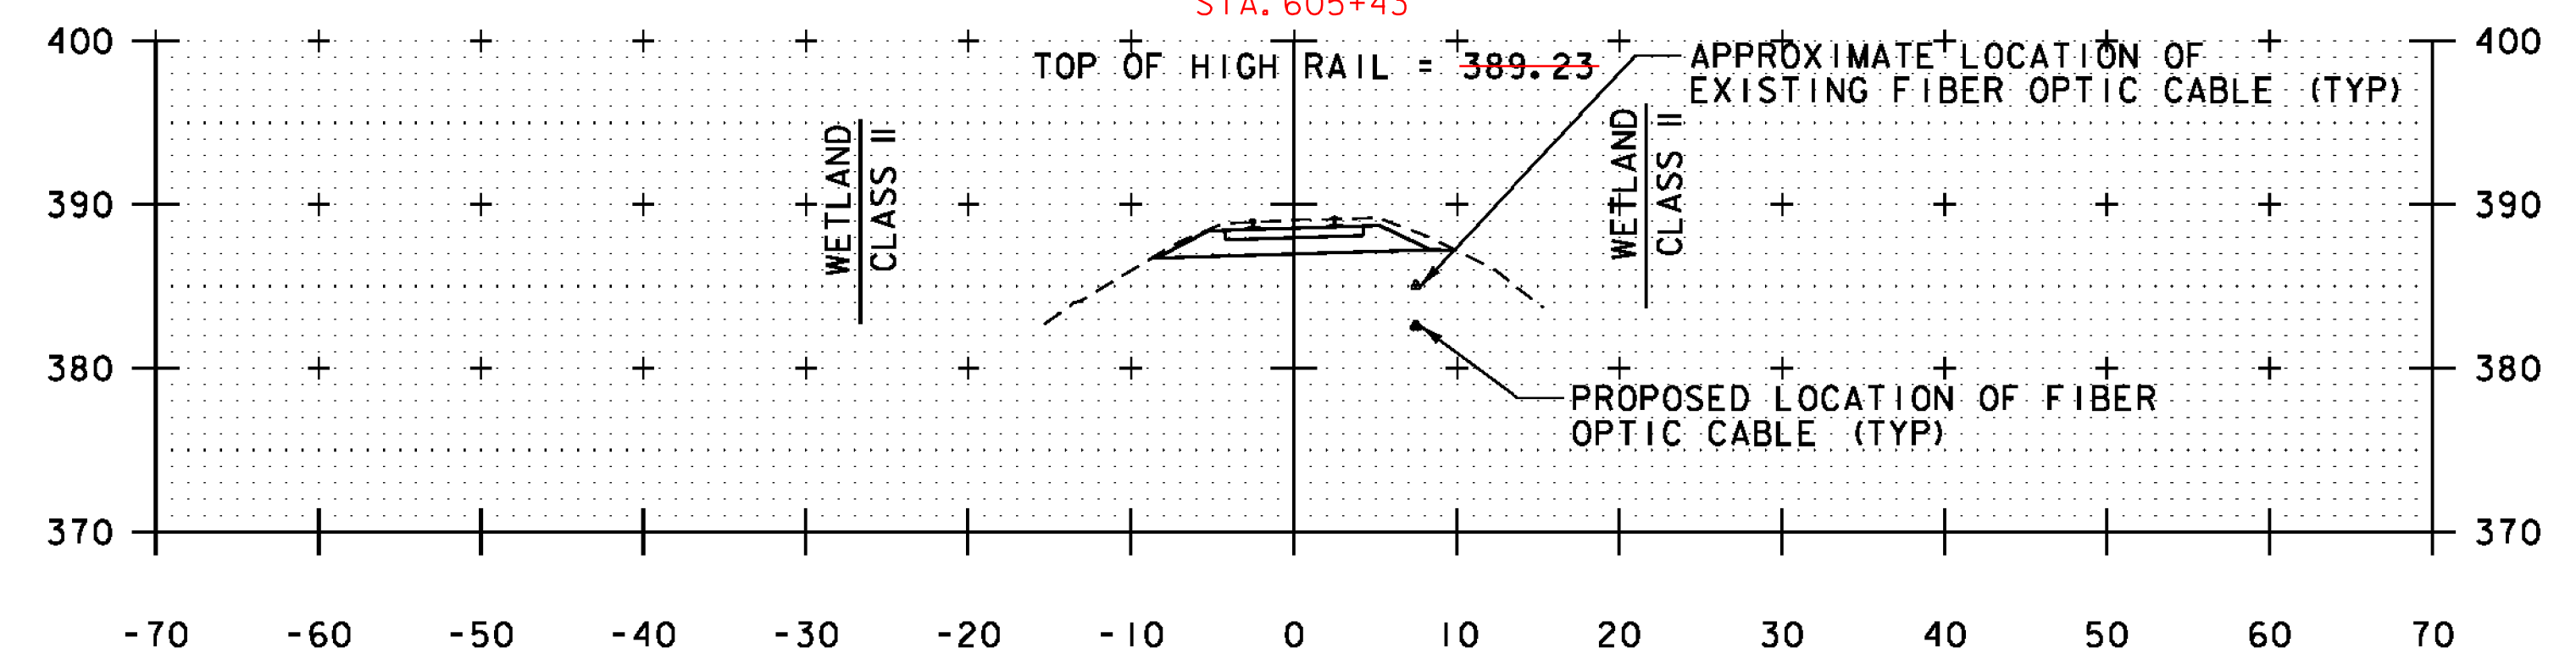

605+00

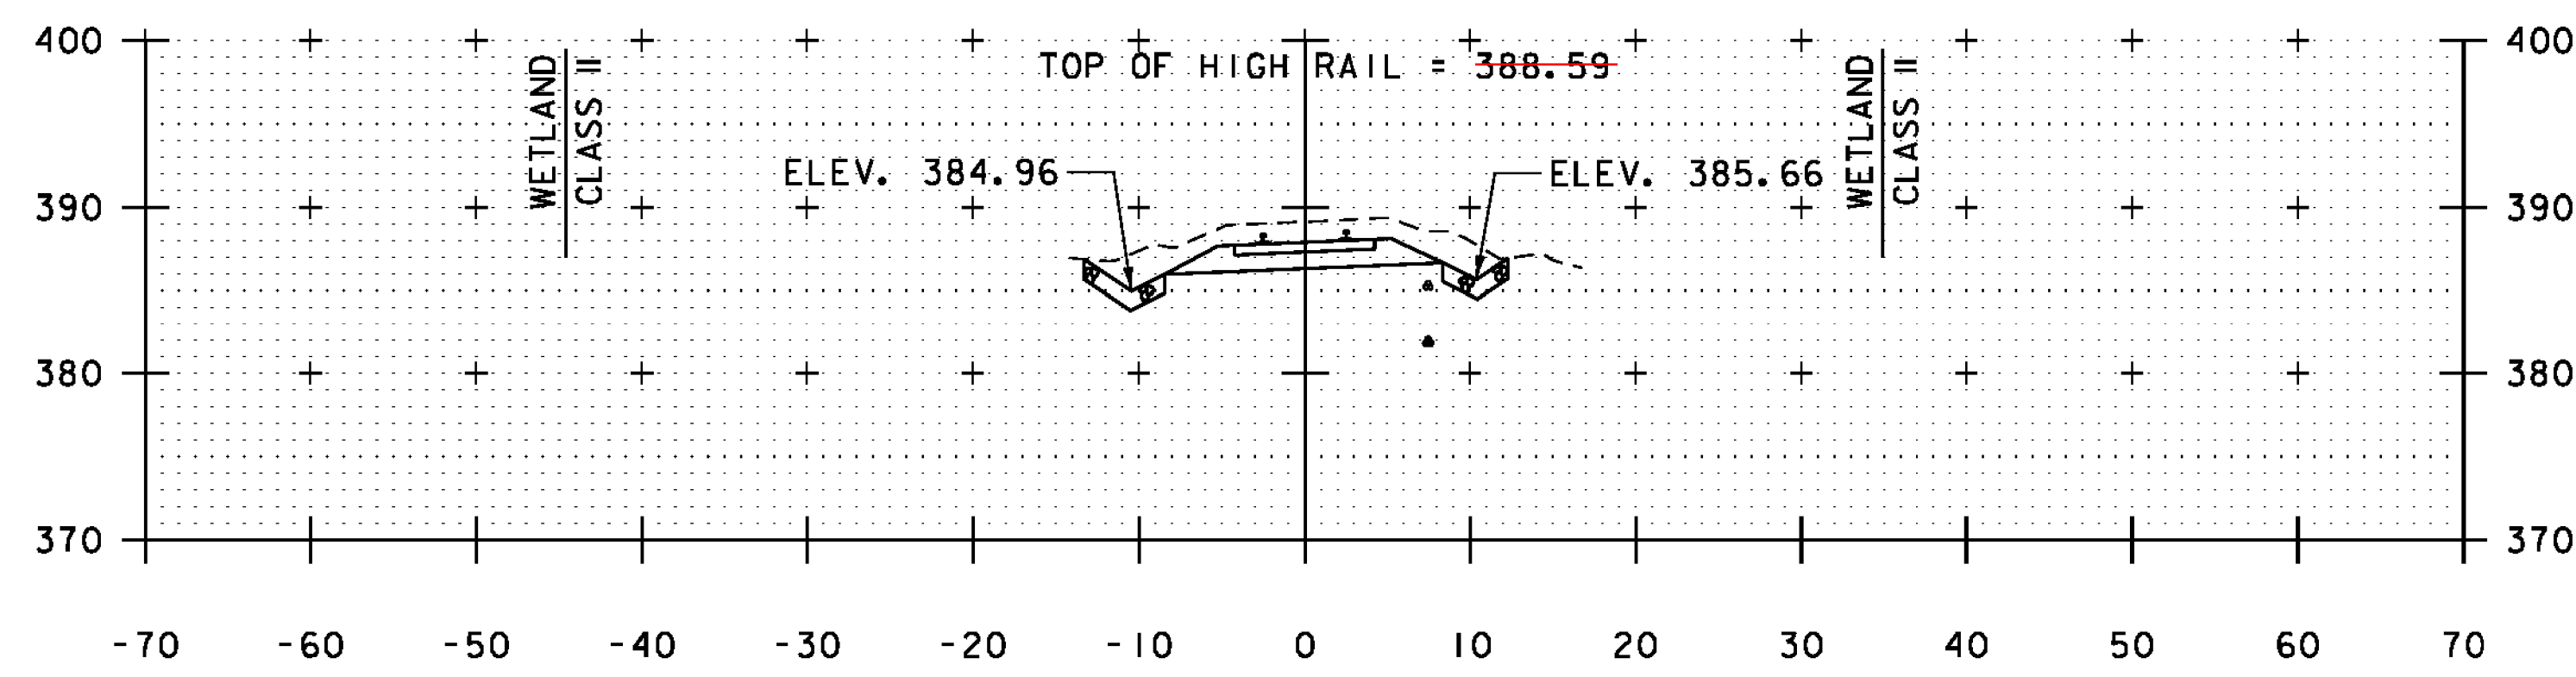

603+00

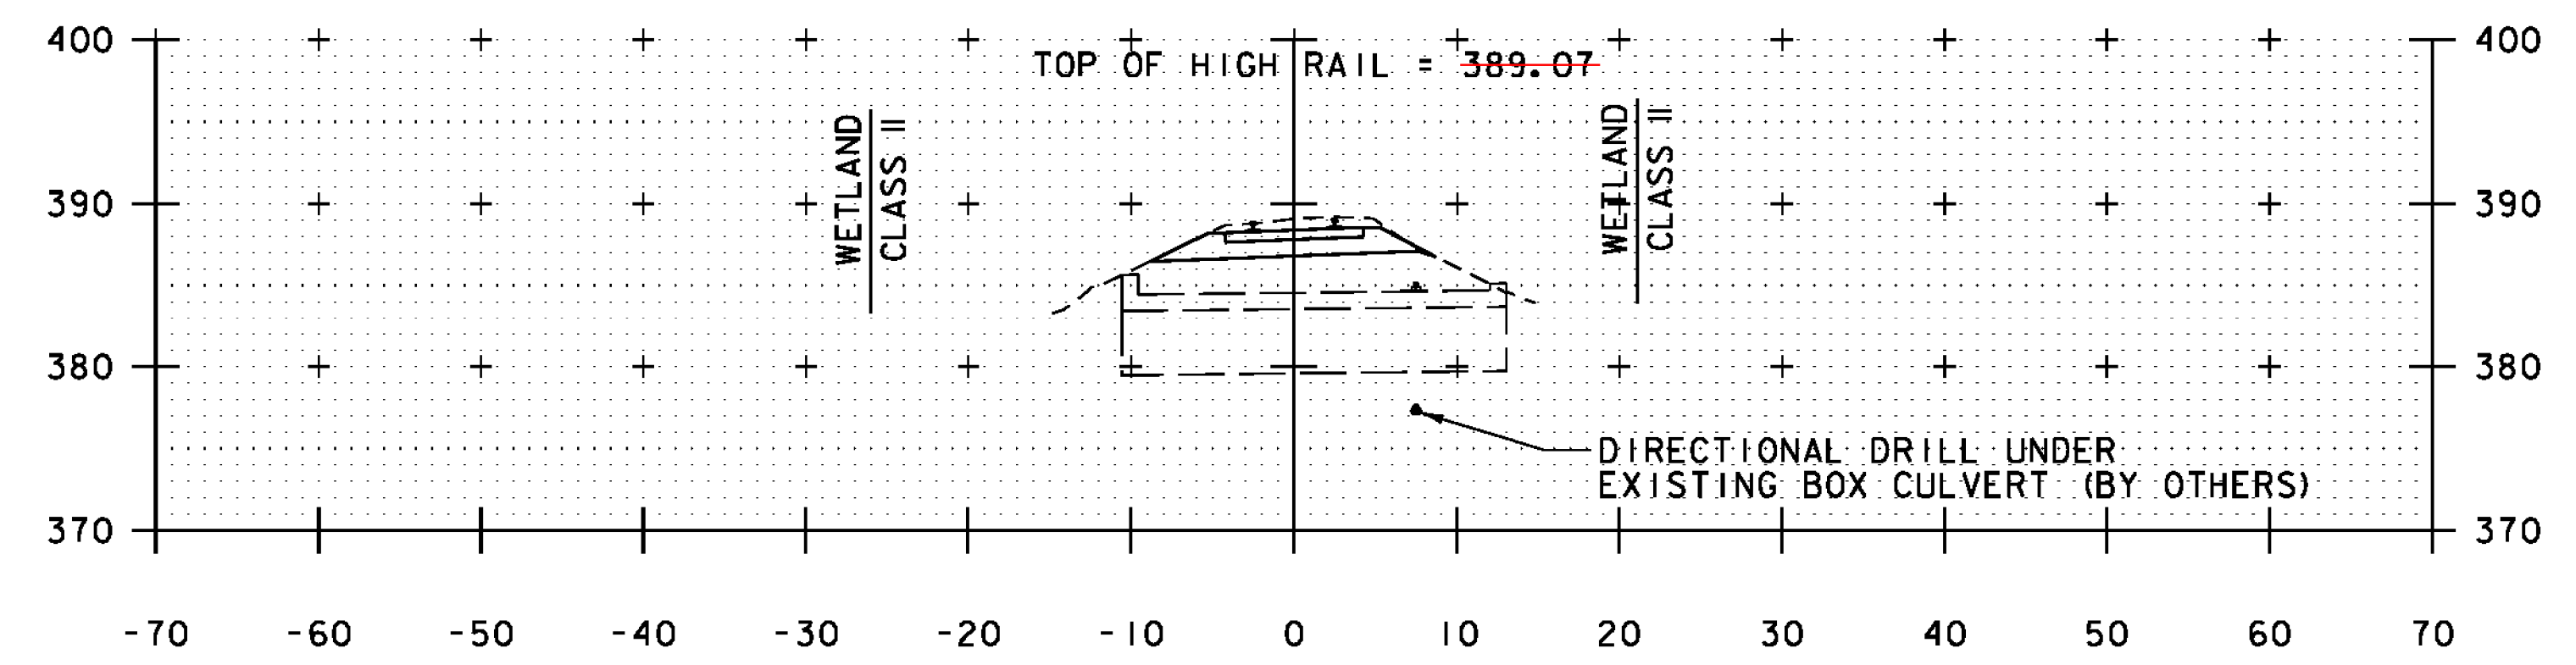

604+50

RAILROAD CROSS SECTIONS  
SCALE 1" = 10'-0"  
STA. 603+00 - 605+50



PROJECT NAME: CASTLETON	PLOT DATE: 9/19/2014
PROJECT NUMBER: BRF 015-2(10)	DRAWN BY: E.A. FIALA
FILE NAME: z12b138xs.dgn	CHECKED BY: S.E. BURBANK
PROJECT LEADER: S.E. BURBANK	SHEET 66 OF 82
DESIGNED BY: E.A. FIALA	
RAILROAD CROSS SECTIONS (4 OF 5)	