


BEGIN RAIL WORK
STA. 594+94.00

SOIL CLASSIFICATION	
LIMERICK SILT LOAM (110)	0% TO 3% SLOPES CLASSIFIED HIGH EROSION POTENTIAL
WINDSOR LOAMY SAND (18D)	15% TO 25% SLOPES CLASSIFIED LOW EROSION POTENTIAL



PROJECT NAME:	CASTLETON
PROJECT NUMBER:	BRF 015-2(10)
FILE NAME:	z12b138bdr_ero.dgn
PROJECT LEADER:	S.E. BURBANK
DESIGNED BY:	E.A. FIALA
RAIL EPSC EXISTING SITE PLAN (1 OF 3)	
PLOT DATE:	10/23/2014
DRAWN BY:	E.A. FIALA
CHECKED BY:	S.E. BURBANK
SHEET	72 OF 82

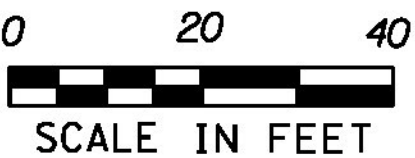