


SOIL CLASSIFICATION

LIMERICK SILT LOAM (110)
0% TO 3% SLOPES
CLASSIFIED HIGH EROSION POTENTIAL

WINDSOR LOAMY SAND (18D)
15% TO 25% SLOPES
CLASSIFIED LOW EROSION POTENTIAL

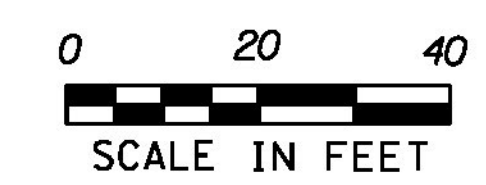

PROJECT NAME:	CASTLETON
PROJECT NUMBER:	BRF 015-2(10)
FILE NAME: z12bi38bdr_ero.dgn	PLOT DATE: 10/24/2014
PROJECT LEADER: S.E. BURBANK	DRAWN BY: E.A. FIALA
DESIGNED BY: E.A. FIALA	CHECKED BY: S.E. BURBANK
RAIL EPSC EXISTING SITE PLAN (2 OF 3)	SHEET 73 OF 82

