


MATCHLINE STA. 605 + 50

END RAIL WORK  
STA. 606+20.00

TO HYDEVILLE

TO CASTLETON

SOIL CLASSIFICATION	
LIMERICK SILT LOAM (IIO)	0% TO 3% SLOPES CLASSIFIED HIGH EROSION POTENTIAL
WINDSOR LOAMY SAND (IBD)	15% TO 25% SLOPES CLASSIFIED LOW EROSION POTENTIAL

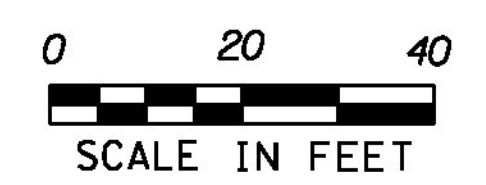

PROJECT NAME:	CASTLETON
PROJECT NUMBER:	BRF 015-2(10)
FILE NAME: z12bi38bdr_ero.dgn	PLOT DATE: 10/24/2014
PROJECT LEADER: S.E. BURBANK	DRAWN BY: E.A. FIALA
DESIGNED BY: E.A. FIALA	CHECKED BY: S.E. BURBANK
RAIL EPSC EXISTING SITE PLAN (3 OF 3)	SHEET 74 OF 82

