



STONE FILL, TYPE I
 STA. 598+58 - 599+50, LT & RT

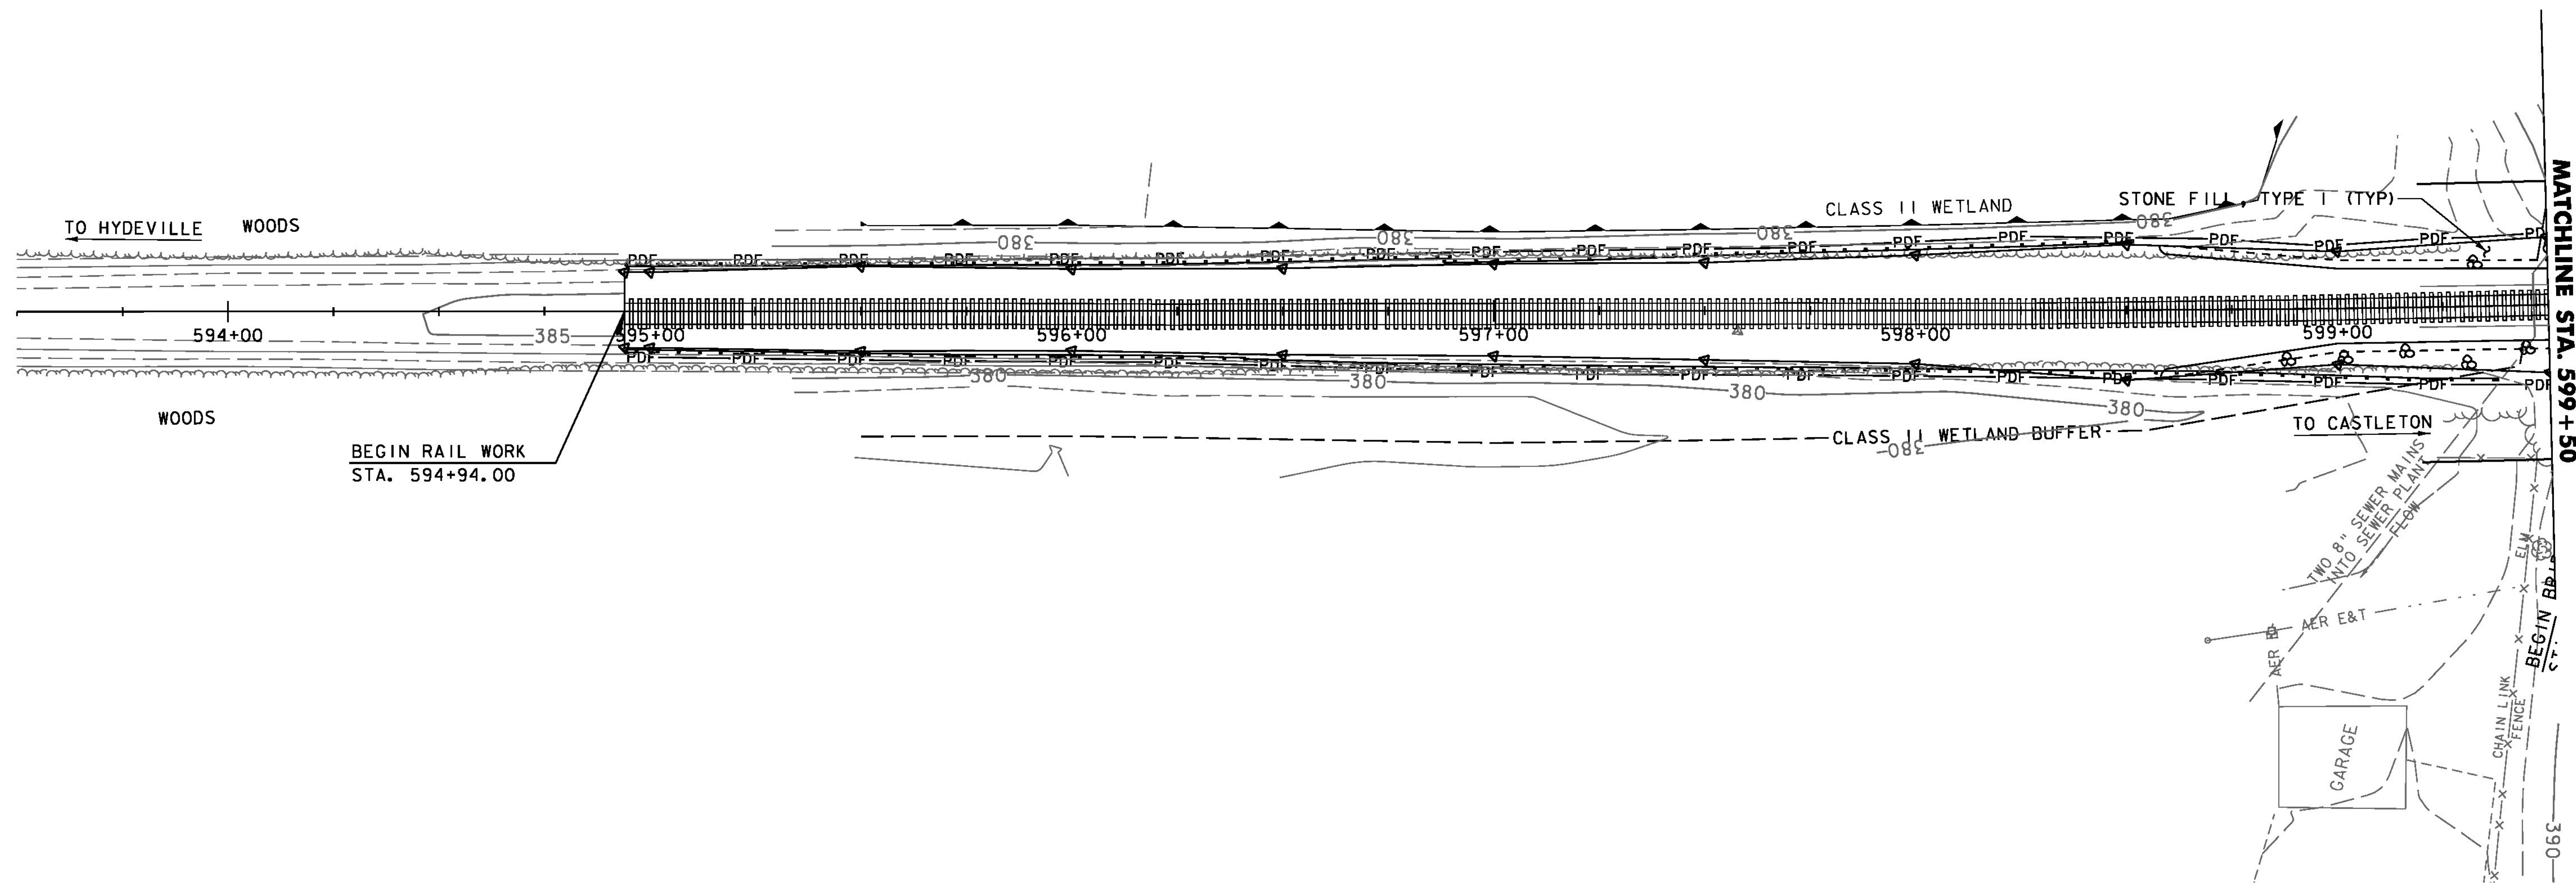

BEGIN RAIL WORK
 STA. 594+94.00

NOTE: SEE EPSC DETAILS FOR SYMBOLOLOGY.

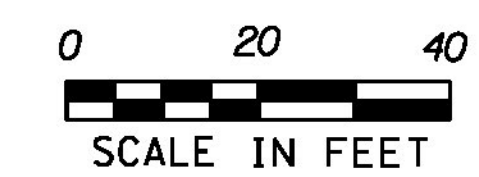

PROJECT NAME:	CASTLETON
PROJECT NUMBER:	BRF 015-2(10)
FILE NAME:	z12bi38bdr_ero.dgn
PROJECT LEADER:	S.E. BURBANK
DESIGNED BY:	E.A. FIALA
RAIL EPSC CONSTRUCTION SITE PLAN (1 OF 3) SHEET	75 OF 82
PLOT DATE:	9/19/2014
DRAWN BY:	E.A. FIALA
CHECKED BY:	S.E. BURBANK

