


PERMANENT STEEL SHEET PILING
 STA. 599+79 - 601+20, LT
 STA. 600+14 - 600+99, RT
 STONE FILL, TYPE I
 STA. 599+50 - 603+20, LT & RT

MATCHLINE STA. 599+50

MATCHLINE STA. 605+50

TO CASTLETON

NOTE: SEE EPSC DETAILS FOR SYMBOLOLOGY.

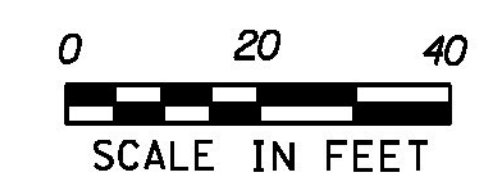

PROJECT NAME:	CASTLETON
PROJECT NUMBER:	BRF 015-2(10)
FILE NAME:	z12bi38bdr_ero.dgn
PLOT DATE:	10/24/2014
PROJECT LEADER:	S.E. BURBANK
DRAWN BY:	E.A. FIALA
DESIGNED BY:	E.A. FIALA
CHECKED BY:	S.E. BURBANK
RAIL EPSC CONSTRUCTION SITE PLAN (2 OF 3) SHEET	76 OF 82

