


NOTE: SEE EPSC DETAILS FOR SYMBOLOGY.



PROJECT NAME:	CASTLETON
PROJECT NUMBER:	BRF 015-2(10)
FILE NAME: z12bi38bdr_ero.dgn	PLOT DATE: 9/19/2014
PROJECT LEADER: S.E. BURBANK	DRAWN BY: E.A. FIALA
DESIGNED BY: E.A. FIALA	CHECKED BY: S.E. BURBANK
RAIL EPSC FINAL SITE PLAN (3 OF 3)	SHEET 80 OF 82

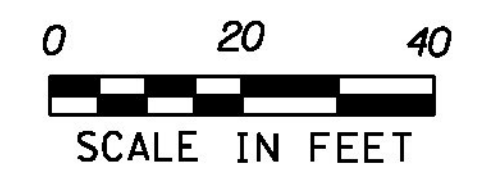