

STATE OF VERMONT AGENCY OF TRANSPORTATION



PROPOSED IMPROVEMENT BRIDGE PROJECT


TOWN OF ANDOVER
COUNTY OF WINDSOR

ROUTE NO : VT RTE 11, RURAL MINOR ARTERIAL BRIDGE NO : 41


PROJECT LOCATION: BEGINNING ON VT 11 APPROXIMATELY 4.0 MILES EAST OF THE INTERSECTION OF VT 11 AND VT 121 AND EXTENDING WESTERLY ALONG VT 11 FOR 0.024 MILES.

PROJECT DESCRIPTION: REMOVAL AND REPLACEMENT OF DECK AND SUPERSTRUCTURE WITH MINOR SUBSTRUCTURE REPAIRS, RELATED ROADWAY APPROACH AND CHANNEL WORK.

LENGTH OF STRUCTURE: 48.50 FEET
LENGTH OF ROADWAY: 76.50 FEET
LENGTH OF PROJECT: 125.00 FEET

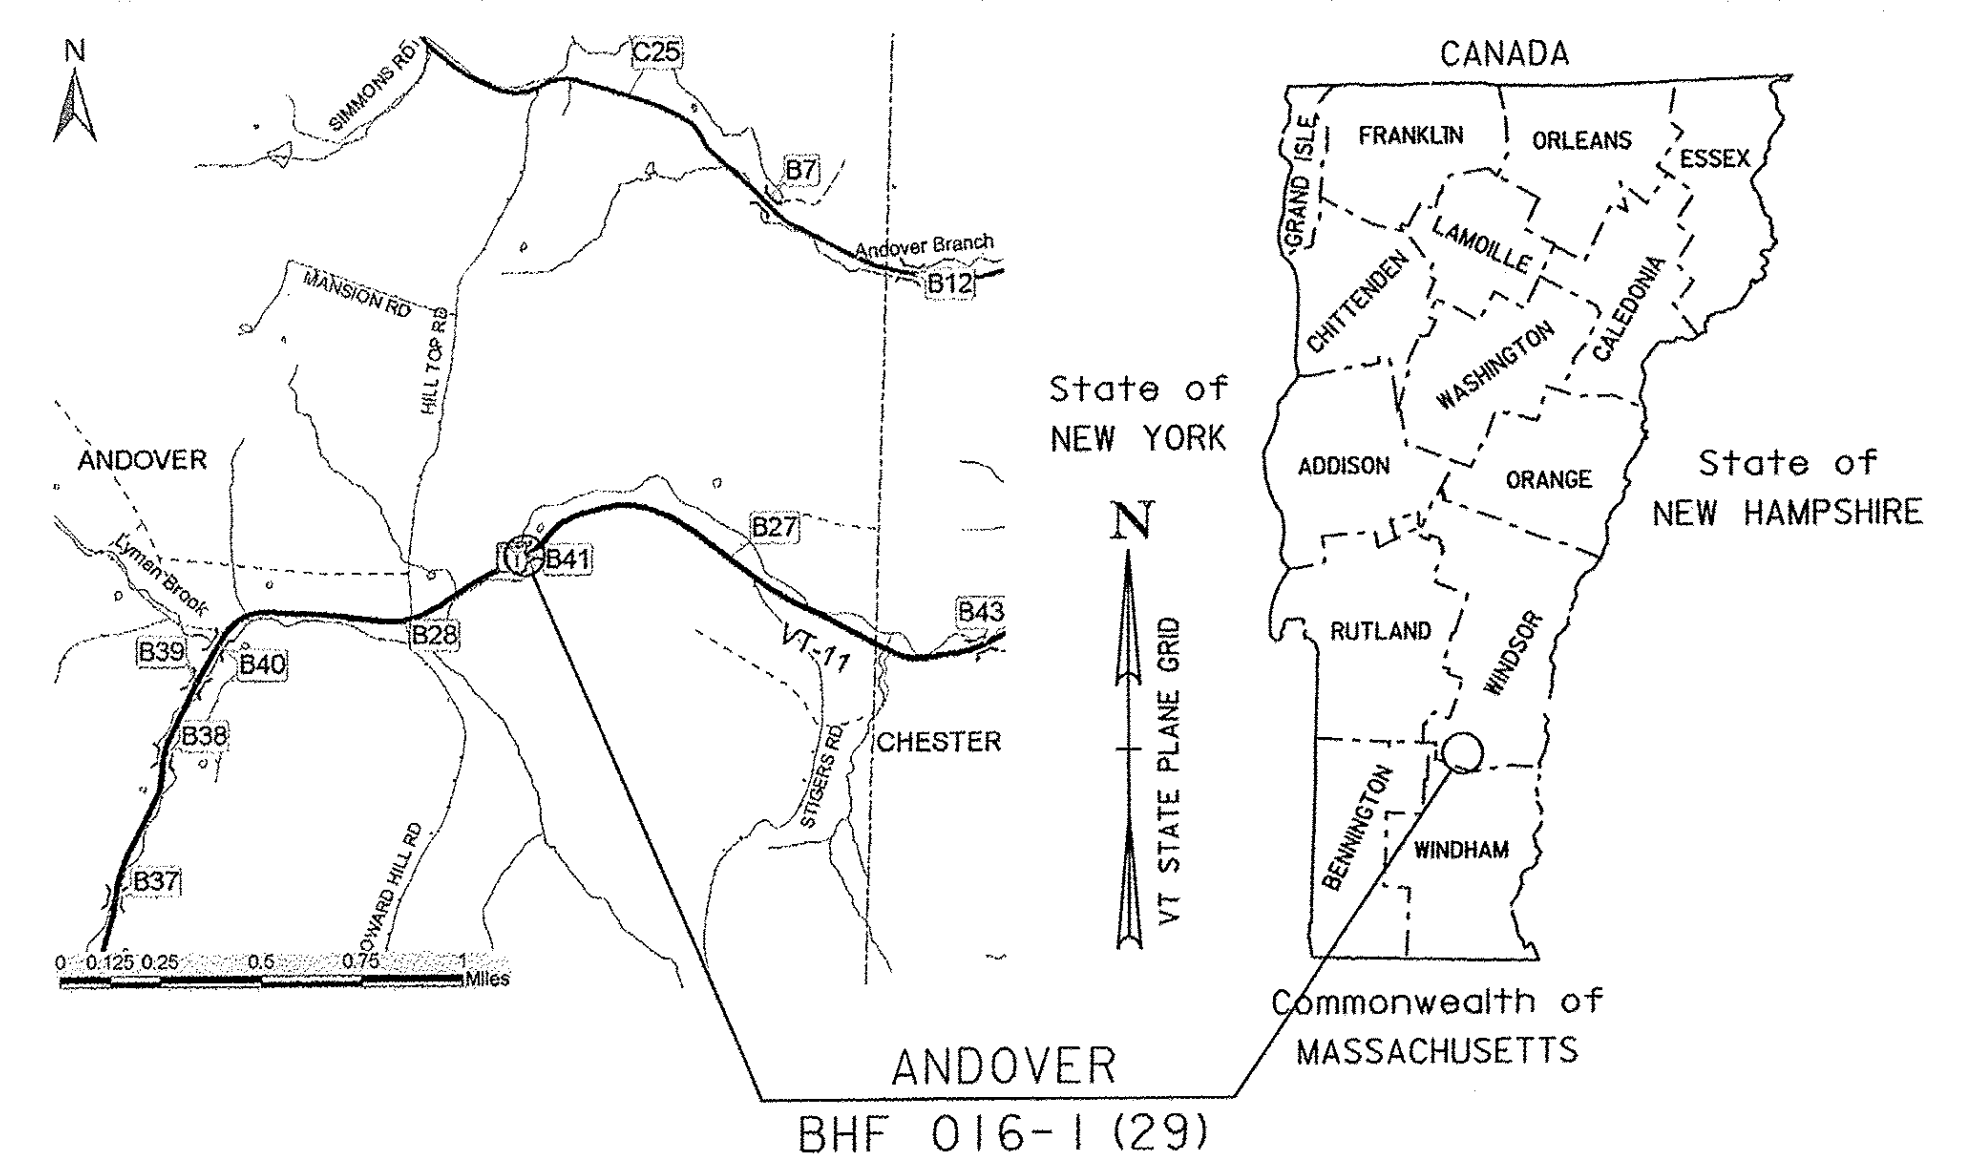

RECORD PLANS	
CONTRACTOR:	RENAUD BROTHERS, INC. - VERNON, VT
RESIDENT ENGINEER:	DARYL BASSETT
CONSTRUCTION BEGAN:	JULY 9, 2015
CONSTRUCTION COMPLETE:	JULY 30, 2015
RECORD PLANS BY:	DARYL BASSETT & KEVIN KING
I HEREBY CERTIFY THAT ALL THE CONSTRUCTION REQUIRED BY THIS SET OF DRAWINGS HAS BEEN ACCOMPLISHED AS INDICATED HEREIN.	
BY <i>[Signature]</i>	RESIDENT ENGINEER
DATE <u>3/22/16</u>	
NOTE: Any further information concerning final quantities, amounts or other details relative to this project may be found at Central Files in the electronic archives.	

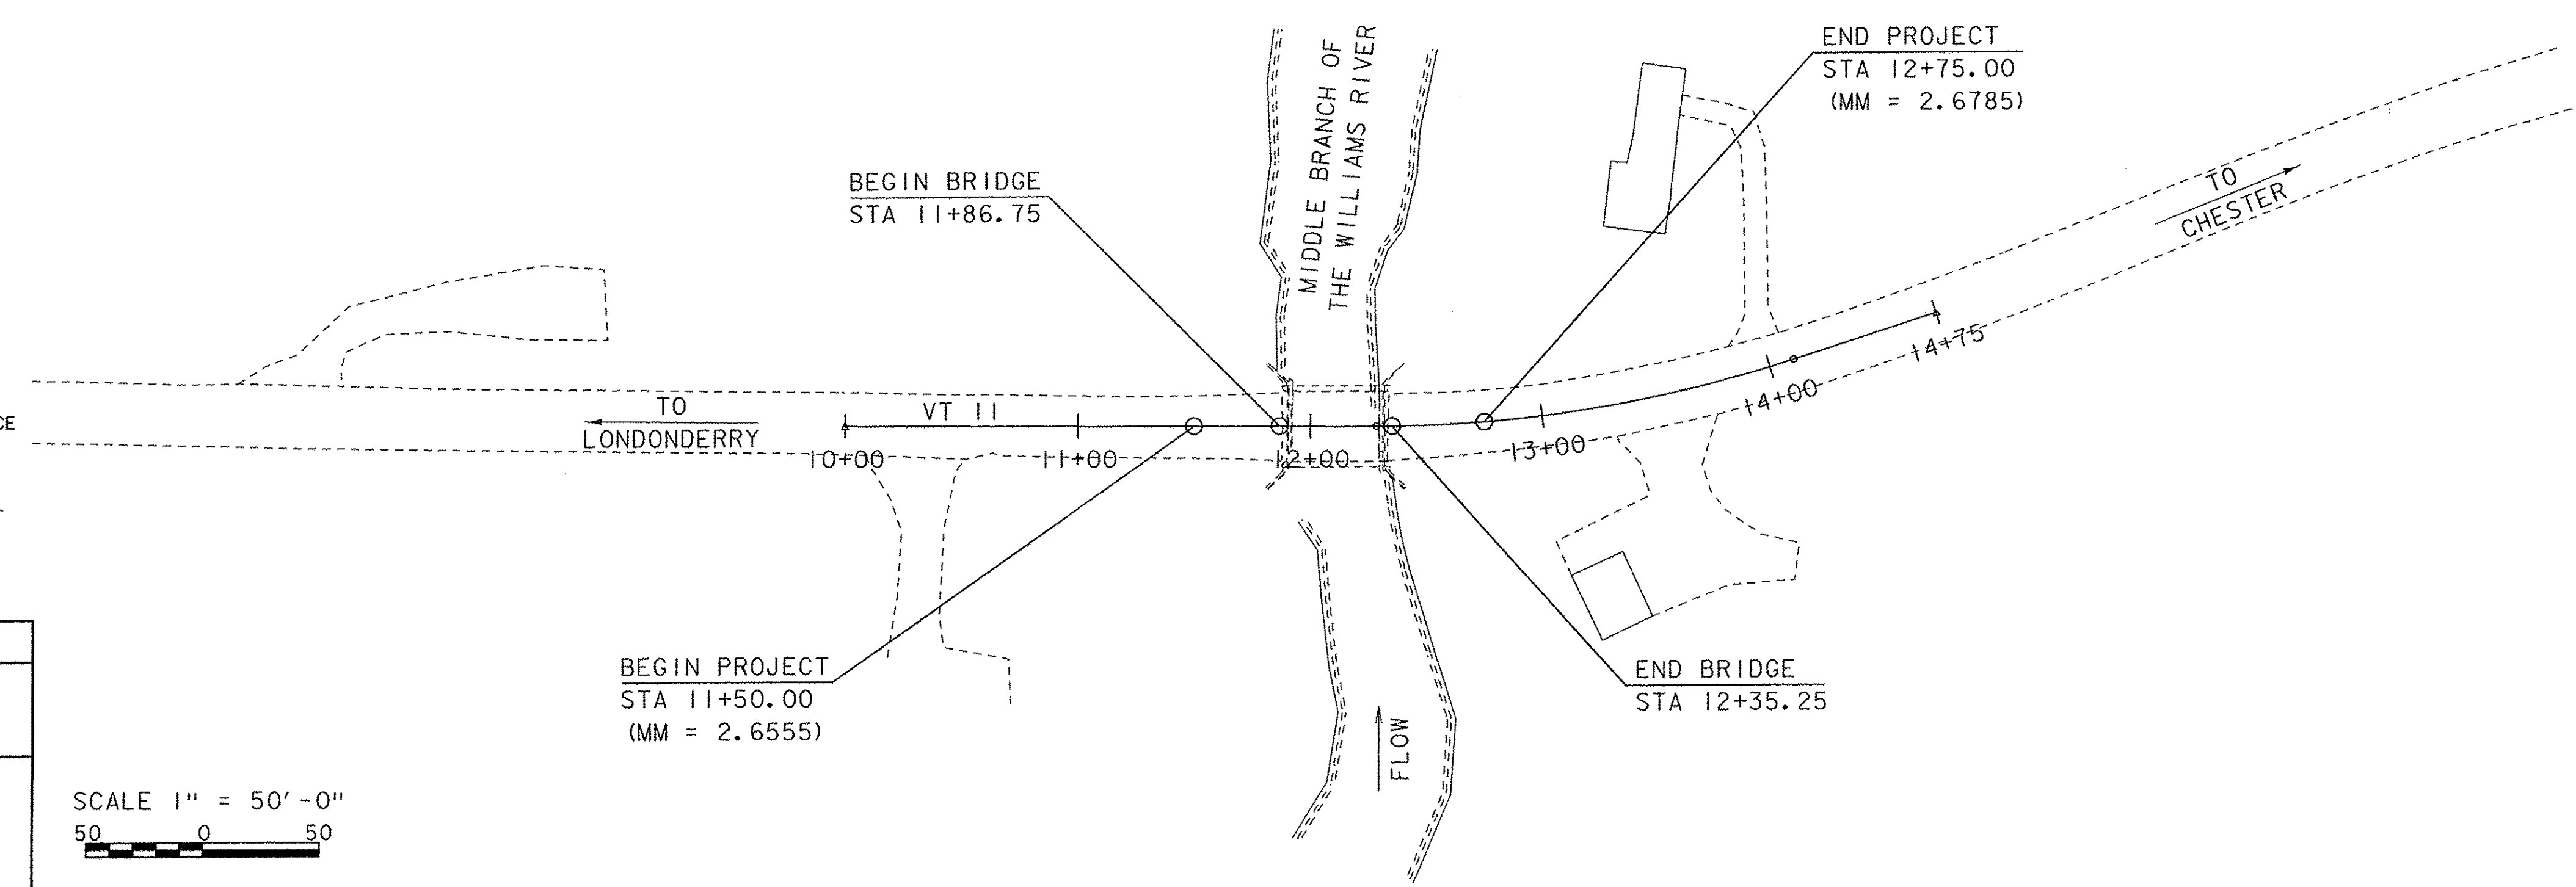

CONSTRUCTION IS TO BE CARRIED ON IN ACCORDANCE WITH THESE PLANS AND THE STANDARD SPECIFICATIONS FOR CONSTRUCTION DATED 2011, AS APPROVED BY THE FEDERAL HIGHWAY ADMINISTRATION ON JULY 20, 2011 FOR USE ON THIS PROJECT, INCLUDING ALL SUBSEQUENT REVISIONS AND SUCH REVISED SPECIFICATIONS AND SPECIAL PROVISIONS AS ARE INCORPORATED IN THESE PLANS.

QUALITY ASSURANCE PROGRAM : LEVEL 2	
SURVEYED BY :	R. GILMAN
SURVEYED DATE :	5-28-2012
DATUM	
VERTICAL	NAVD88
HORIZONTAL	NAD83 (1996)



DIRECTOR OF PROJECT DELIVERY	
APPROVED <i>[Signature]</i>	DATE <u>1/9/2015</u>
PROJECT MANAGER : C. CARLSON, P.E.	
PROJECT NAME :	ANDOVER
PROJECT NUMBER :	BHF 016-1 (29)
SHEET 1 OF 48 SHEETS	