


VT ROUTE 11 TYPICAL SECTION

SCALE: 1/2" = 1'-0"

- \* 1 1/2" TYPE IVS BITUMINOUS CONCRETE PAVEMENT
- 1 1/2" TYPE IVS BITUMINOUS CONCRETE PAVEMENT
- 2 1/2" TYPE IIS BITUMINOUS CONCRETE PAVEMENT
- 2 1/2" TYPE IIS BITUMINOUS CONCRETE PAVEMENT

SUPERSTRUCTURE WAS REVISED VIA A VALUE ENGINEERING AGREEMENT. REFER TO CONTRACTOR'S VALUE ENGINEERING DESIGN AND COD/SA #IFOR DETAILS.

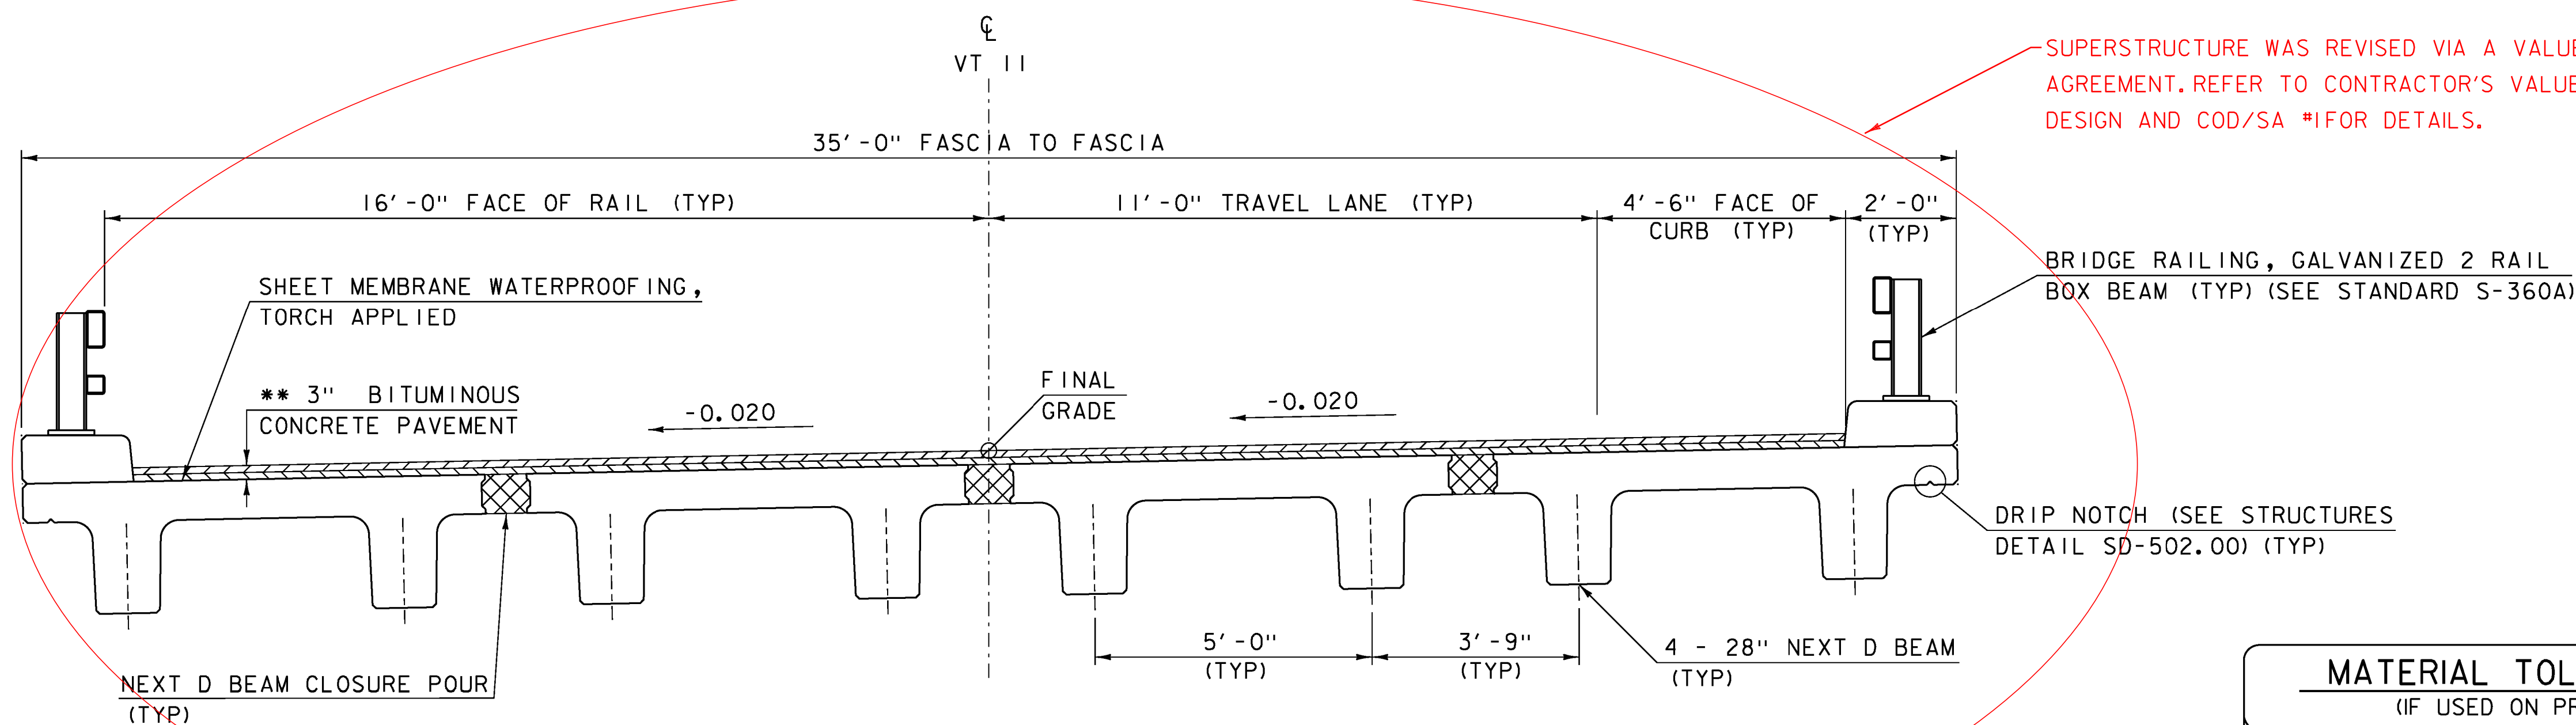

BRIDGE TYPICAL SECTION

SCALE: 1/2" = 1'-0"

MATERIAL TOLERANCES (IF USED ON PROJECT)	
SURFACE	
- PAVEMENT (TOTAL THICKNESS)	+/- 1/4"
- AGGREGATE SURFACE COURSE	+/- 1/2"
SUBBASE	+/- 1"
SAND BORROW	+/- 1"

- \*\* 1 1/2" TYPE IVS BITUMINOUS CONCRETE PAVEMENT
- 1 1/2" TYPE IVS BITUMINOUS CONCRETE PAVEMENT

PROJECT NAME:	ANDOVER	PLOT DATE:	06-JAN-2015
PROJECT NUMBER:	BHF 016-1(29)	DRAWN BY:	S. PIRO
FILE NAME:	sl2bl40+yp.dgn	CHECKED BY:	D. PETERSON
PROJECT LEADER:	C. CARLSON	TYPICAL SECTIONS 1	SHEET 3 OF 48
DESIGNED BY:	D. PETERSON		