


PLAN  
SCALE 1" = 10'-0"

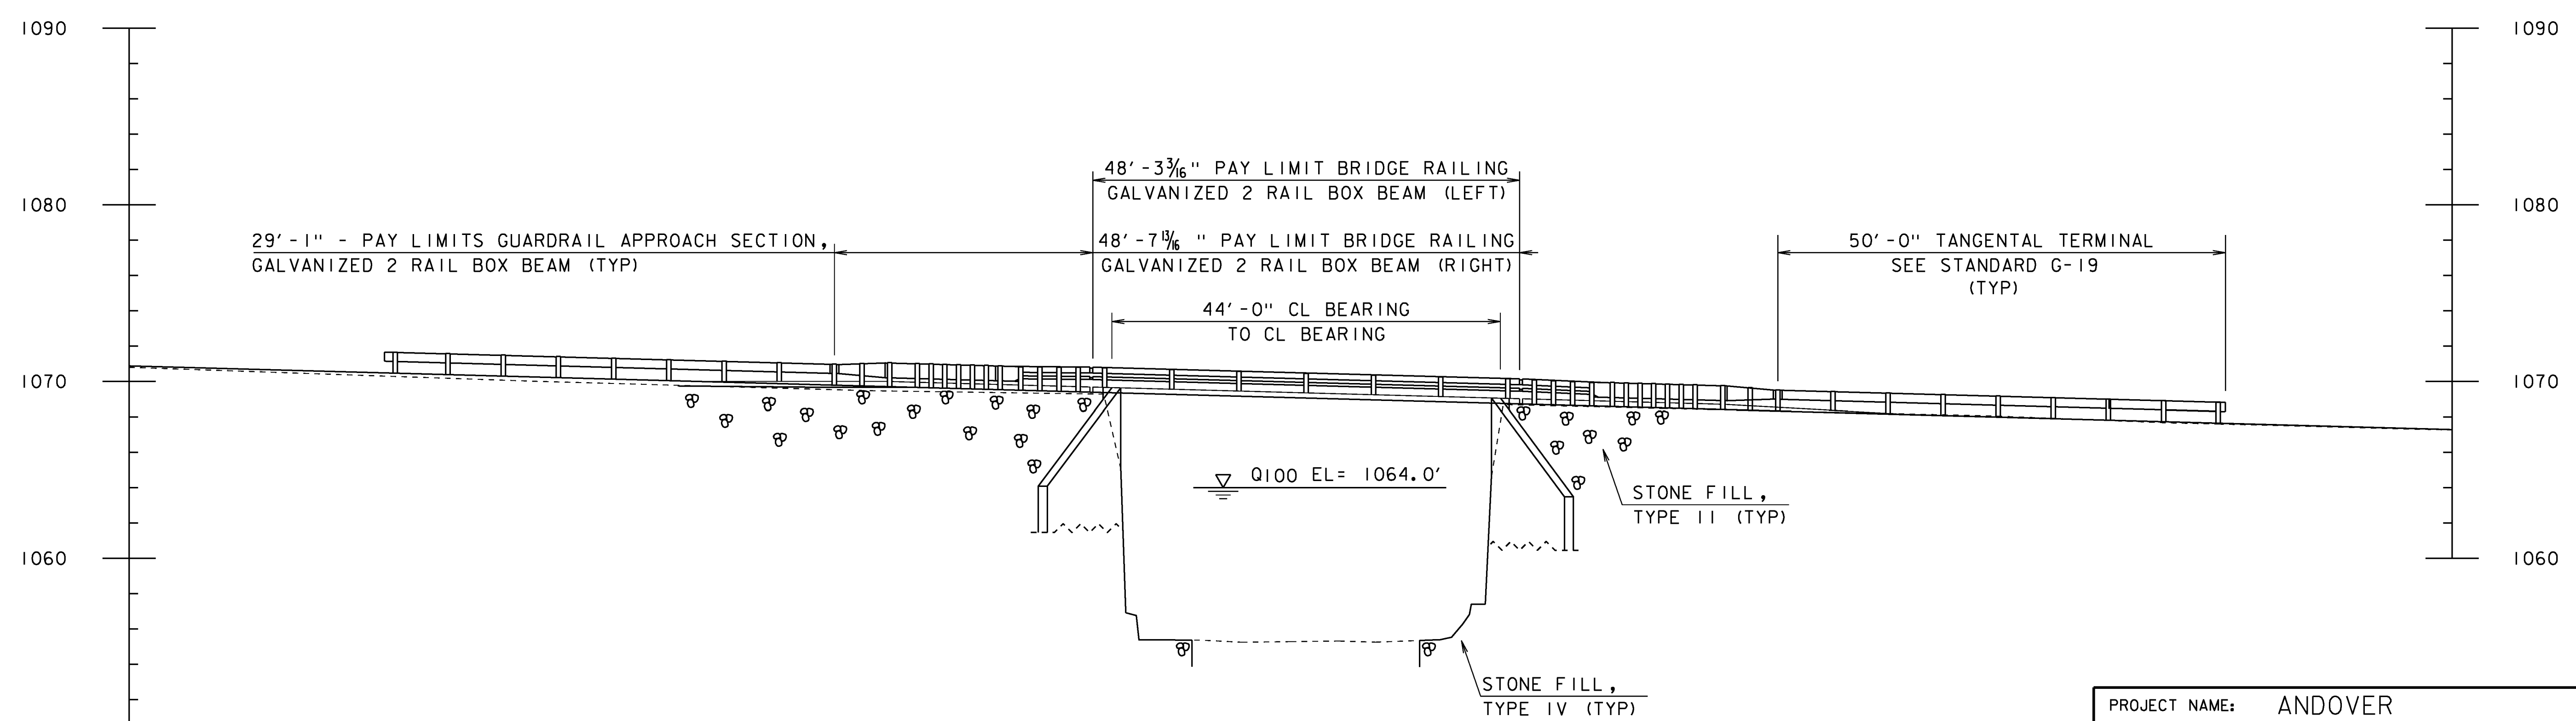

ELEVATION  
SCALE 1" = 10'-0"

PROJECT NAME: ANDOVER	PLOT DATE: 06-JAN-2015
PROJECT NUMBER: BHF 016-1(29)	DRAWN BY: S. PIRO
FILE NAME: sl2b140pe.dgn	CHECKED BY: D. PETERSON
PROJECT LEADER: C. CARLSON	SHEET 19 OF 48
DESIGNED BY: D. PETERSON	
PLAN AND ELEVATION	