


ABUTMENT NO. 1 PLAN
SCALE 3/8" = 1'-0"

Vermont Agency of Transportation
RECEIVED
ON: June 24, 2015
and Checked for
CONFORMANCE
BY: D. PETERSON DATE: 06/25/2015

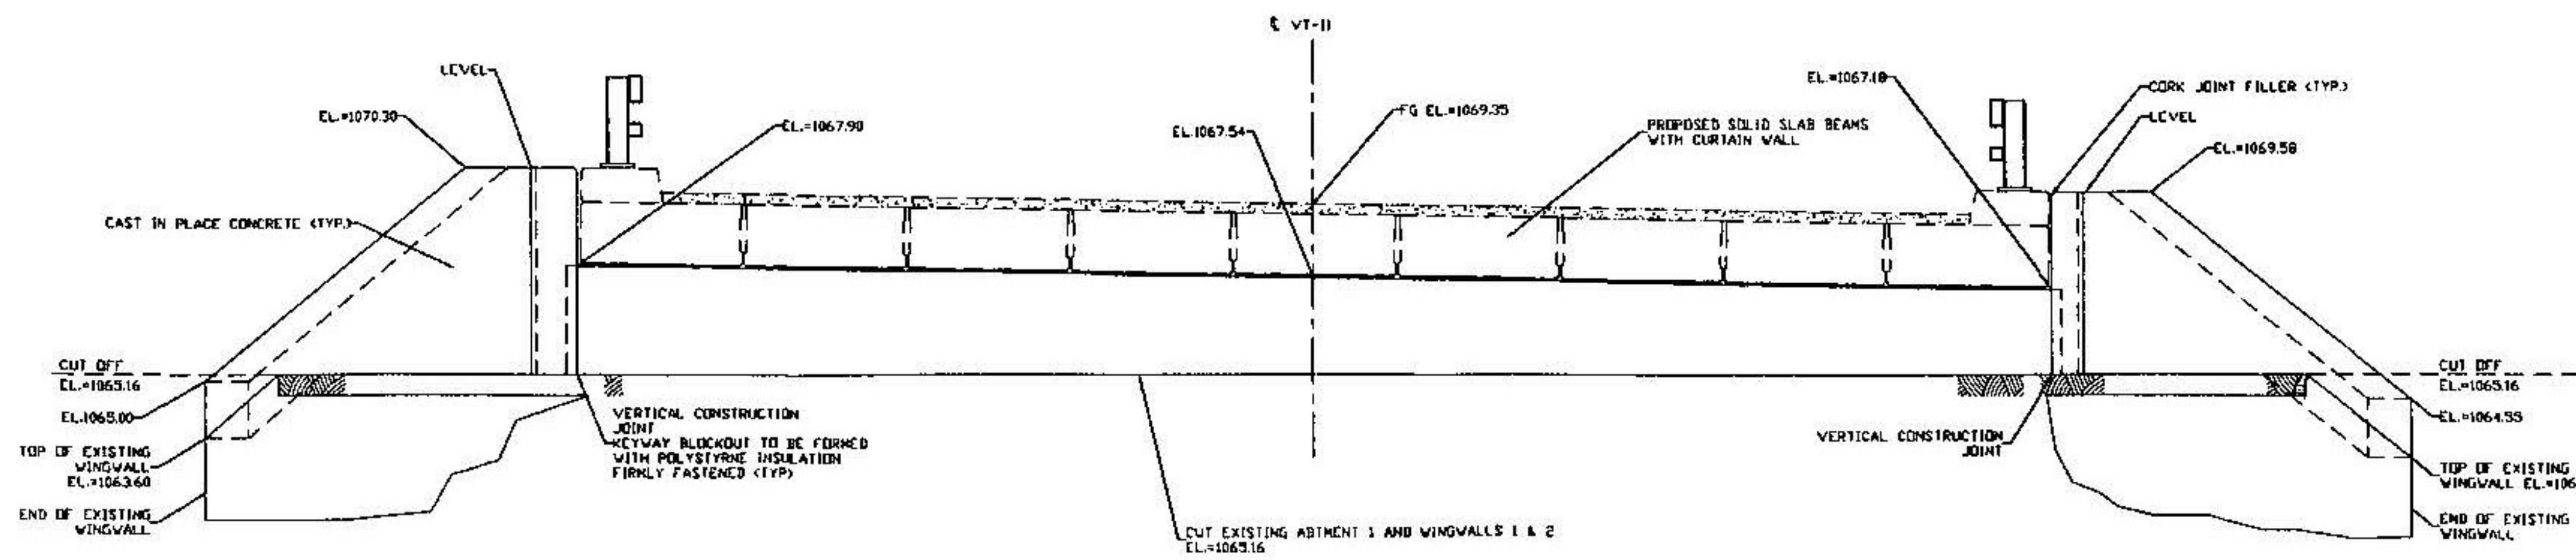

ABUTMENT NO. 1 ELEVATION
SCALE 3/8" = 1'-0"

NOTE:
NF = NEAR FACE
FF = FAR FACE
EF = EACH FACE
▲ = CUT TO FIT IN FIELD
3" CLEAR, UNLESS OTHERWISE SPECIFIED ON THE PLANS.
2'-2" BAR LAP UNLESS OTHERWISE SPECIFIED ON THE PLANS.
SECTION OF EXISTING ABUTMENT AND WINGWALLS TO BE CUT.

REV. NO.	DATE
1	06/24/15

RENAUD BROS. INC.
205 FT. BRIDGEWAY RD. VERMONT, VT. 05254
PH. (802) 257-7289 FAX (802) 257-7308

SHEET NAME: ABUTMENT 1 PLAN AND ELEVATION	
PROJECT NAME: ANDOVER	SHEET NO. 1
PROJECT NO.: BHF 016-1 (29)	OF 7
DRAWN BY: CE	CHK'D BY: DATE: 06/03/2015