


**ABUTMENT NO. 2 PLAN**  
 SCALE 3/8" = 1'-0"

Vermont Agency of Transportation  
**RECEIVED**  
 ON: June 24, 2015  
 and Checked for  
**CONFORMANCE**  
 BY: D. PETERSON DATE: 06/25/2015

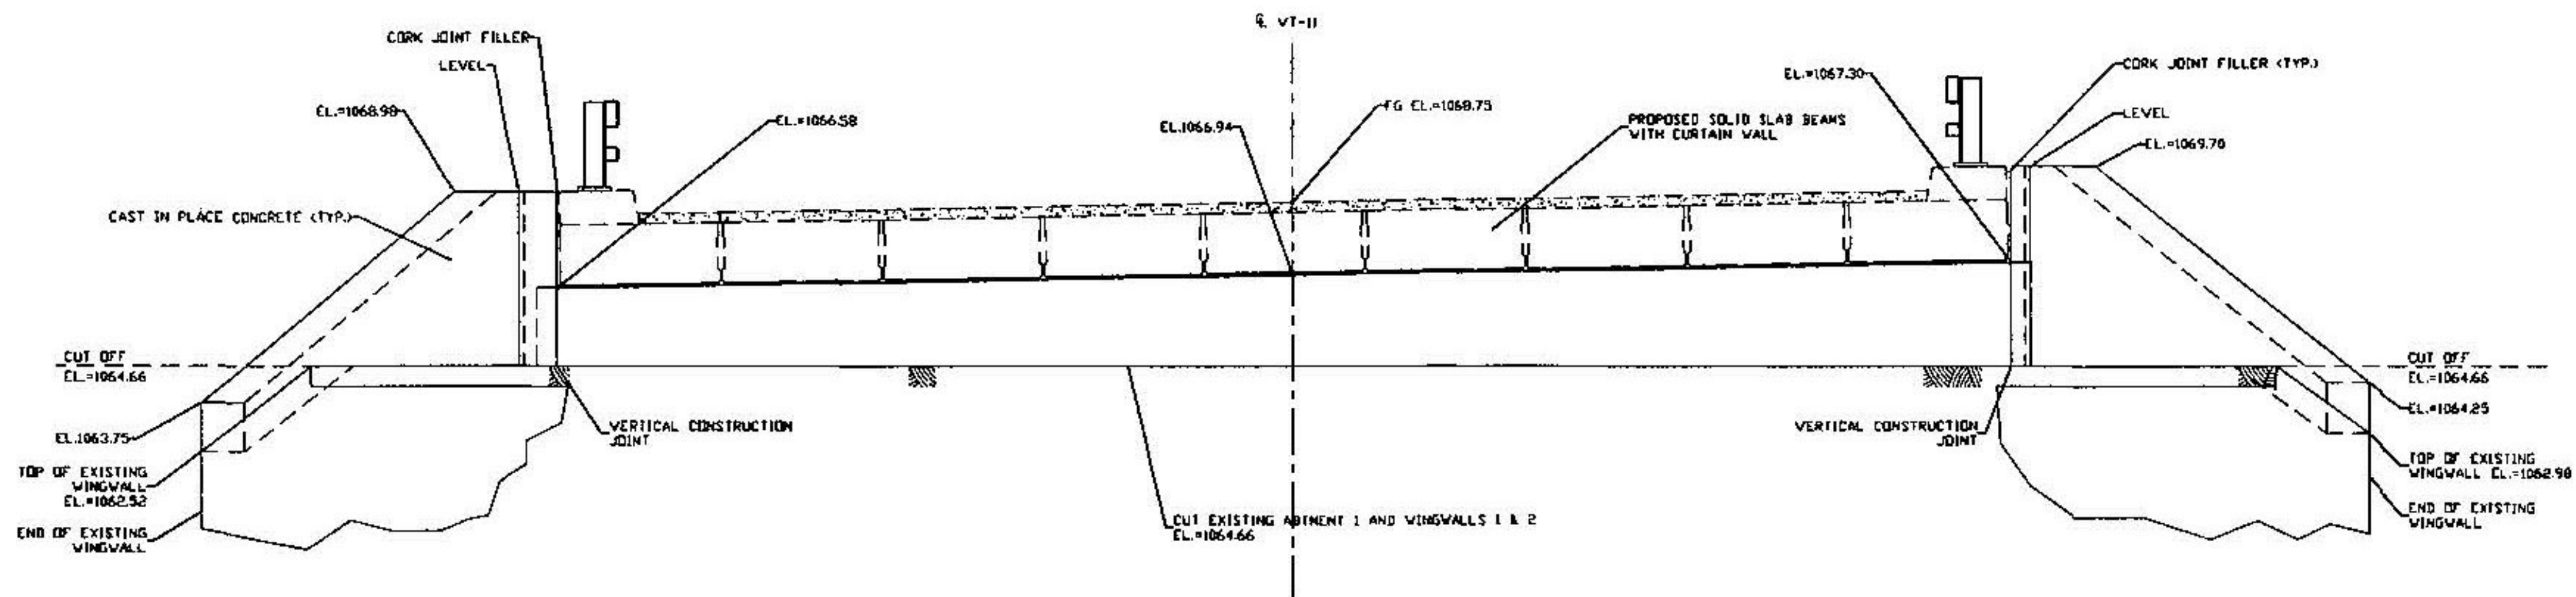

**ABUTMENT NO. 2 ELEVATION**  
 SCALE 3/8" = 1'-0"

**NOTE:**  
 NF = NEAR FACE  
 FF = FAR FACE  
 EF = EACH FACE  
 ▲ = CUT TO FIT IN FIELD  
 3" CLEAR, UNLESS OTHERWISE SPECIFIED ON THE PLANS.  
 2'-2" BAR LAP UNLESS OTHERWISE SPECIFIED ON THE PLANS.  
 SECTION OF EXISTING ABUTMENT AND WINGWALLS TO BE CUT.

REV. NO.		DATE		SHEET NAME: <b>ABUTMENT 2 PLAN AND ELEVATION</b>	
1		08/24/15		PROJECT NAME: <b>ANDOVER</b>	
				PROJECT NO.: <b>BHF 016-1 (29)</b>	
				DRAWN BY: <b>CE</b>	
				CHK'D BY: <b></b>	
				DATE: <b>06/03/2015</b>	
				SHEET NO. <b>4</b>	
				OF <b>7</b>	

