

ABUTMENT NO. 2 BELOW BRIDGE SEAT REINFORCING LAYOUT

SCALE 3/8" = 1'-0"

Vermont Agency of Transportation


RECEIVED

ON: June 24, 2015

and Checked for

CONFORMANCE

BY: D. PETERSON DATE: 06/25/2015

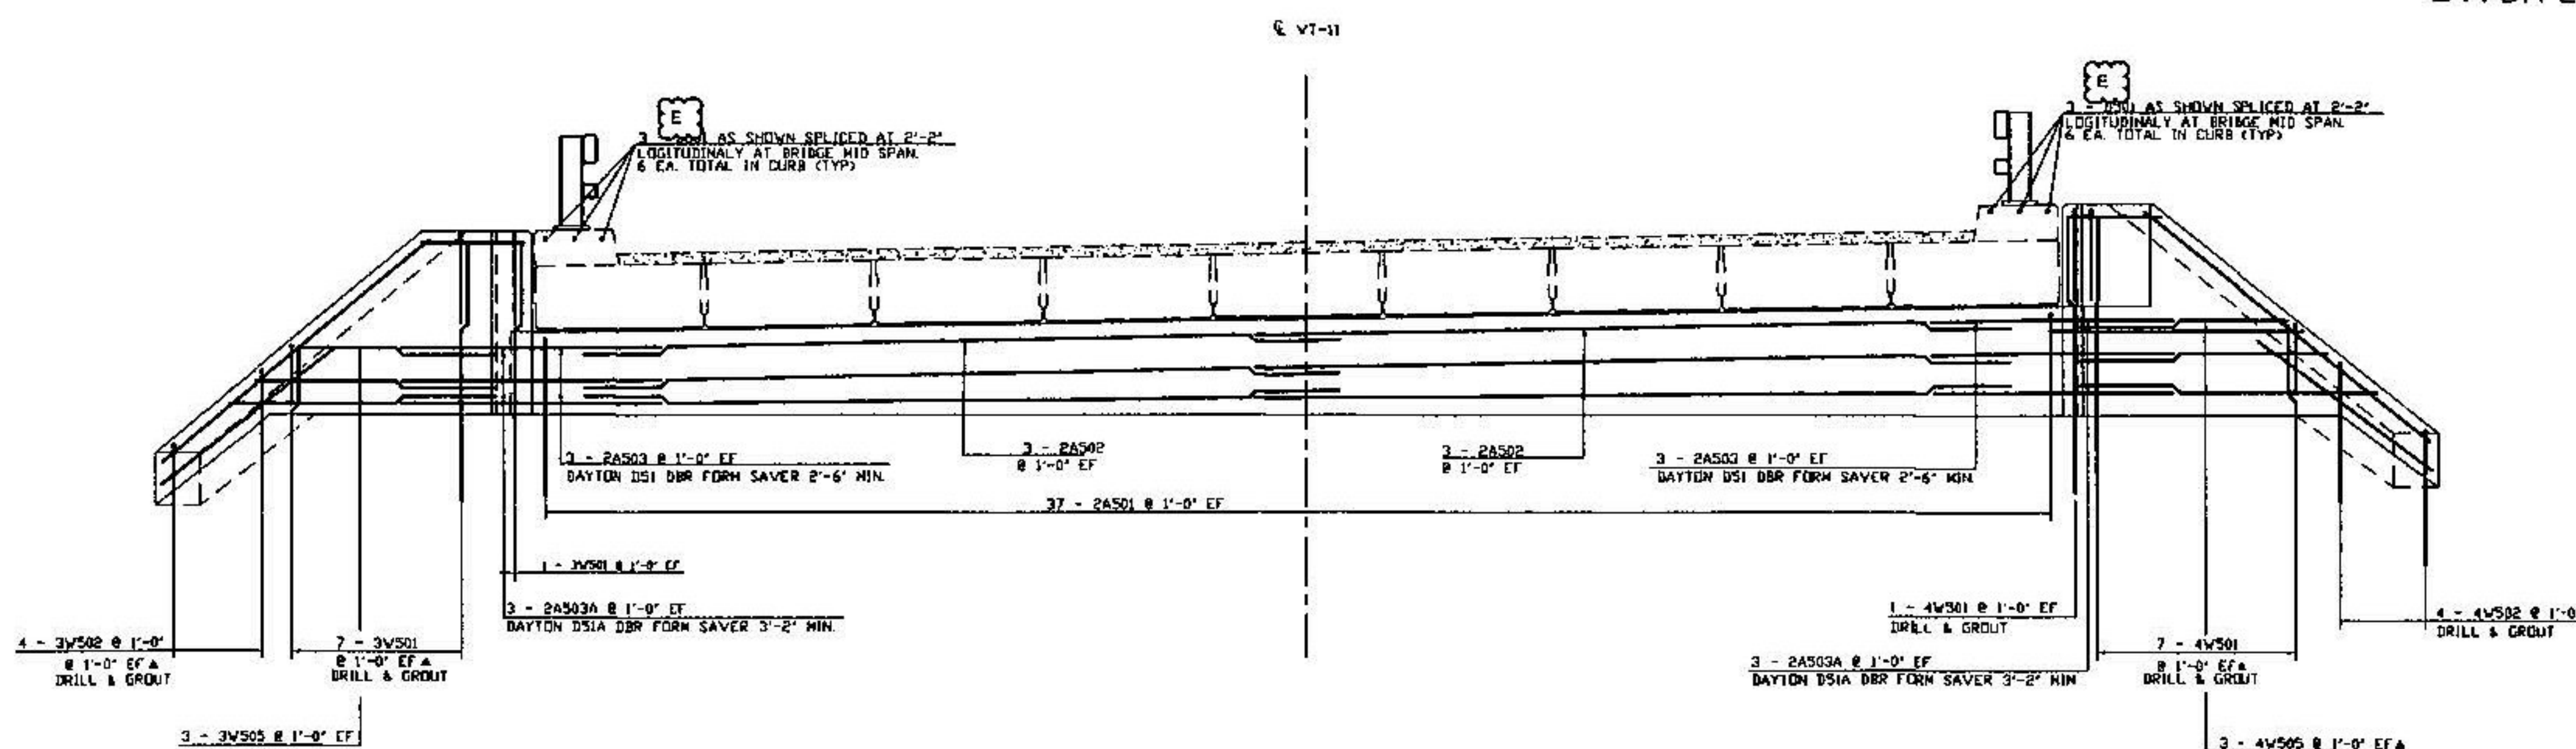

ABUTMENT NO. 2 REINFORCING ELEVATION

SCALE 3/8" = 1'-0"

NOTE:

- NF = NEAR FACE
- FF = FAR FACE
- EF = EACH FACE
- ▲ = CUT TO FIT IN FIELD
- 3" CLEAR, UNLESS OTHERWISE SPECIFIED ON THE PLANS.
- 2'-2" BAR LAP UNLESS OTHERWISE SPECIFIED ON THE PLANS.

DRILL AND GROUT ABUTMENT AS SHOWN IN THE "ABUTMENT TYPICAL" ON "ABUTMENT 1 REINFORCING" SHEET

DRILL AND GROUT WINGWALLS AS SHOWN IN THE "WINGWALL TYPICAL" ON "WINGWALL 1 & 2 REINFORCING" SHEET

REV. NO.	DATE:
1	06/24/15

RENAUD BROS. INC.
 200 FT. RIDGEMAN BL. VERMONT, 05254
 PH (802) 257-7585 FAX (802) 257-7508

SHEET NAME: ABUTMENT 2 REINFORCING		SHEET NO. 5
PROJECT NAME: ANDOVER		
PROJECT NO: BHF 016-1 (29)		OF 7
DRAWN BY: CE	CHK'D BY: CE	
DATE: 06/03/2015		