



STA 11+45.00 LT & 11+40.00 RT
 BEGIN STONE FILL, TYPE 11
 GEOTEXTILE UNDER STONE FILL
 GRUBBING MATERIAL

11+50


END APPROACH
 BEGIN PROJECT

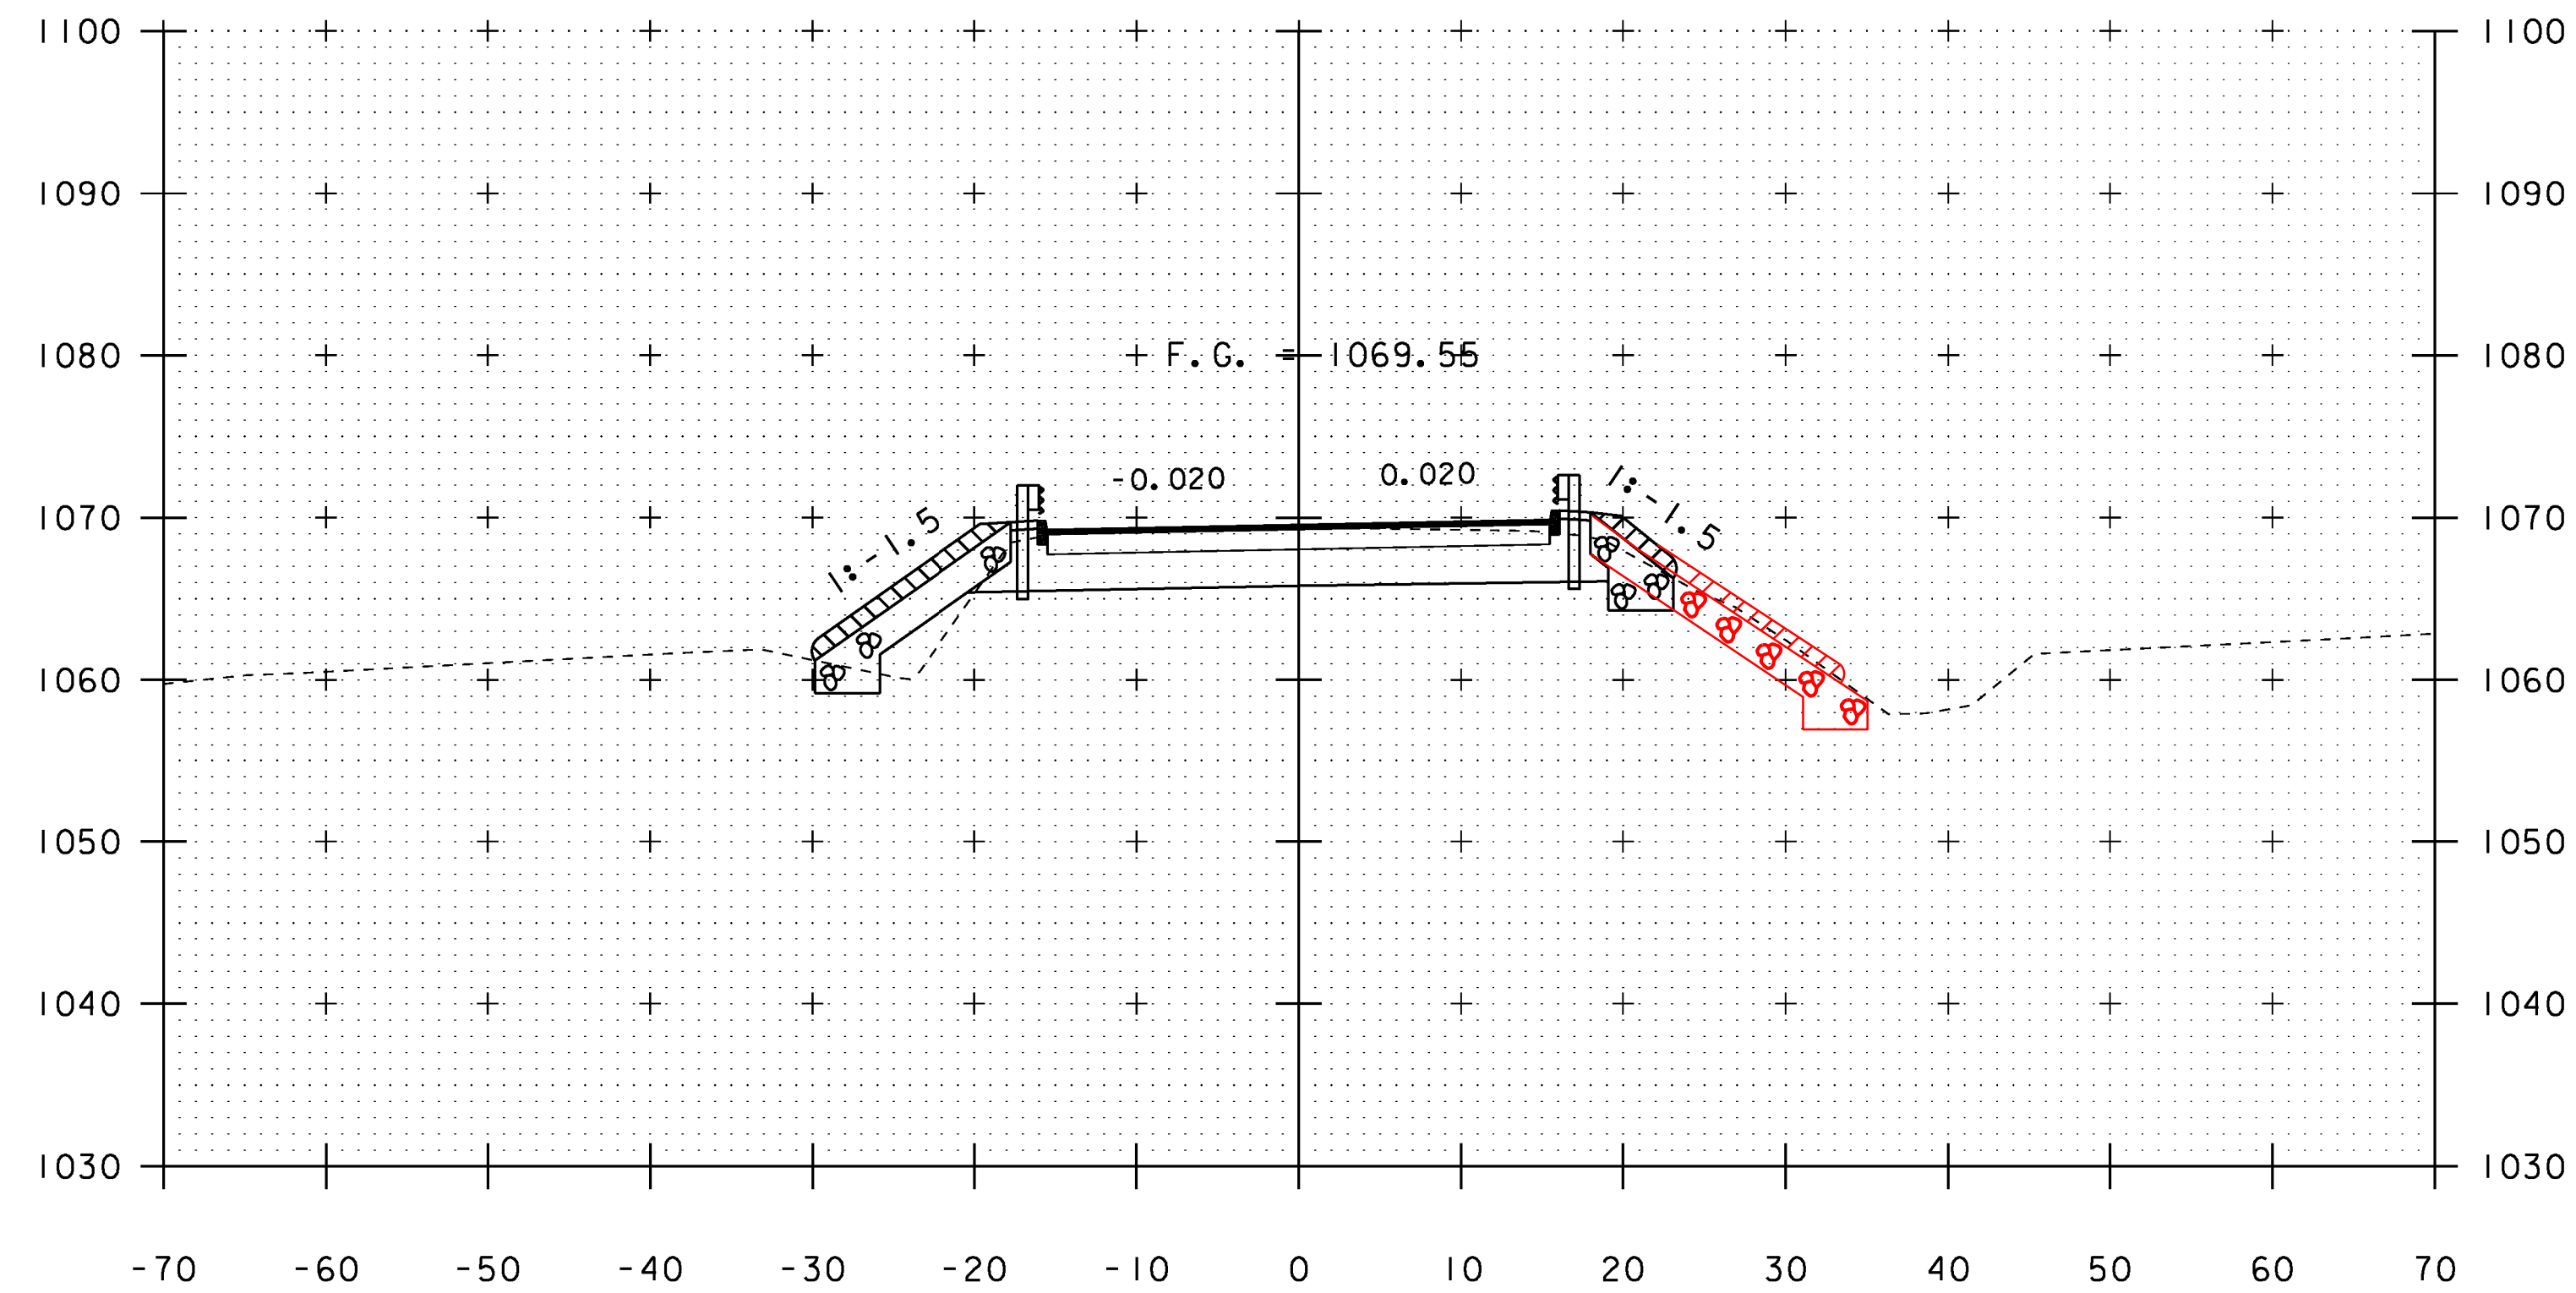

11+75

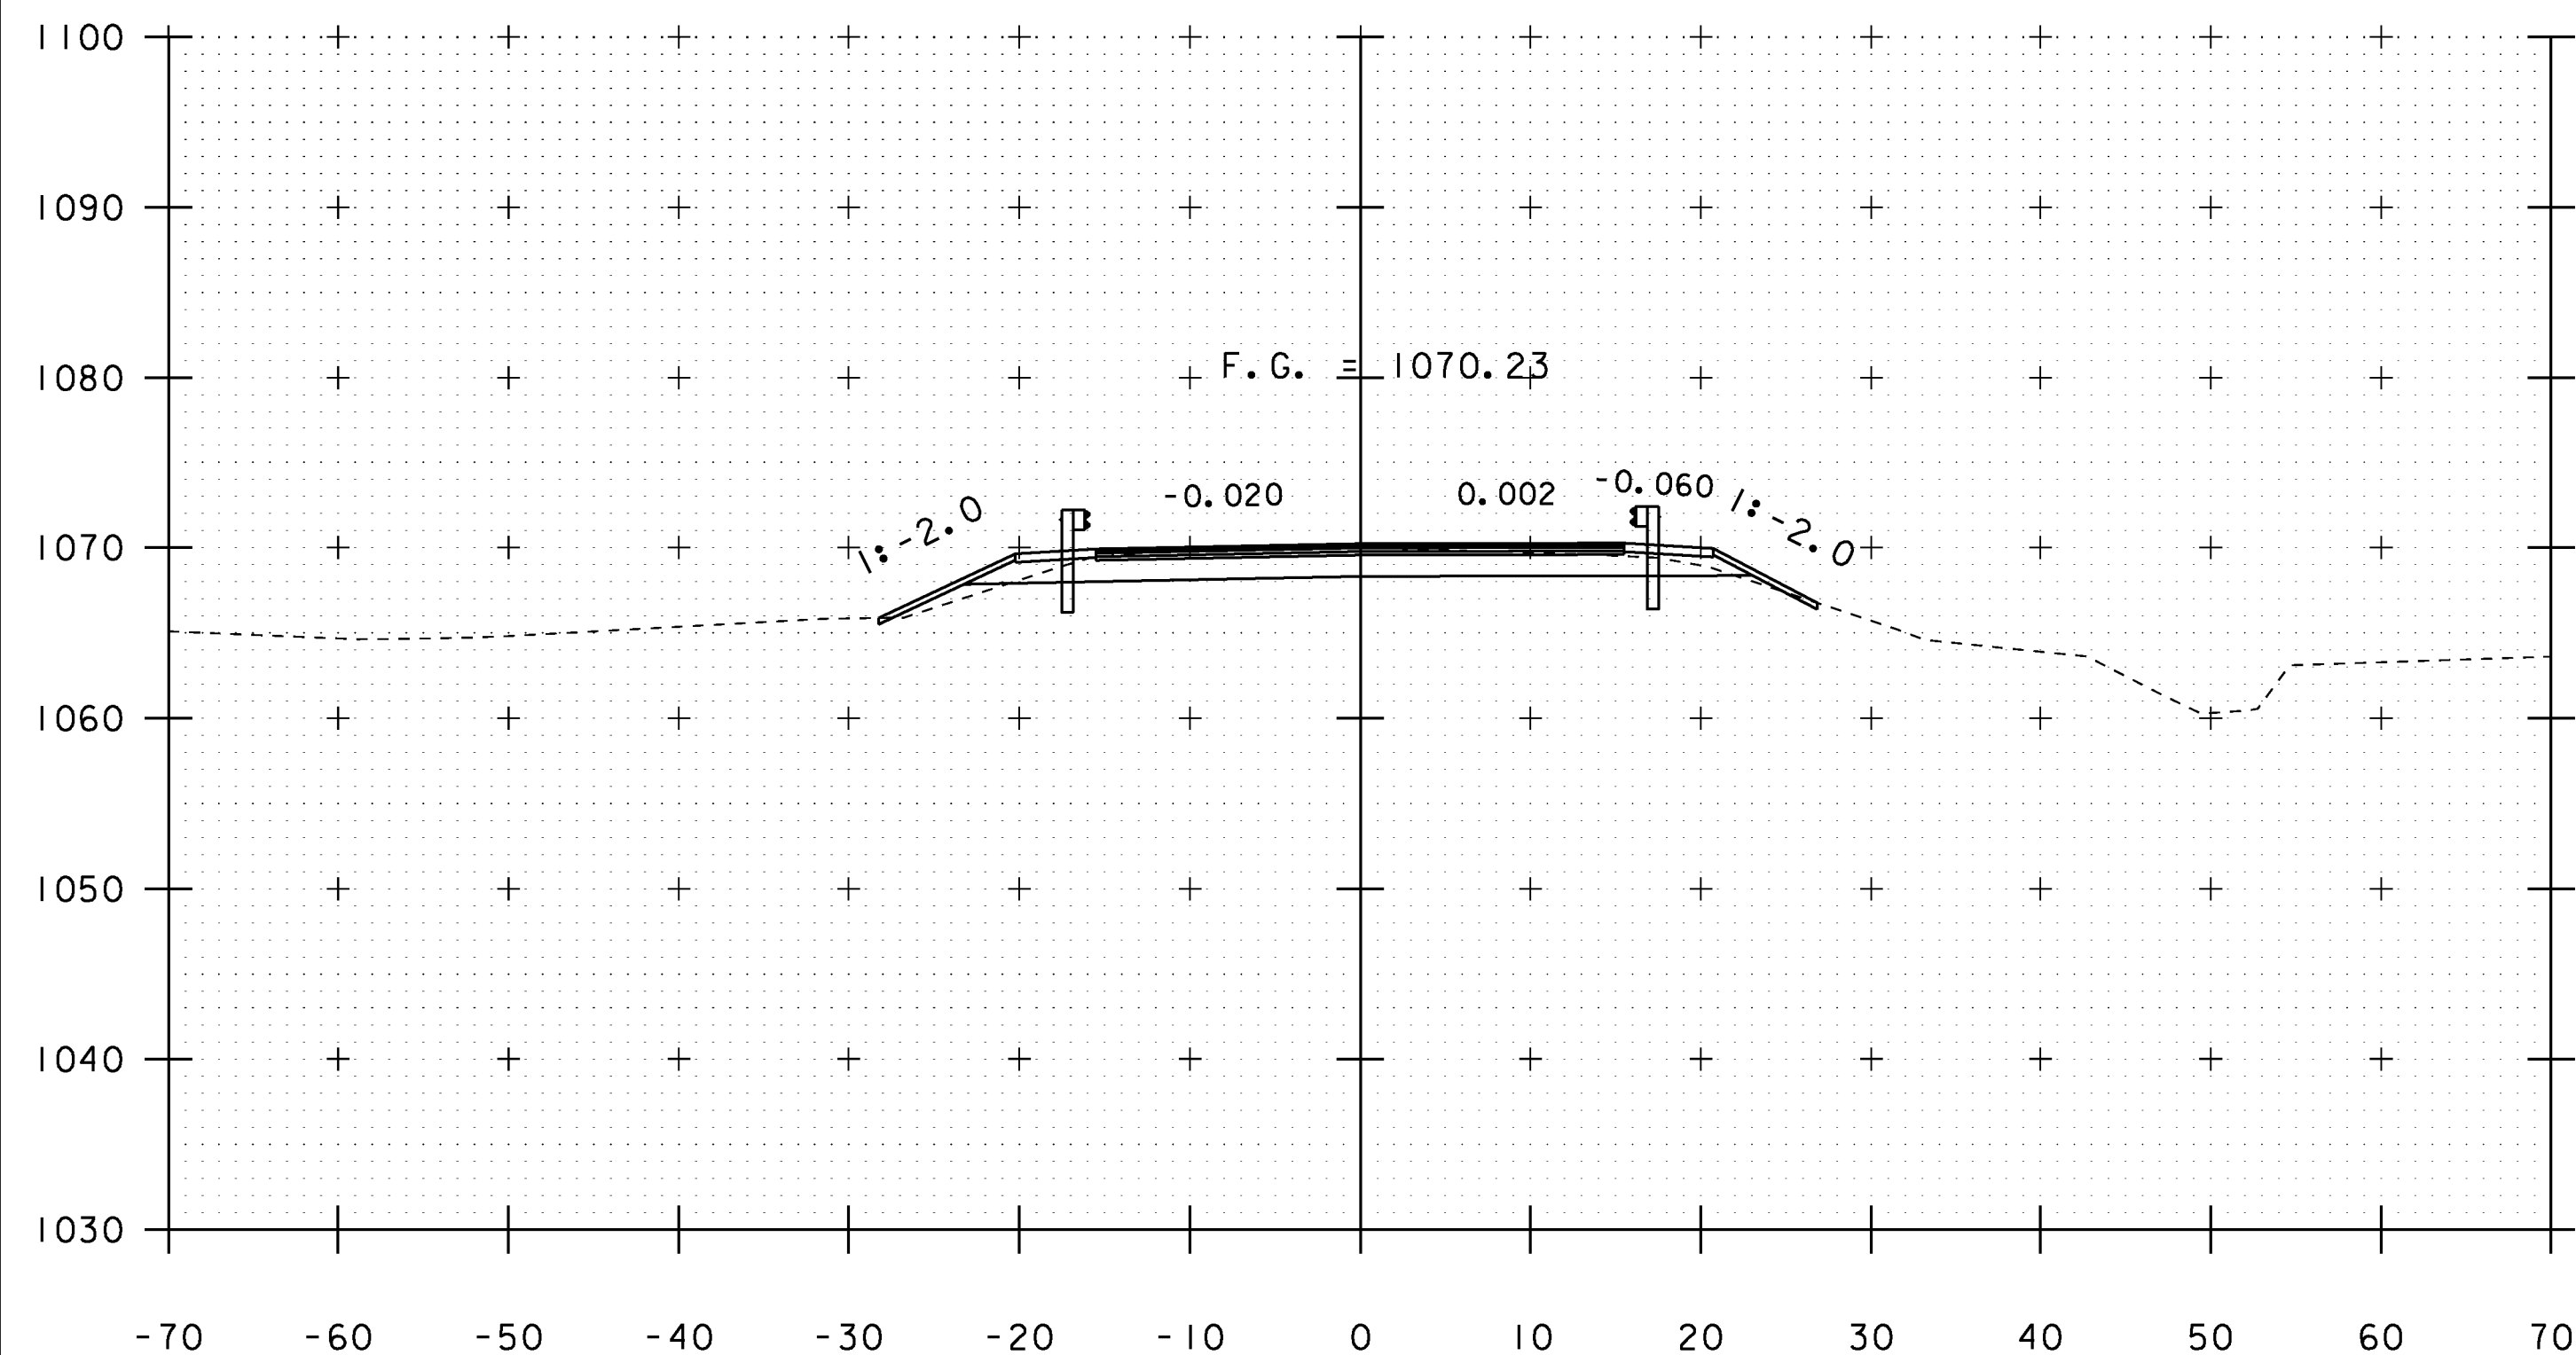

11+25

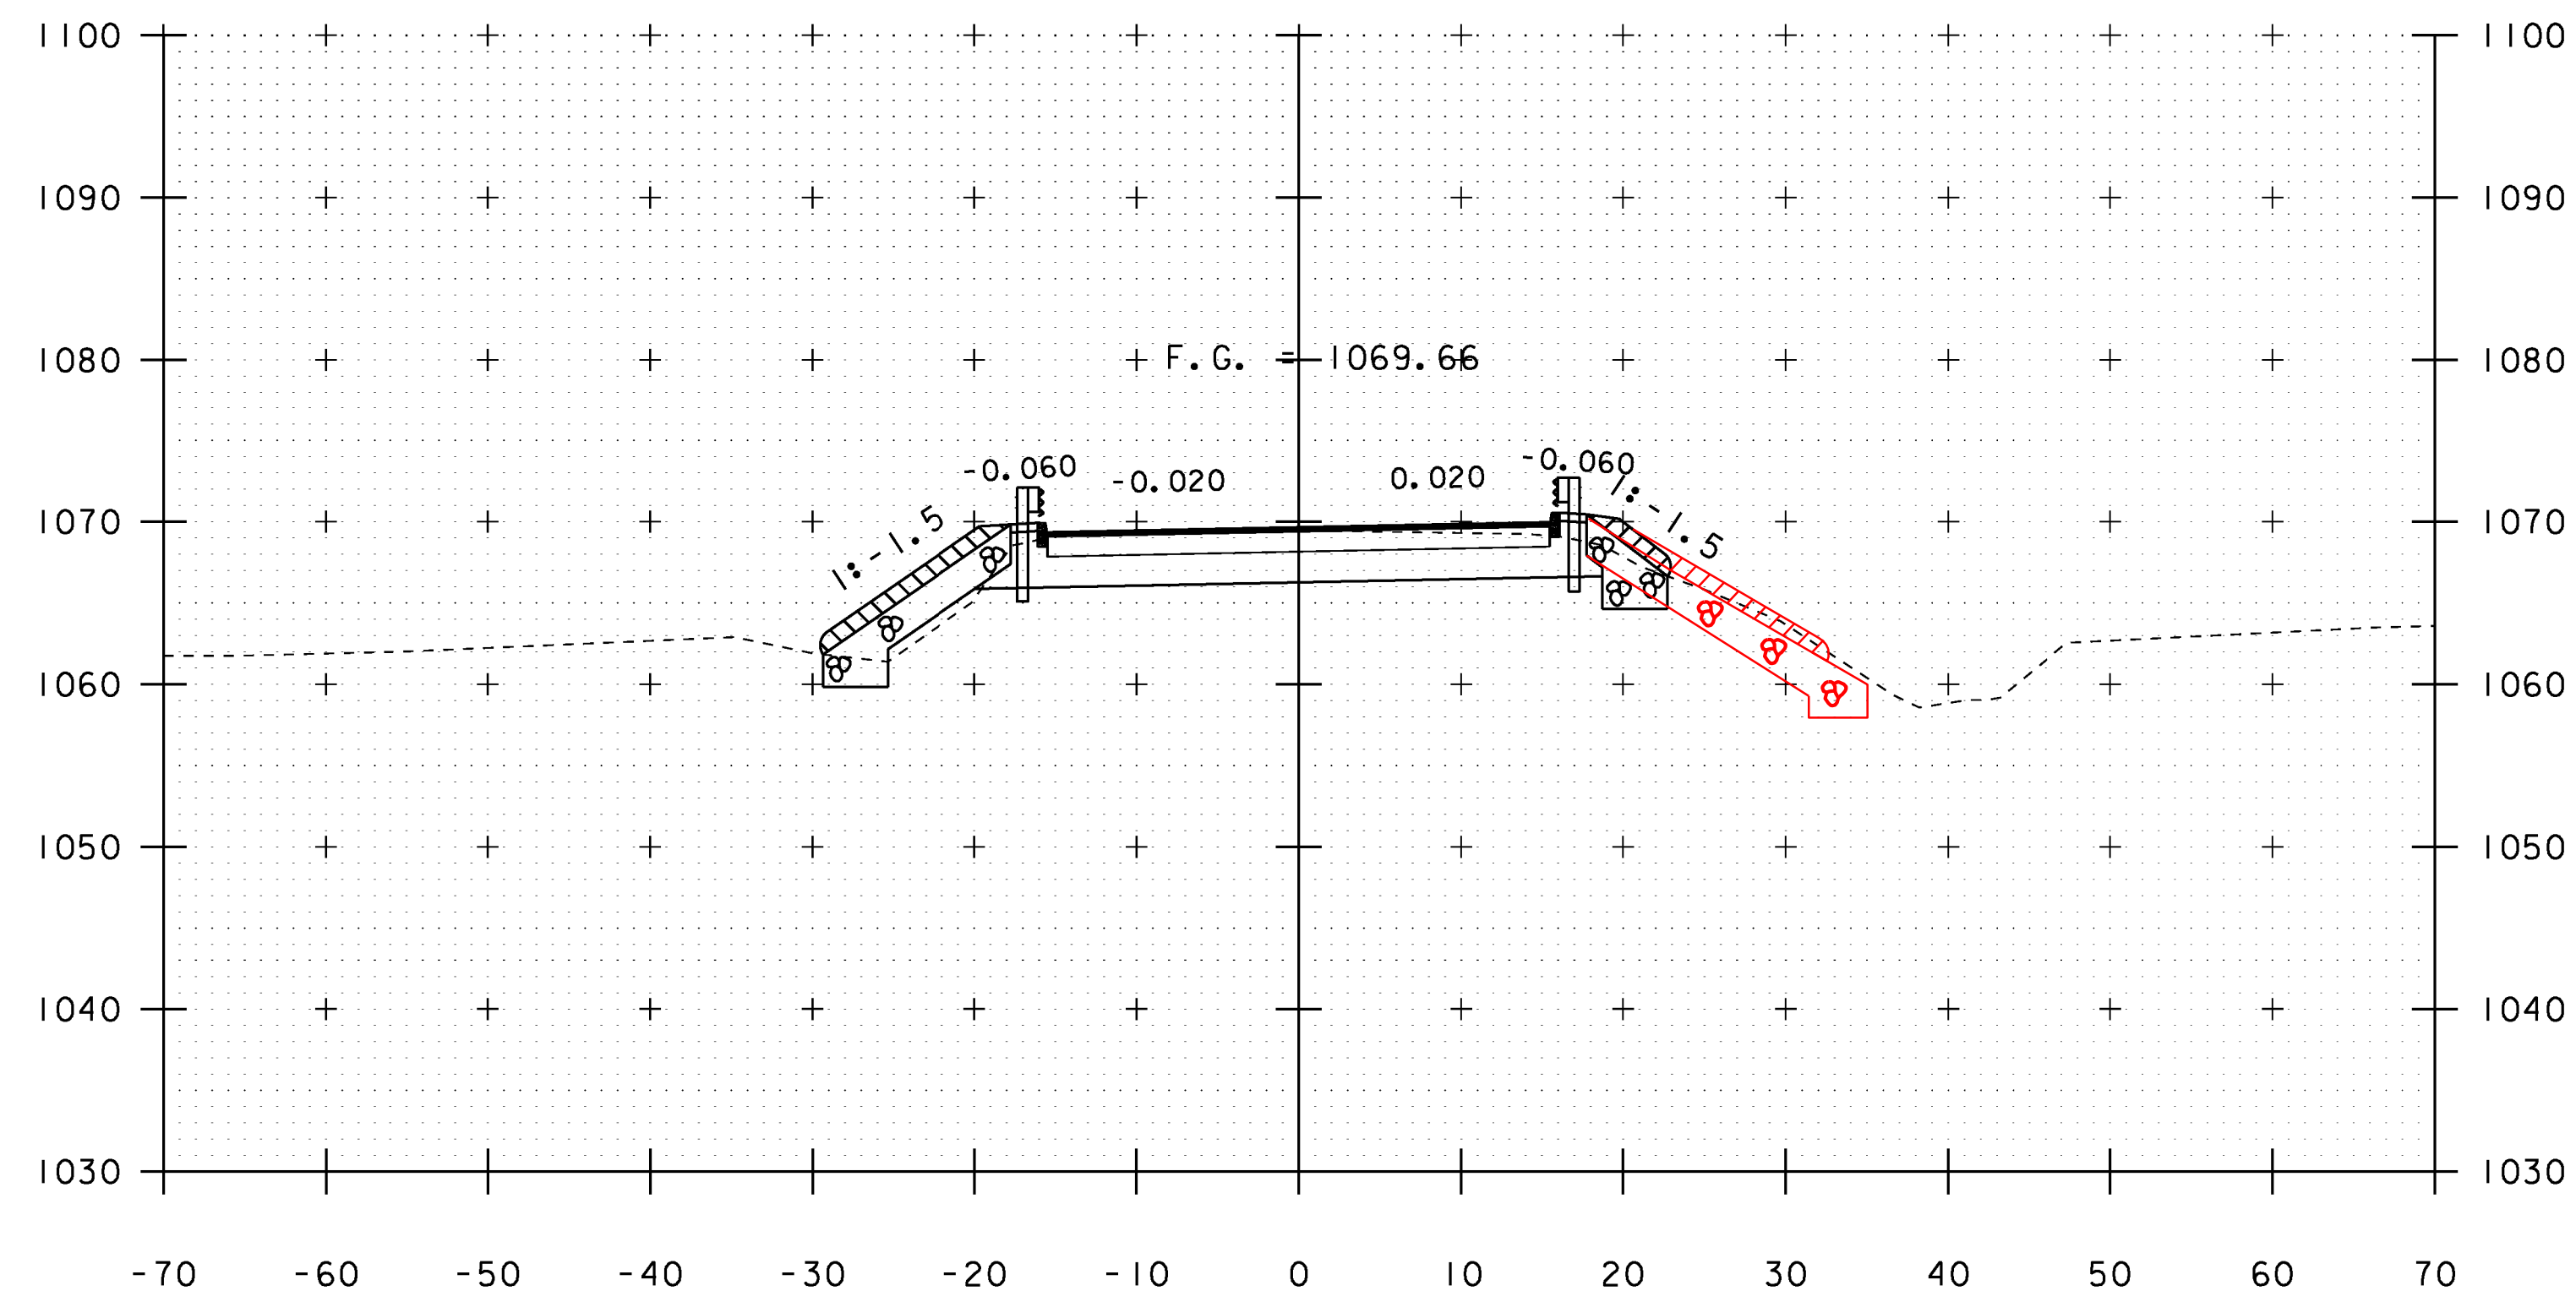

11+66.75

PROJECT NAME:	ANDOVER	PLOT DATE:	06-JAN-2015
PROJECT NUMBER:	BHF 016-1(29)	DRAWN BY:	S. PIRO
FILE NAME:	sl2bl40xs.dgn	CHECKED BY:	D. PETERSON
PROJECT LEADER:	C. CARLSON	SHEET	35 OF 48
DESIGNED BY:	D. PETERSON		
VT 11 CROSS SECTIONS 2			

STA. 11+25 TO STA. 11+75