



13+50

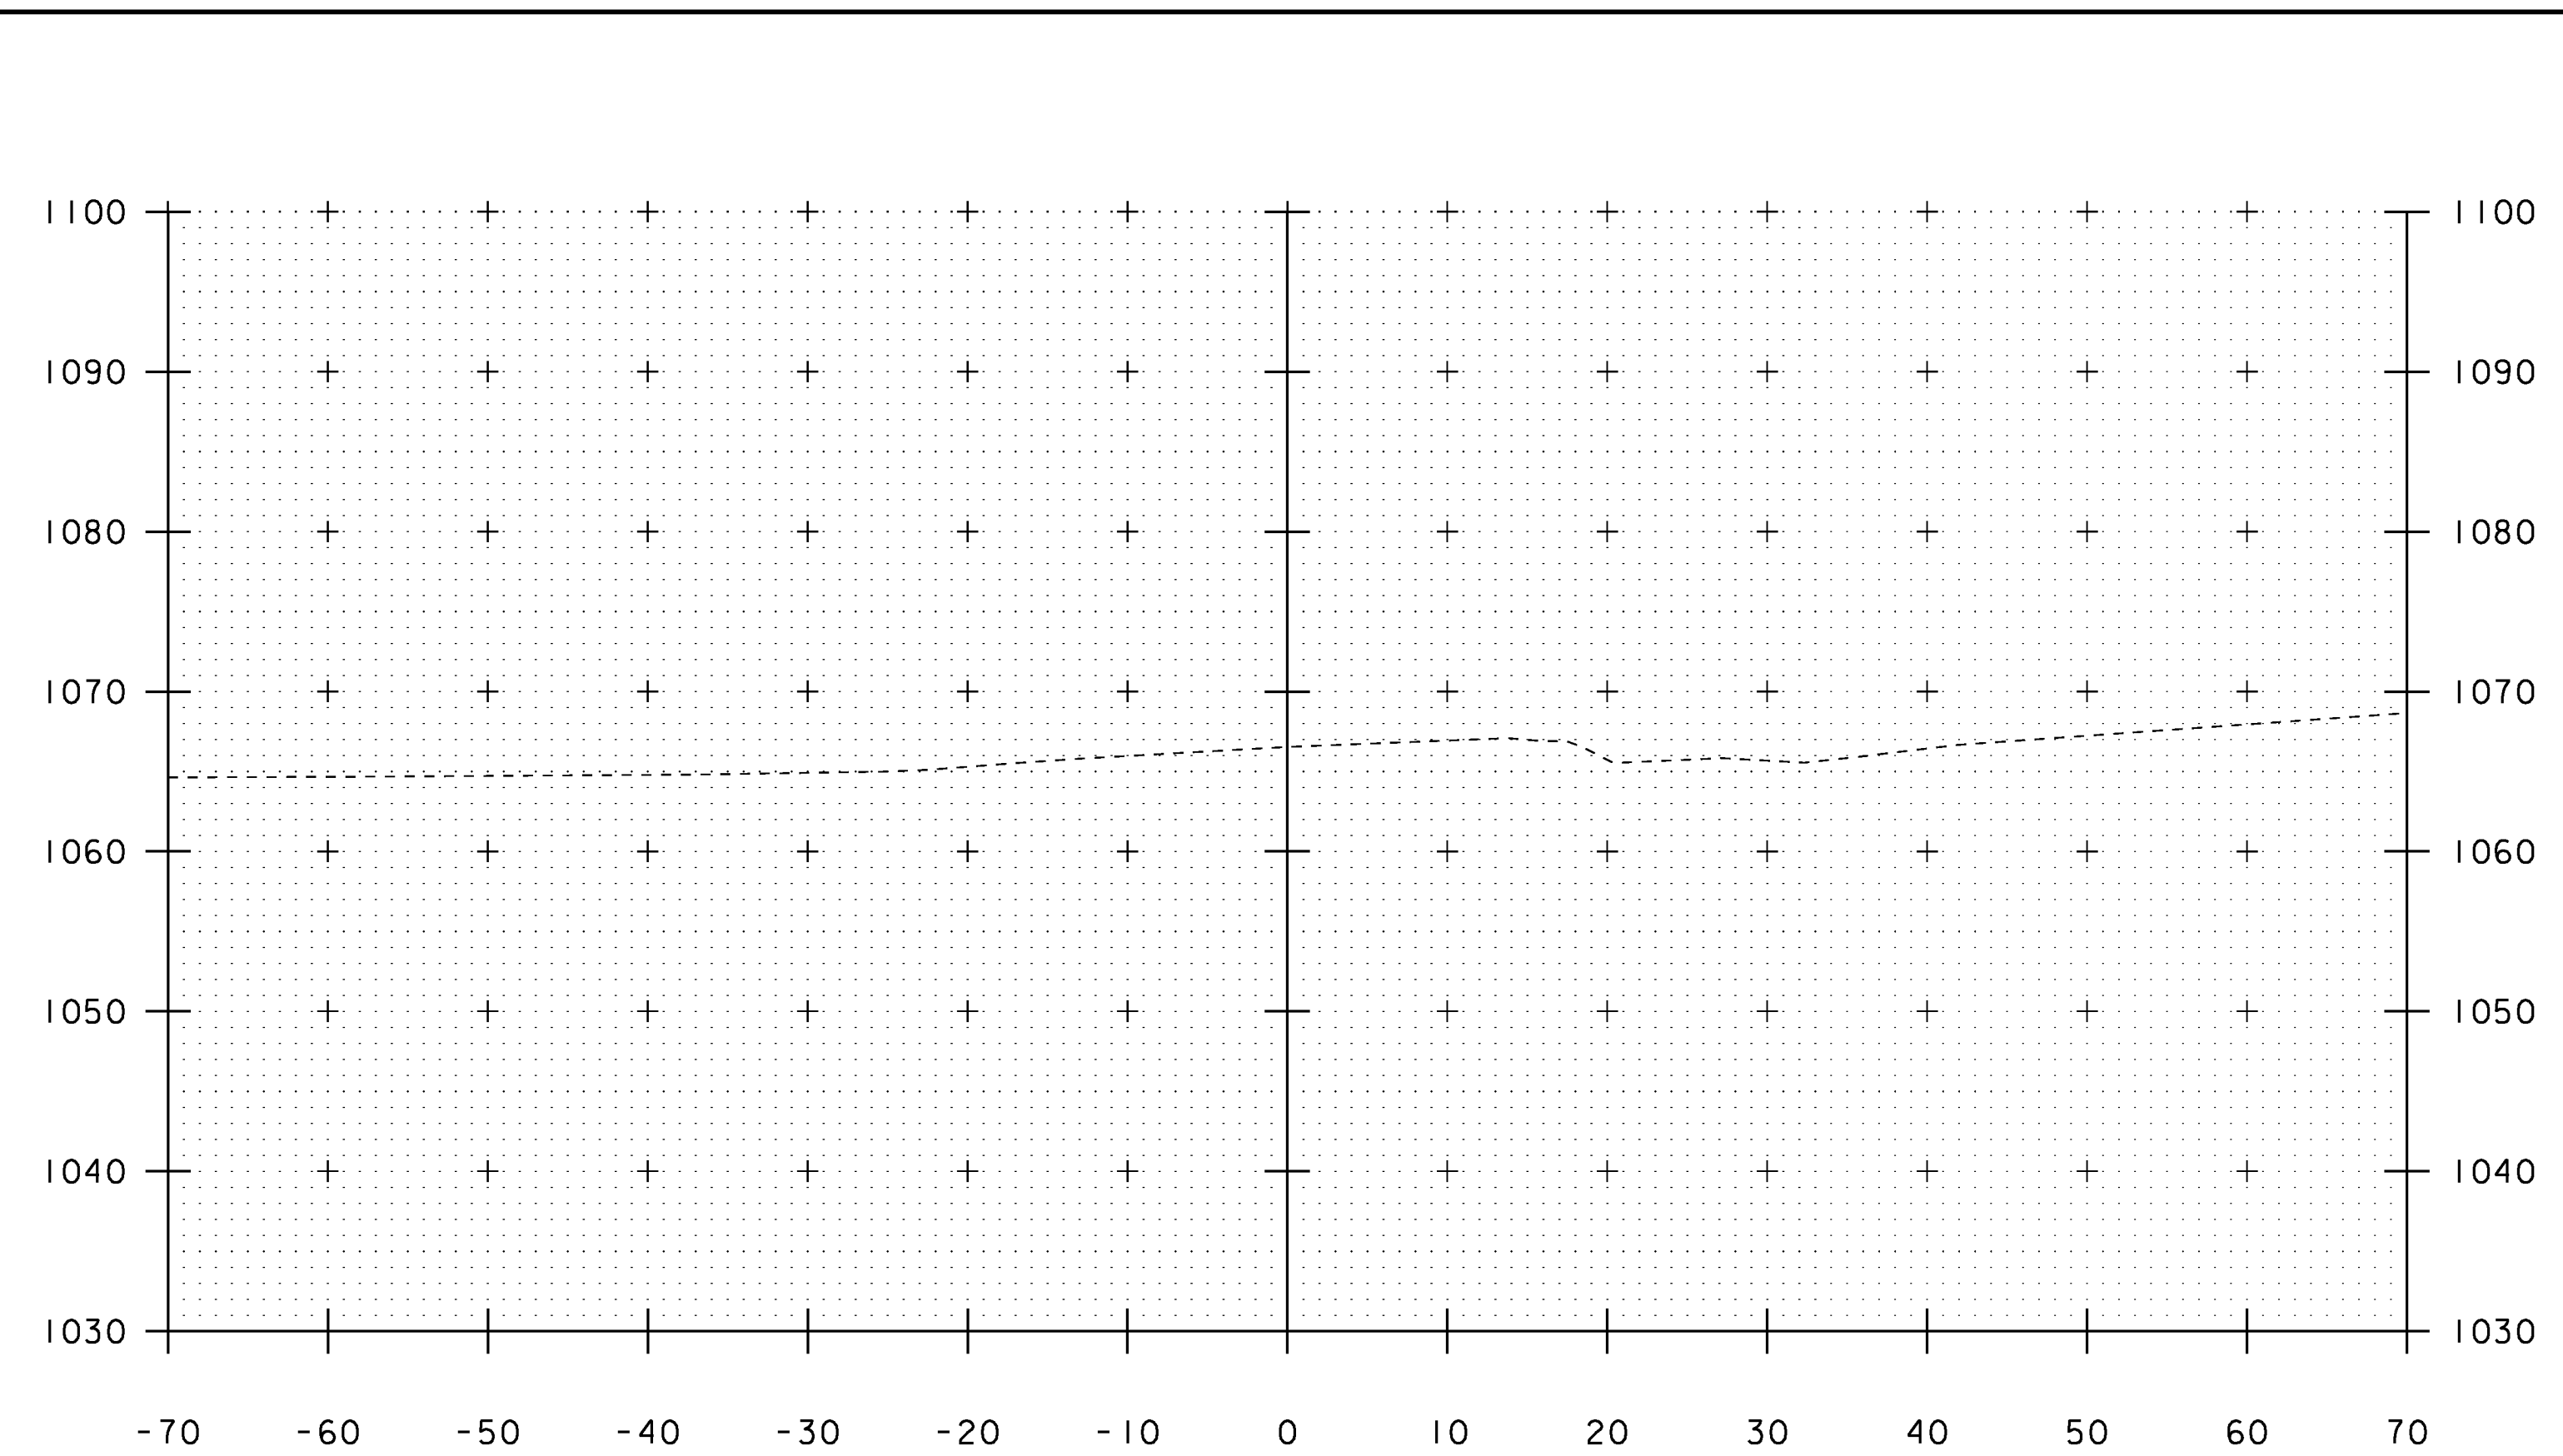


14+00

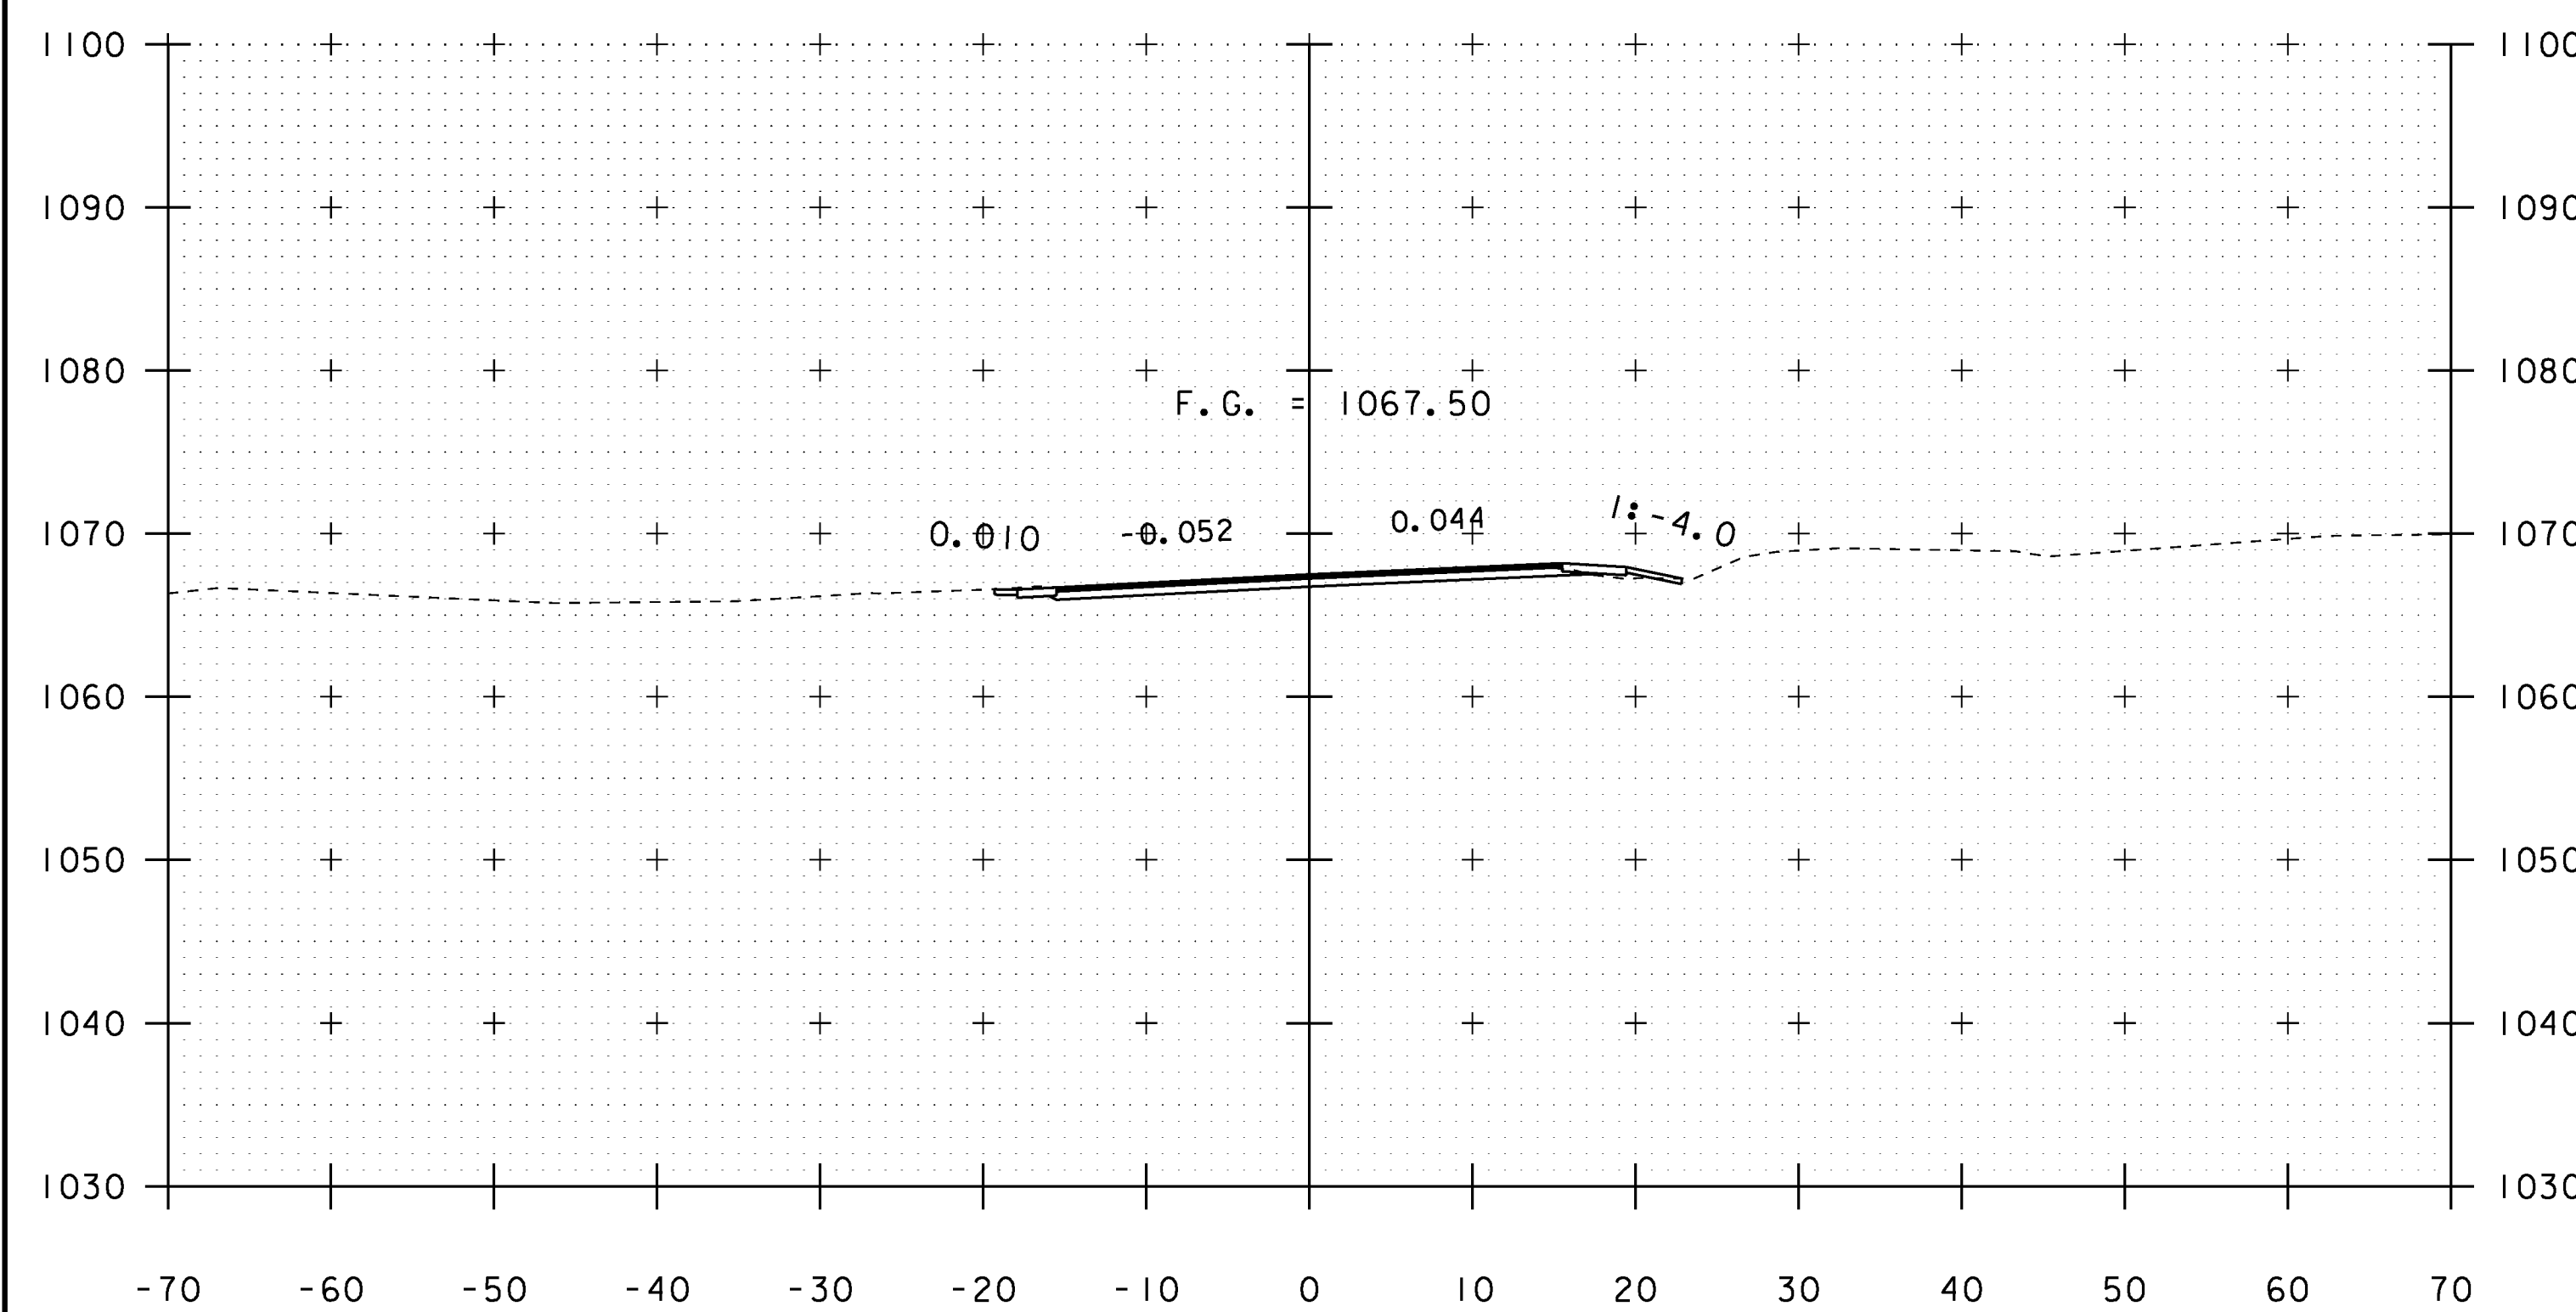

STA 13+25.00 RT - STA 13+75.00 RT  
CONSTRUCT DRIVE

13+25

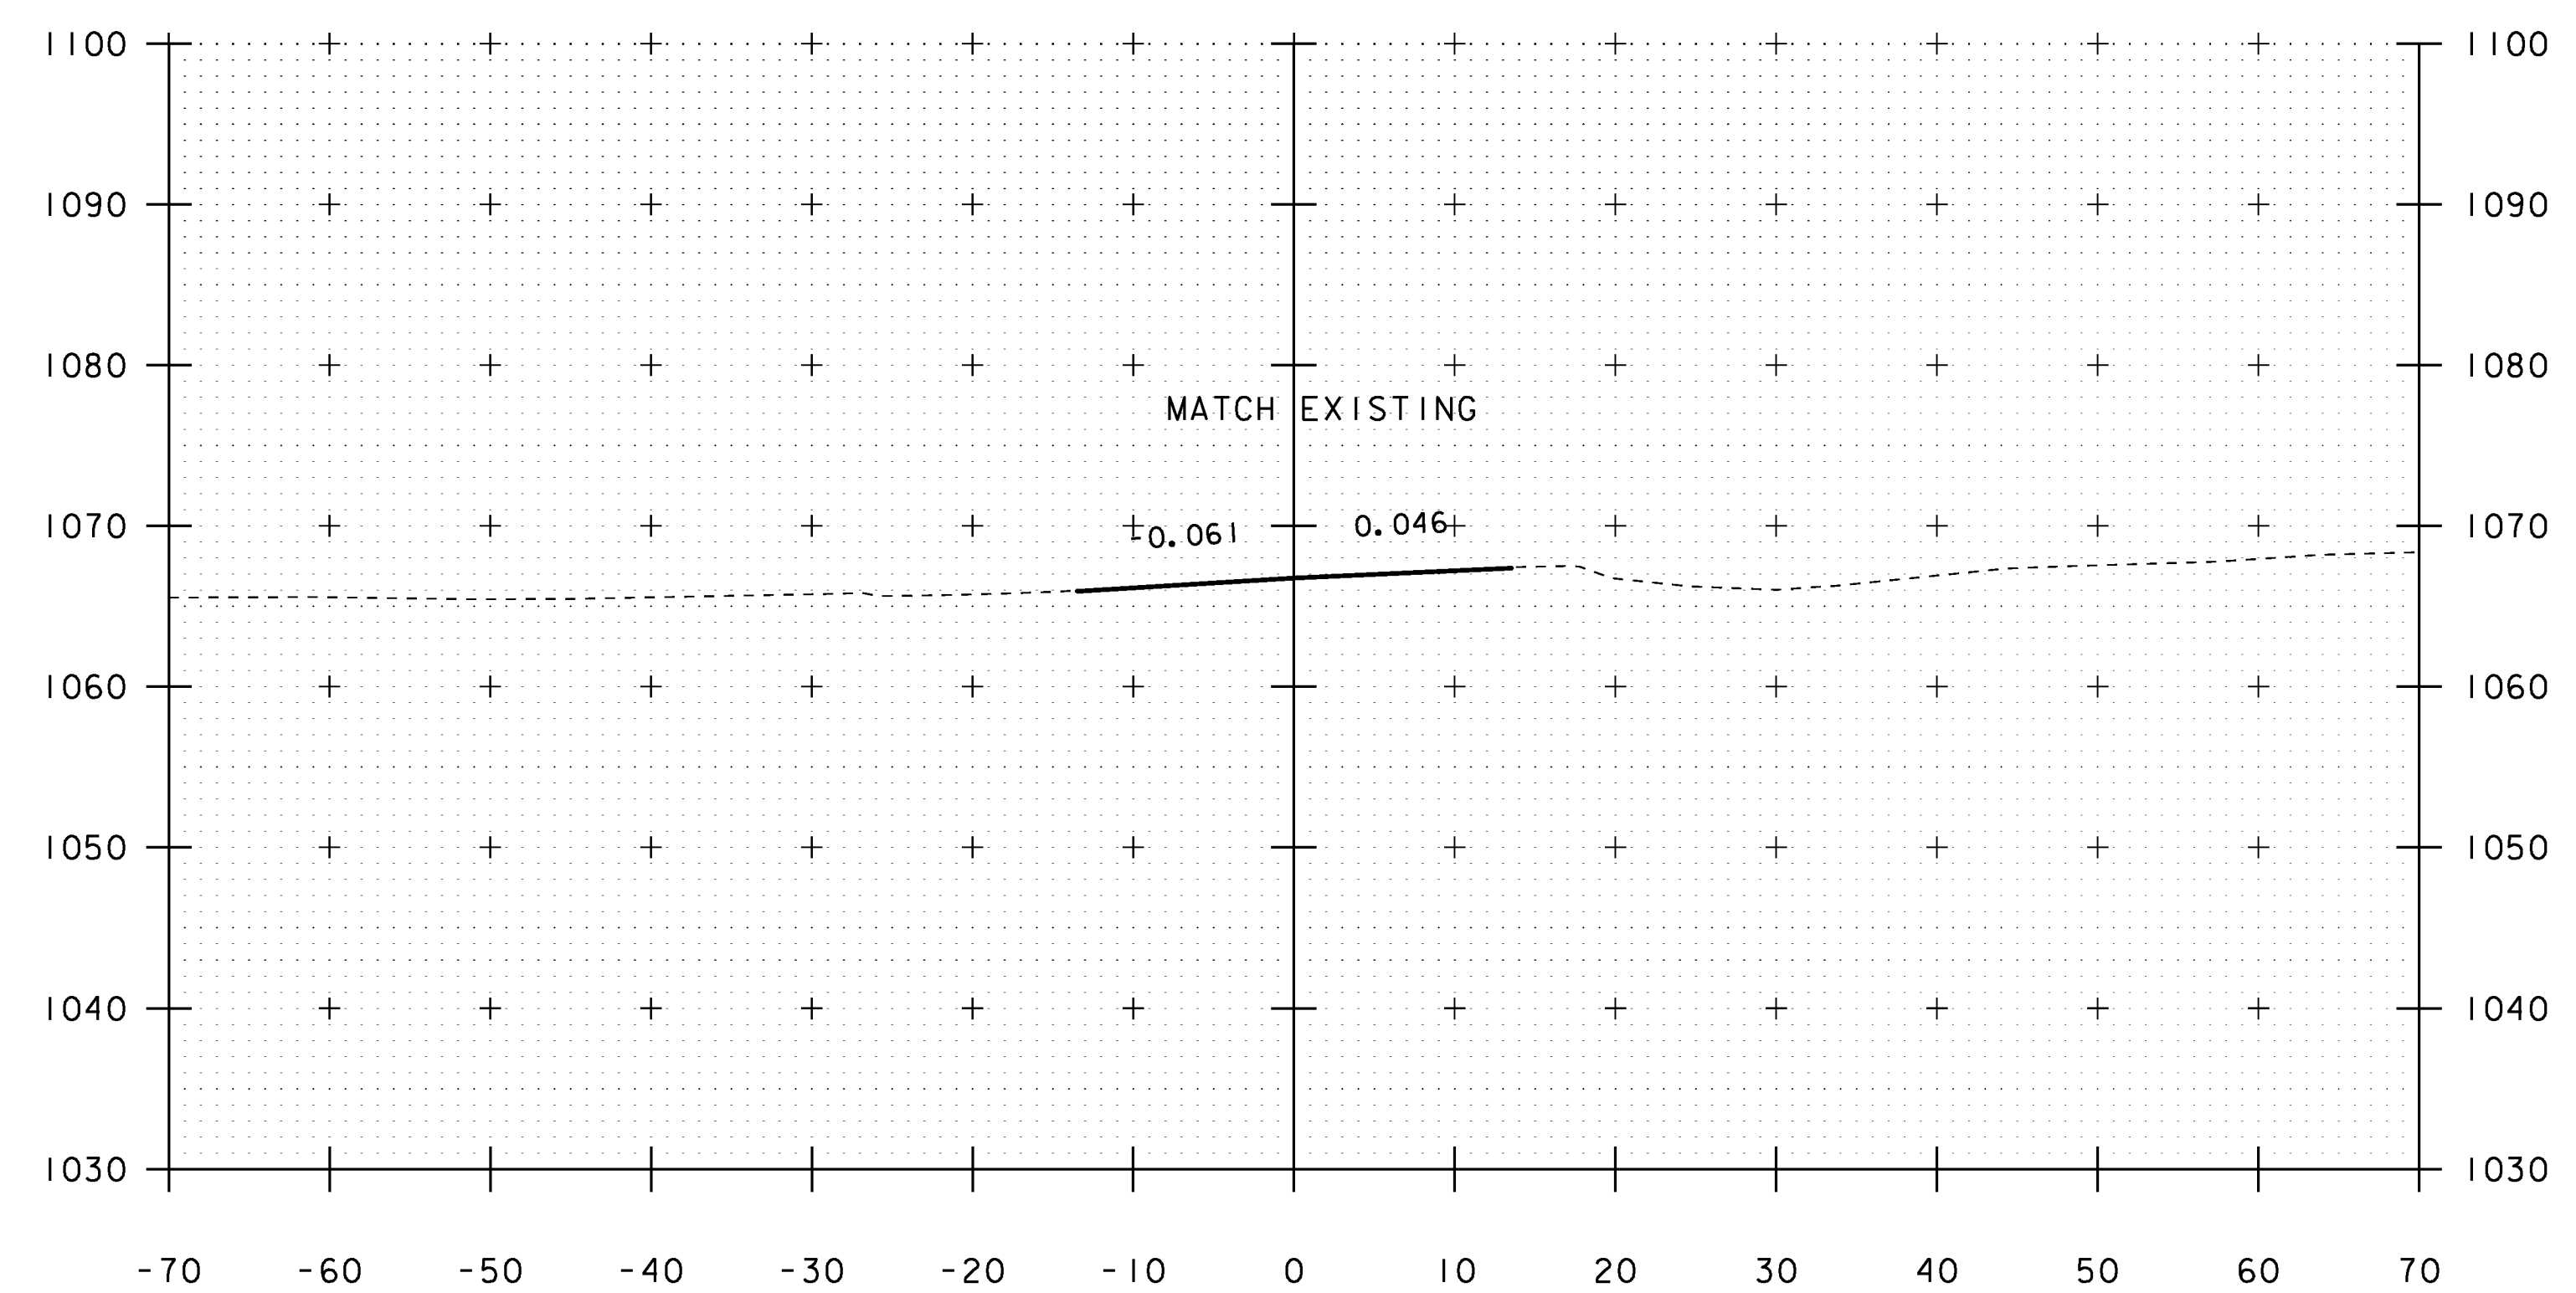

13+75

END APPROACH

PROJECT NAME:	ANDOVER	PLOT DATE:	06-JAN-2015
PROJECT NUMBER:	BHF 016-1(29)	DRAWN BY:	S. PIRO
FILE NAME:	sl2b140xs.dgn	CHECKED BY:	D. PETERSON
PROJECT LEADER:	C. CARLSON	SHEET	38 OF 48
DESIGNED BY:	D. PETERSON		
VT II CROSS SECTIONS	5		

STA. 13+25 TO STA. 14+00