




50+75

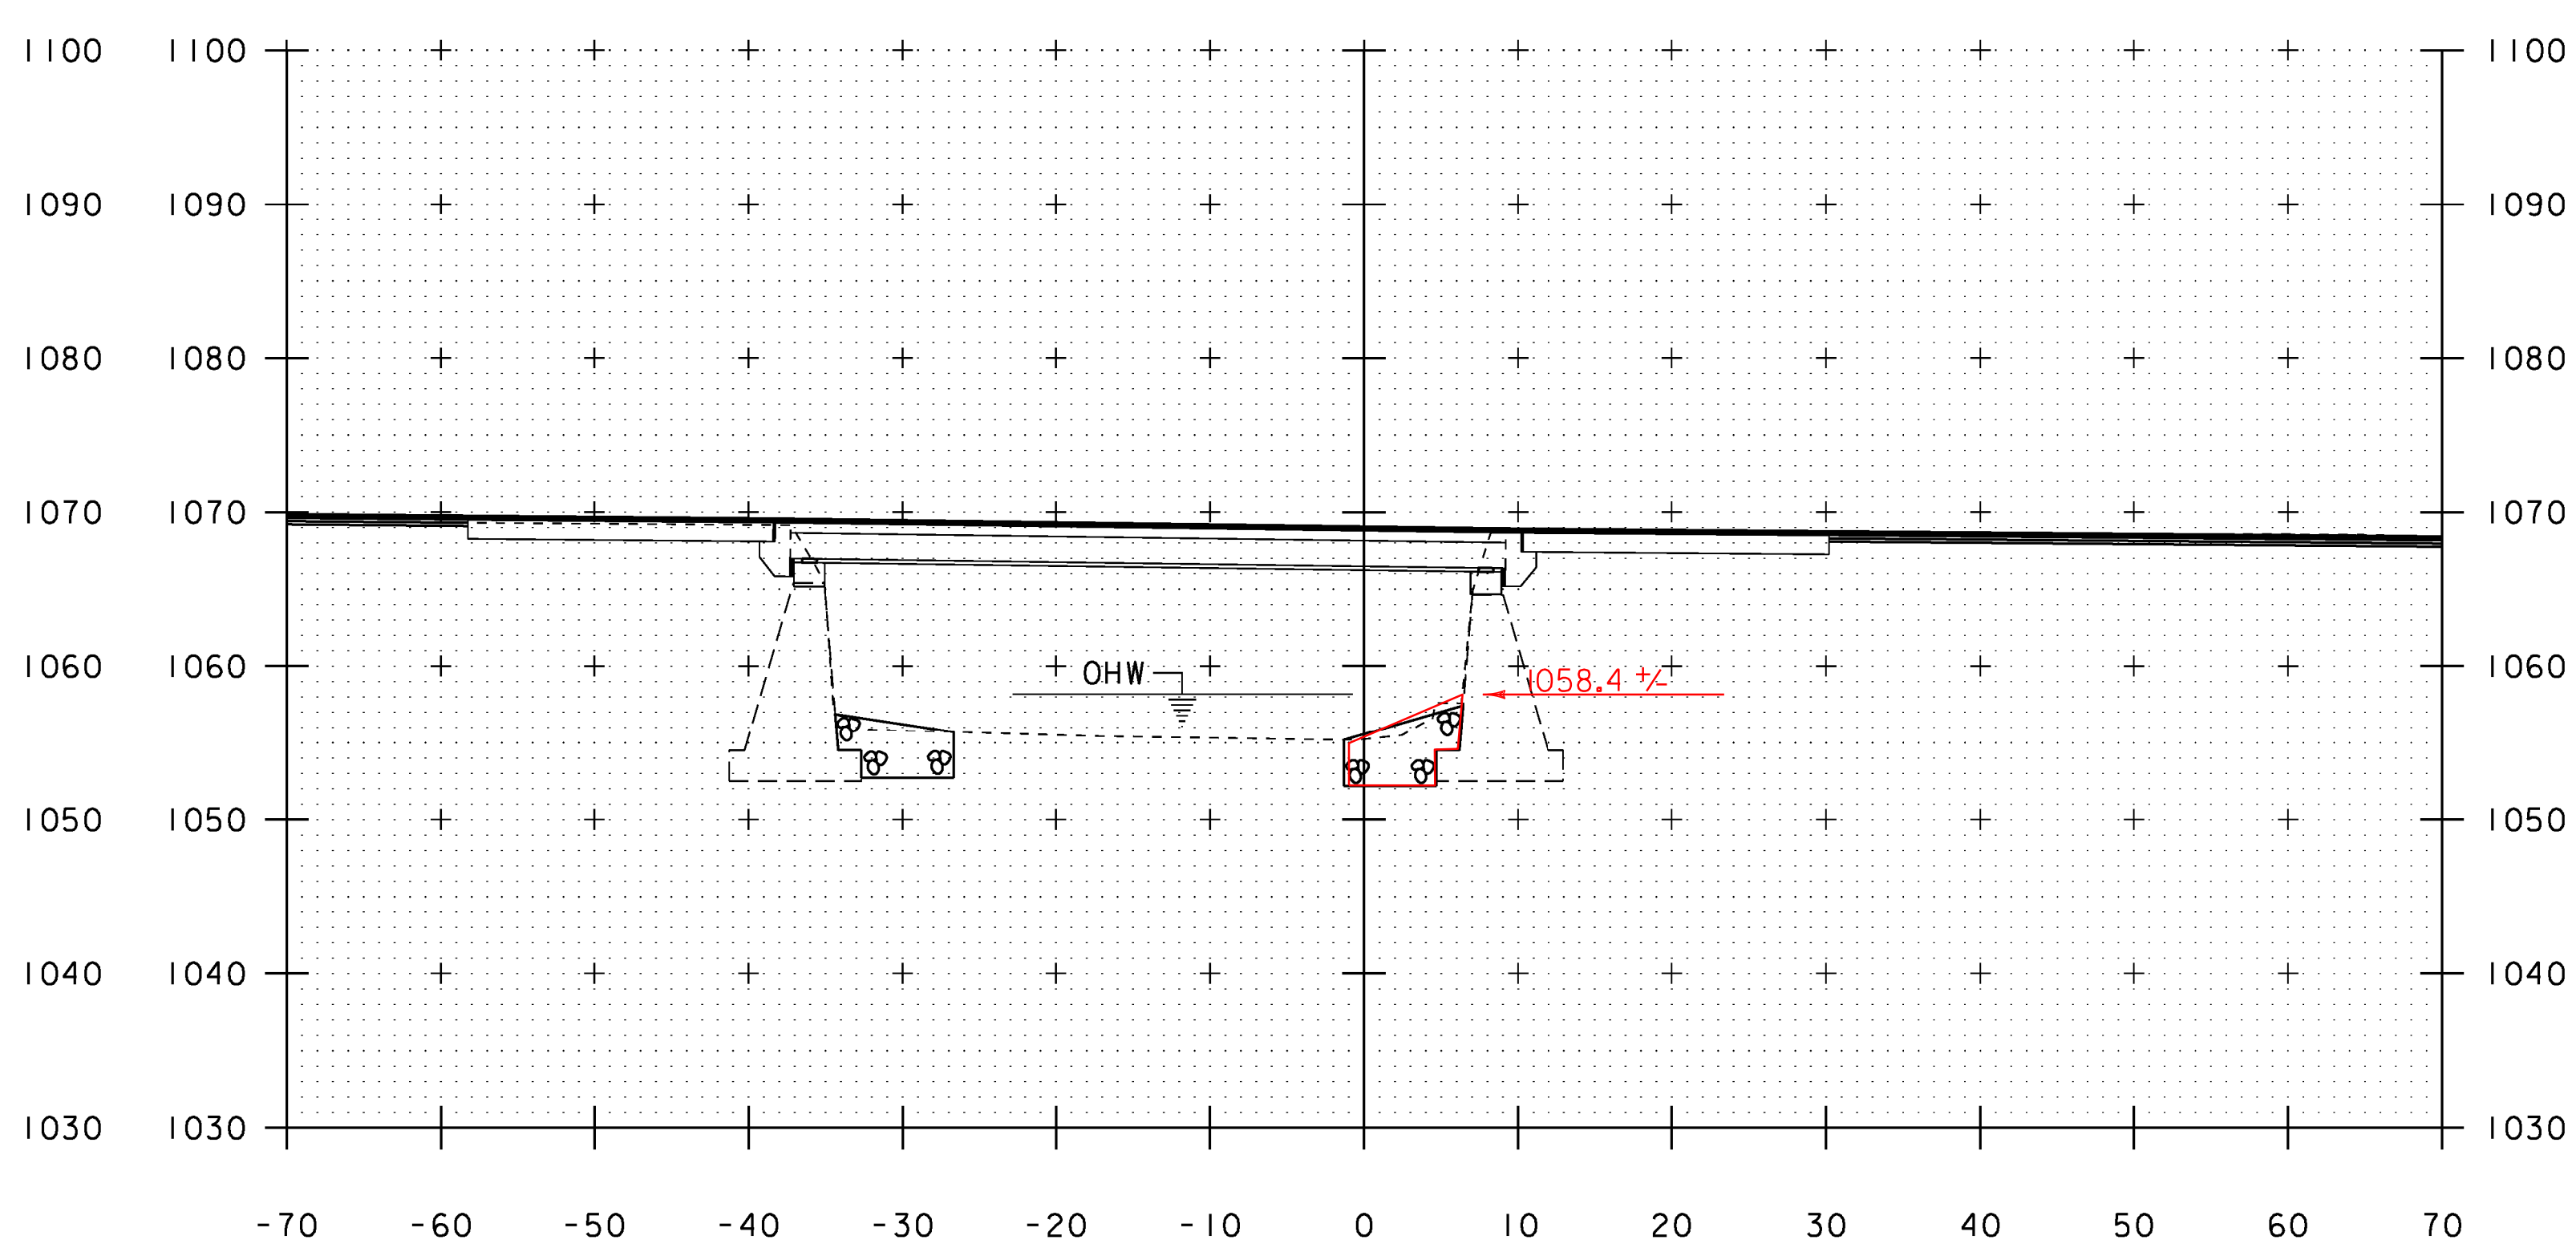

50+90

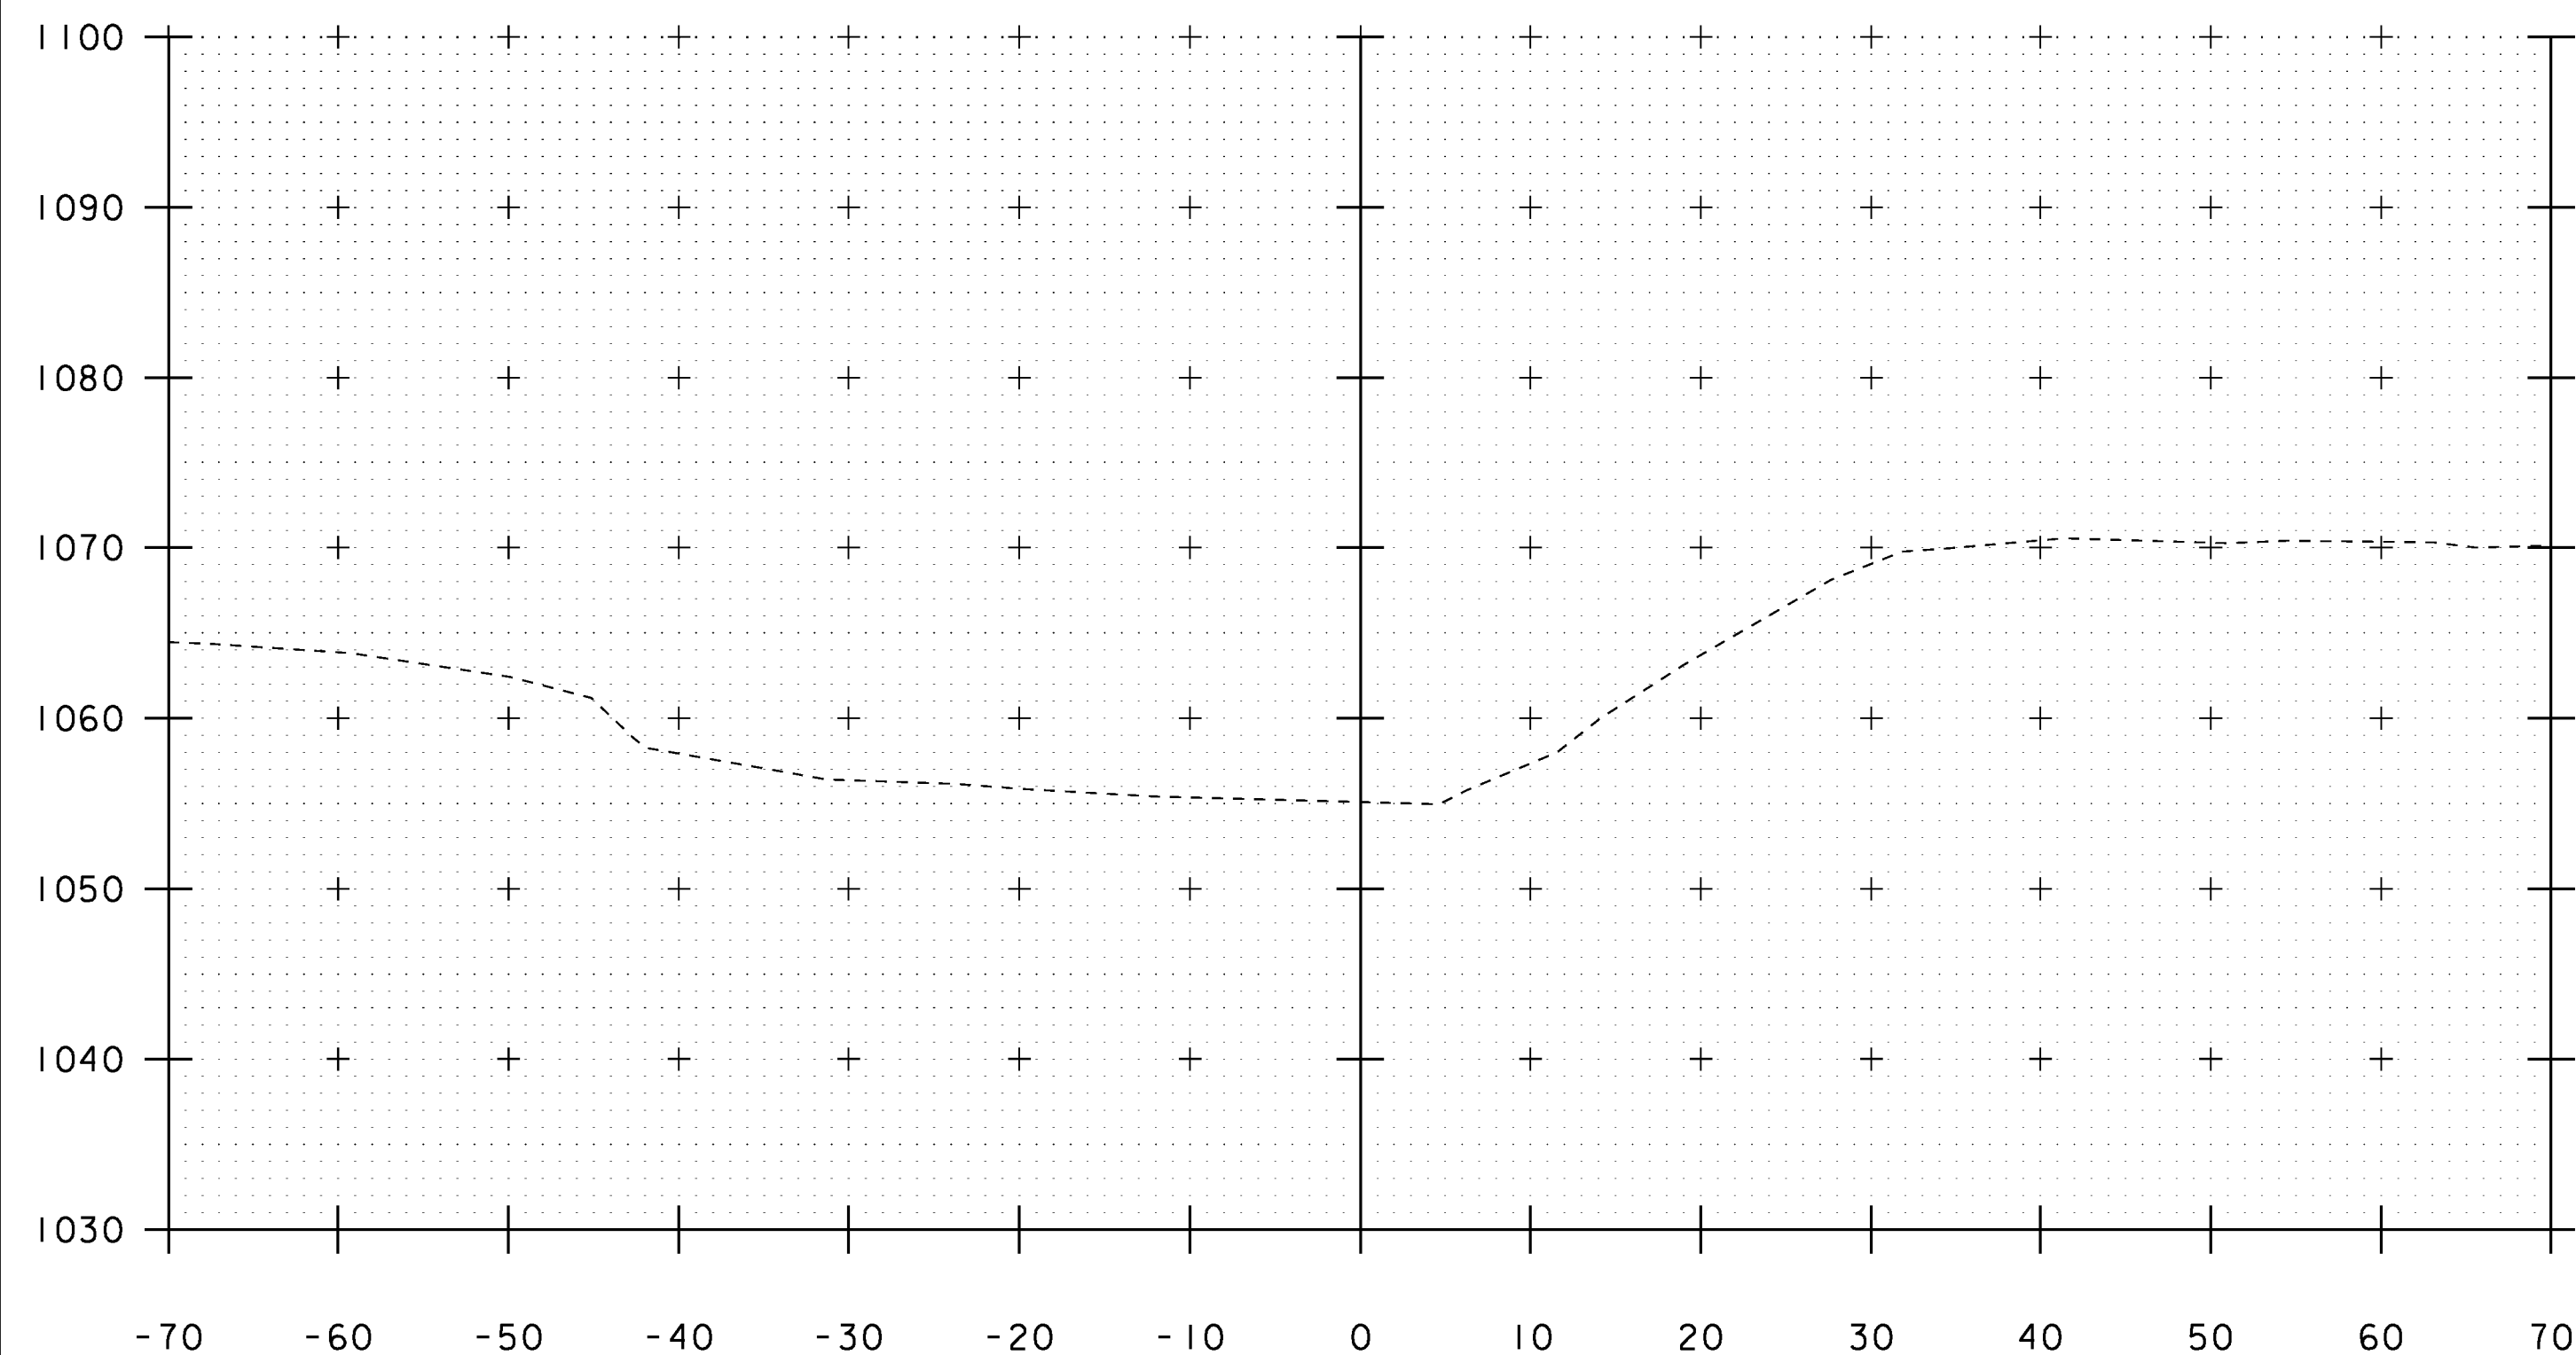

50+70

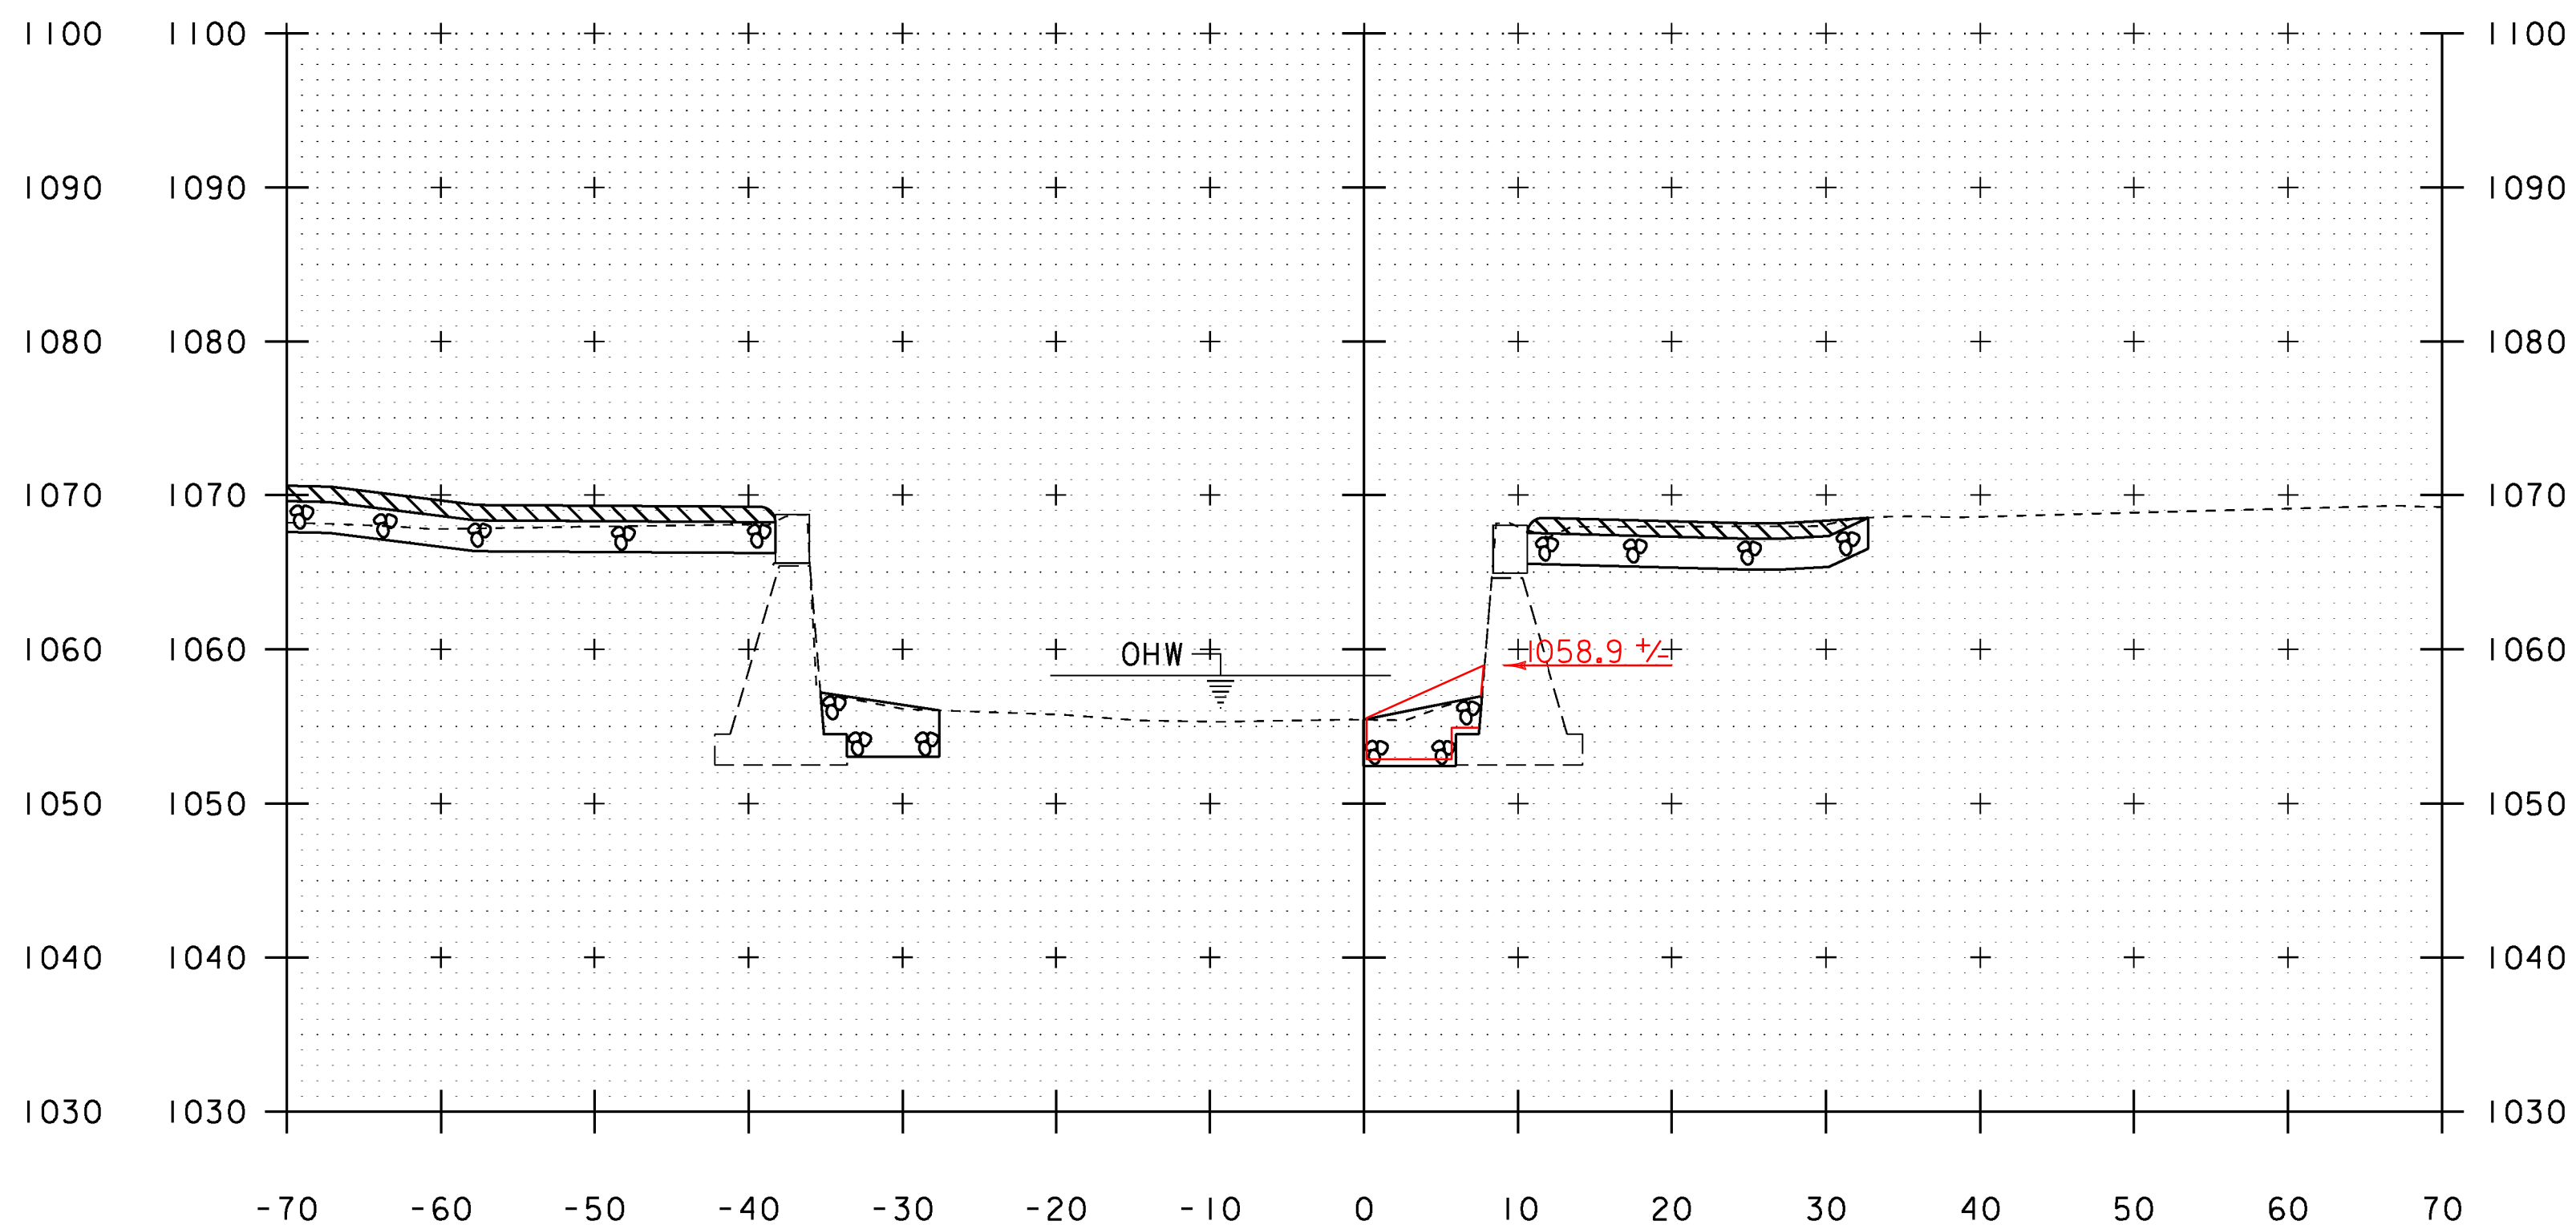

50+80

STA. 50+70 TO STA. 50+90

| | | | |
|--------------------------|---------------|--------------|-------------|
| PROJECT NAME: | ANDOVER | PLOT DATE: | 06-JAN-2015 |
| PROJECT NUMBER: | BHF 016-1(29) | DRAWN BY: | S. PIRO |
| FILE NAME: | sl2bl40xs.dgn | DESIGNED BY: | D. PETERSON |
| PROJECT LEADER: | C. CARLSON | CHECKED BY: | D. PETERSON |
| CHANNEL CROSS SECTIONS 1 | | SHEET | 41 OF 48 |