




51+10

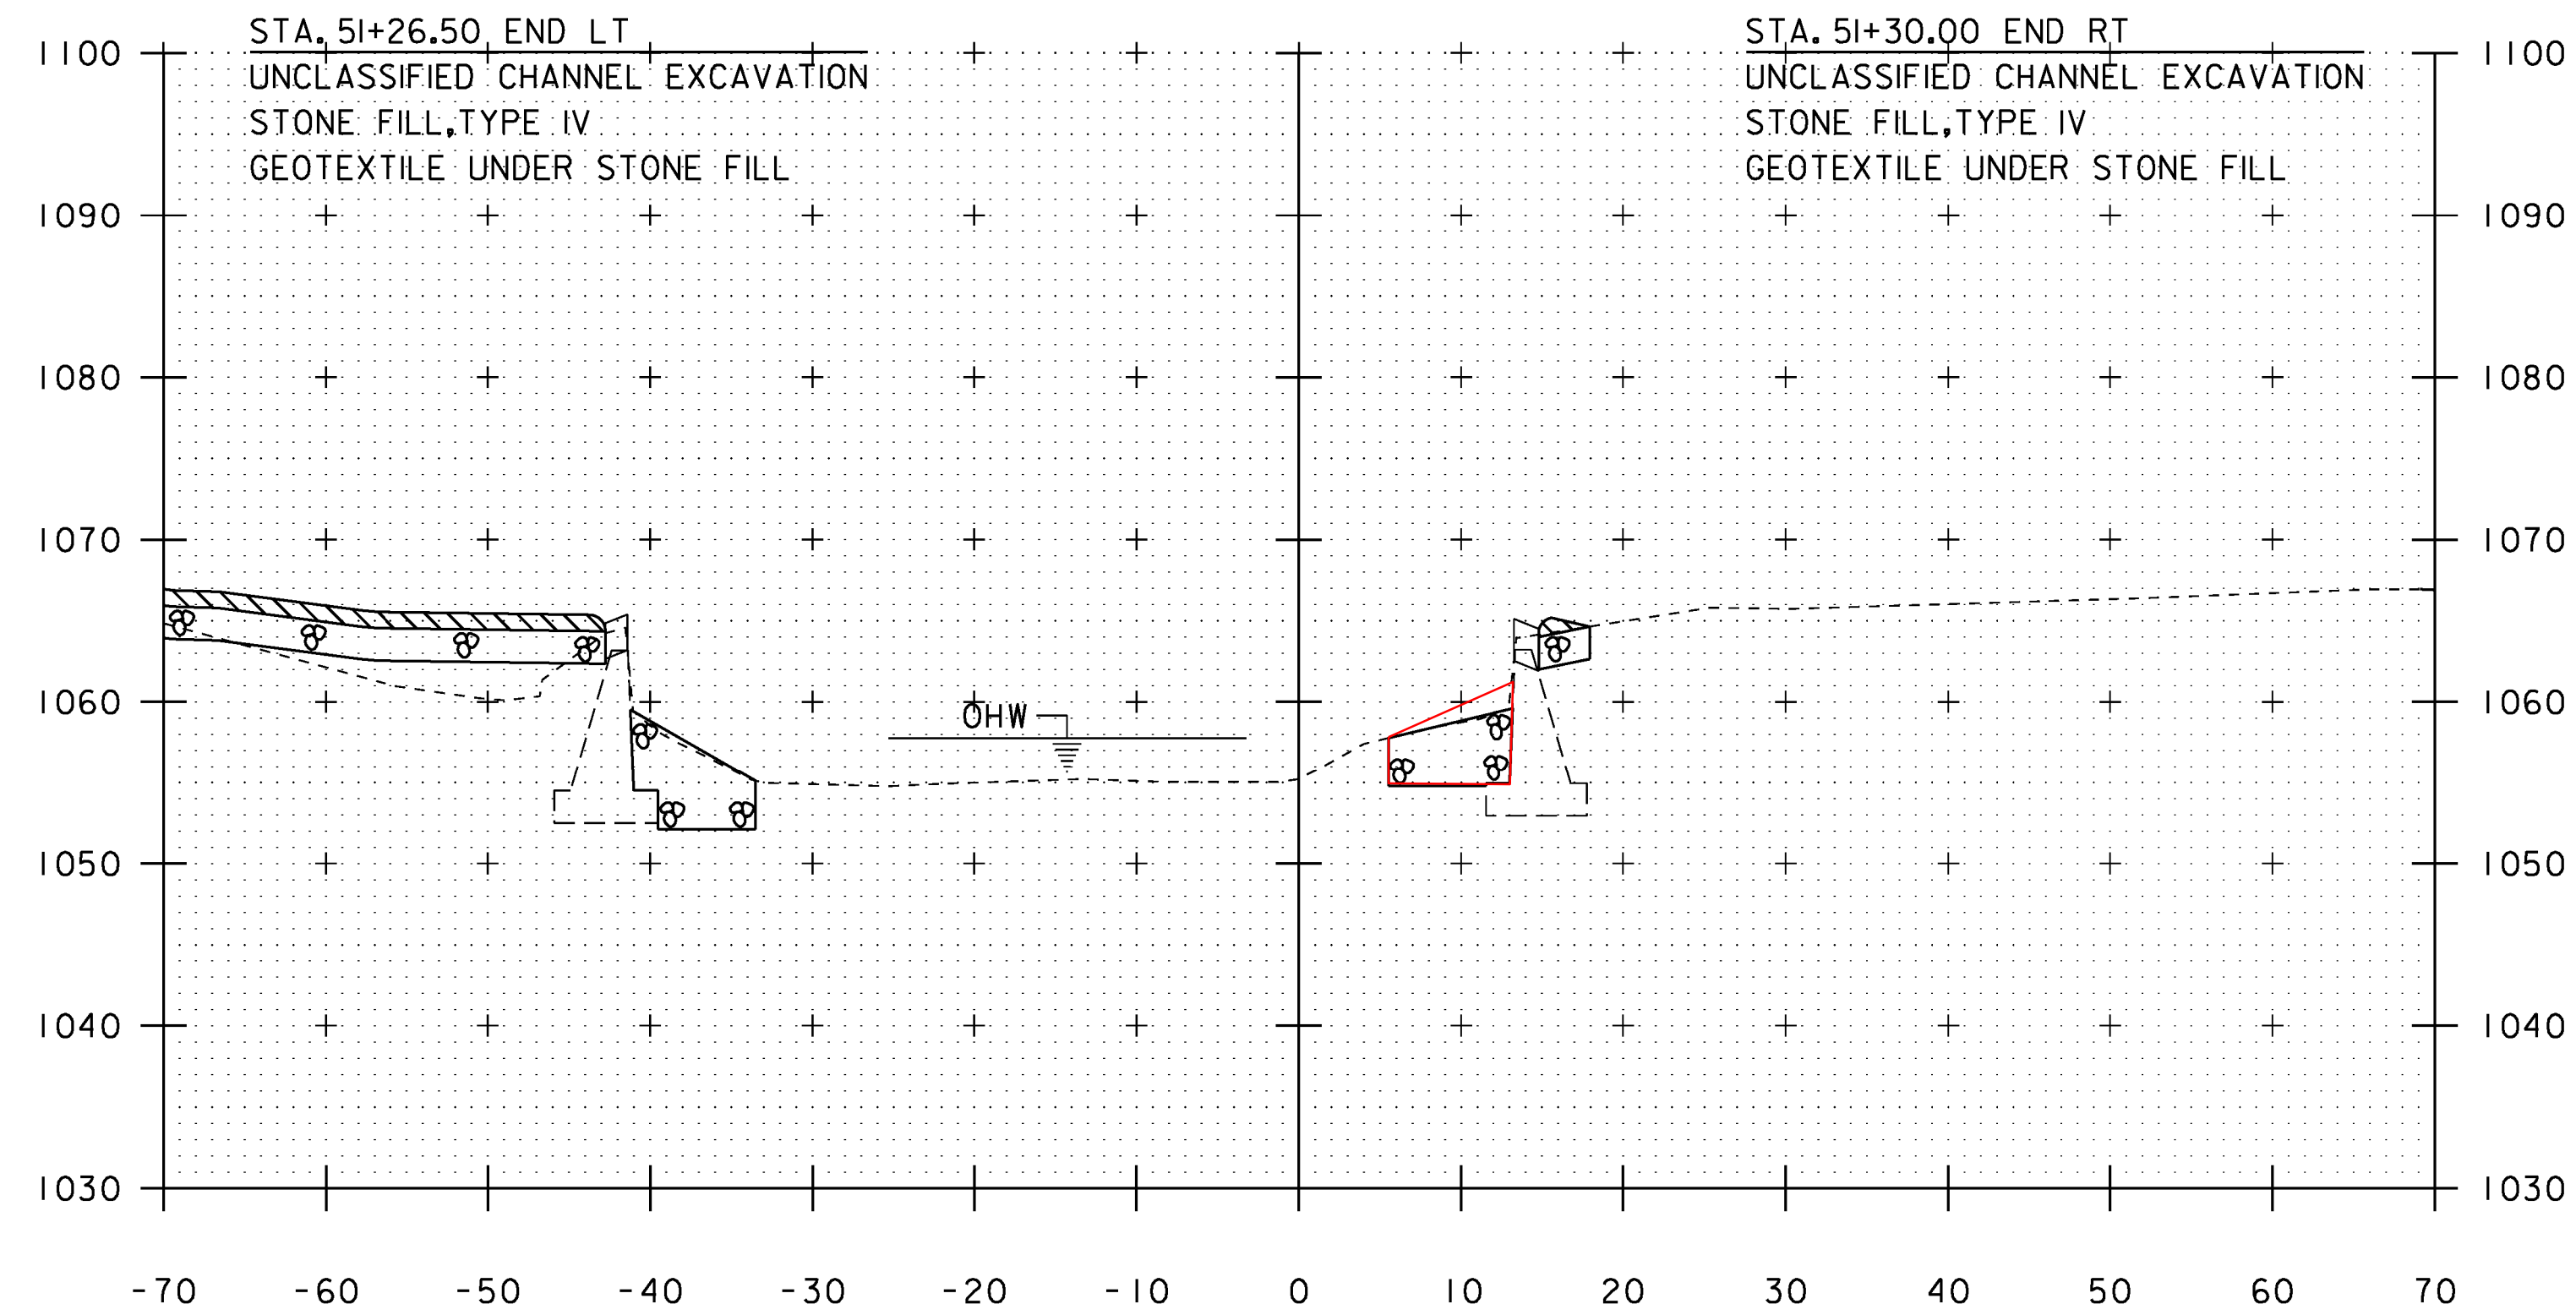

51+25

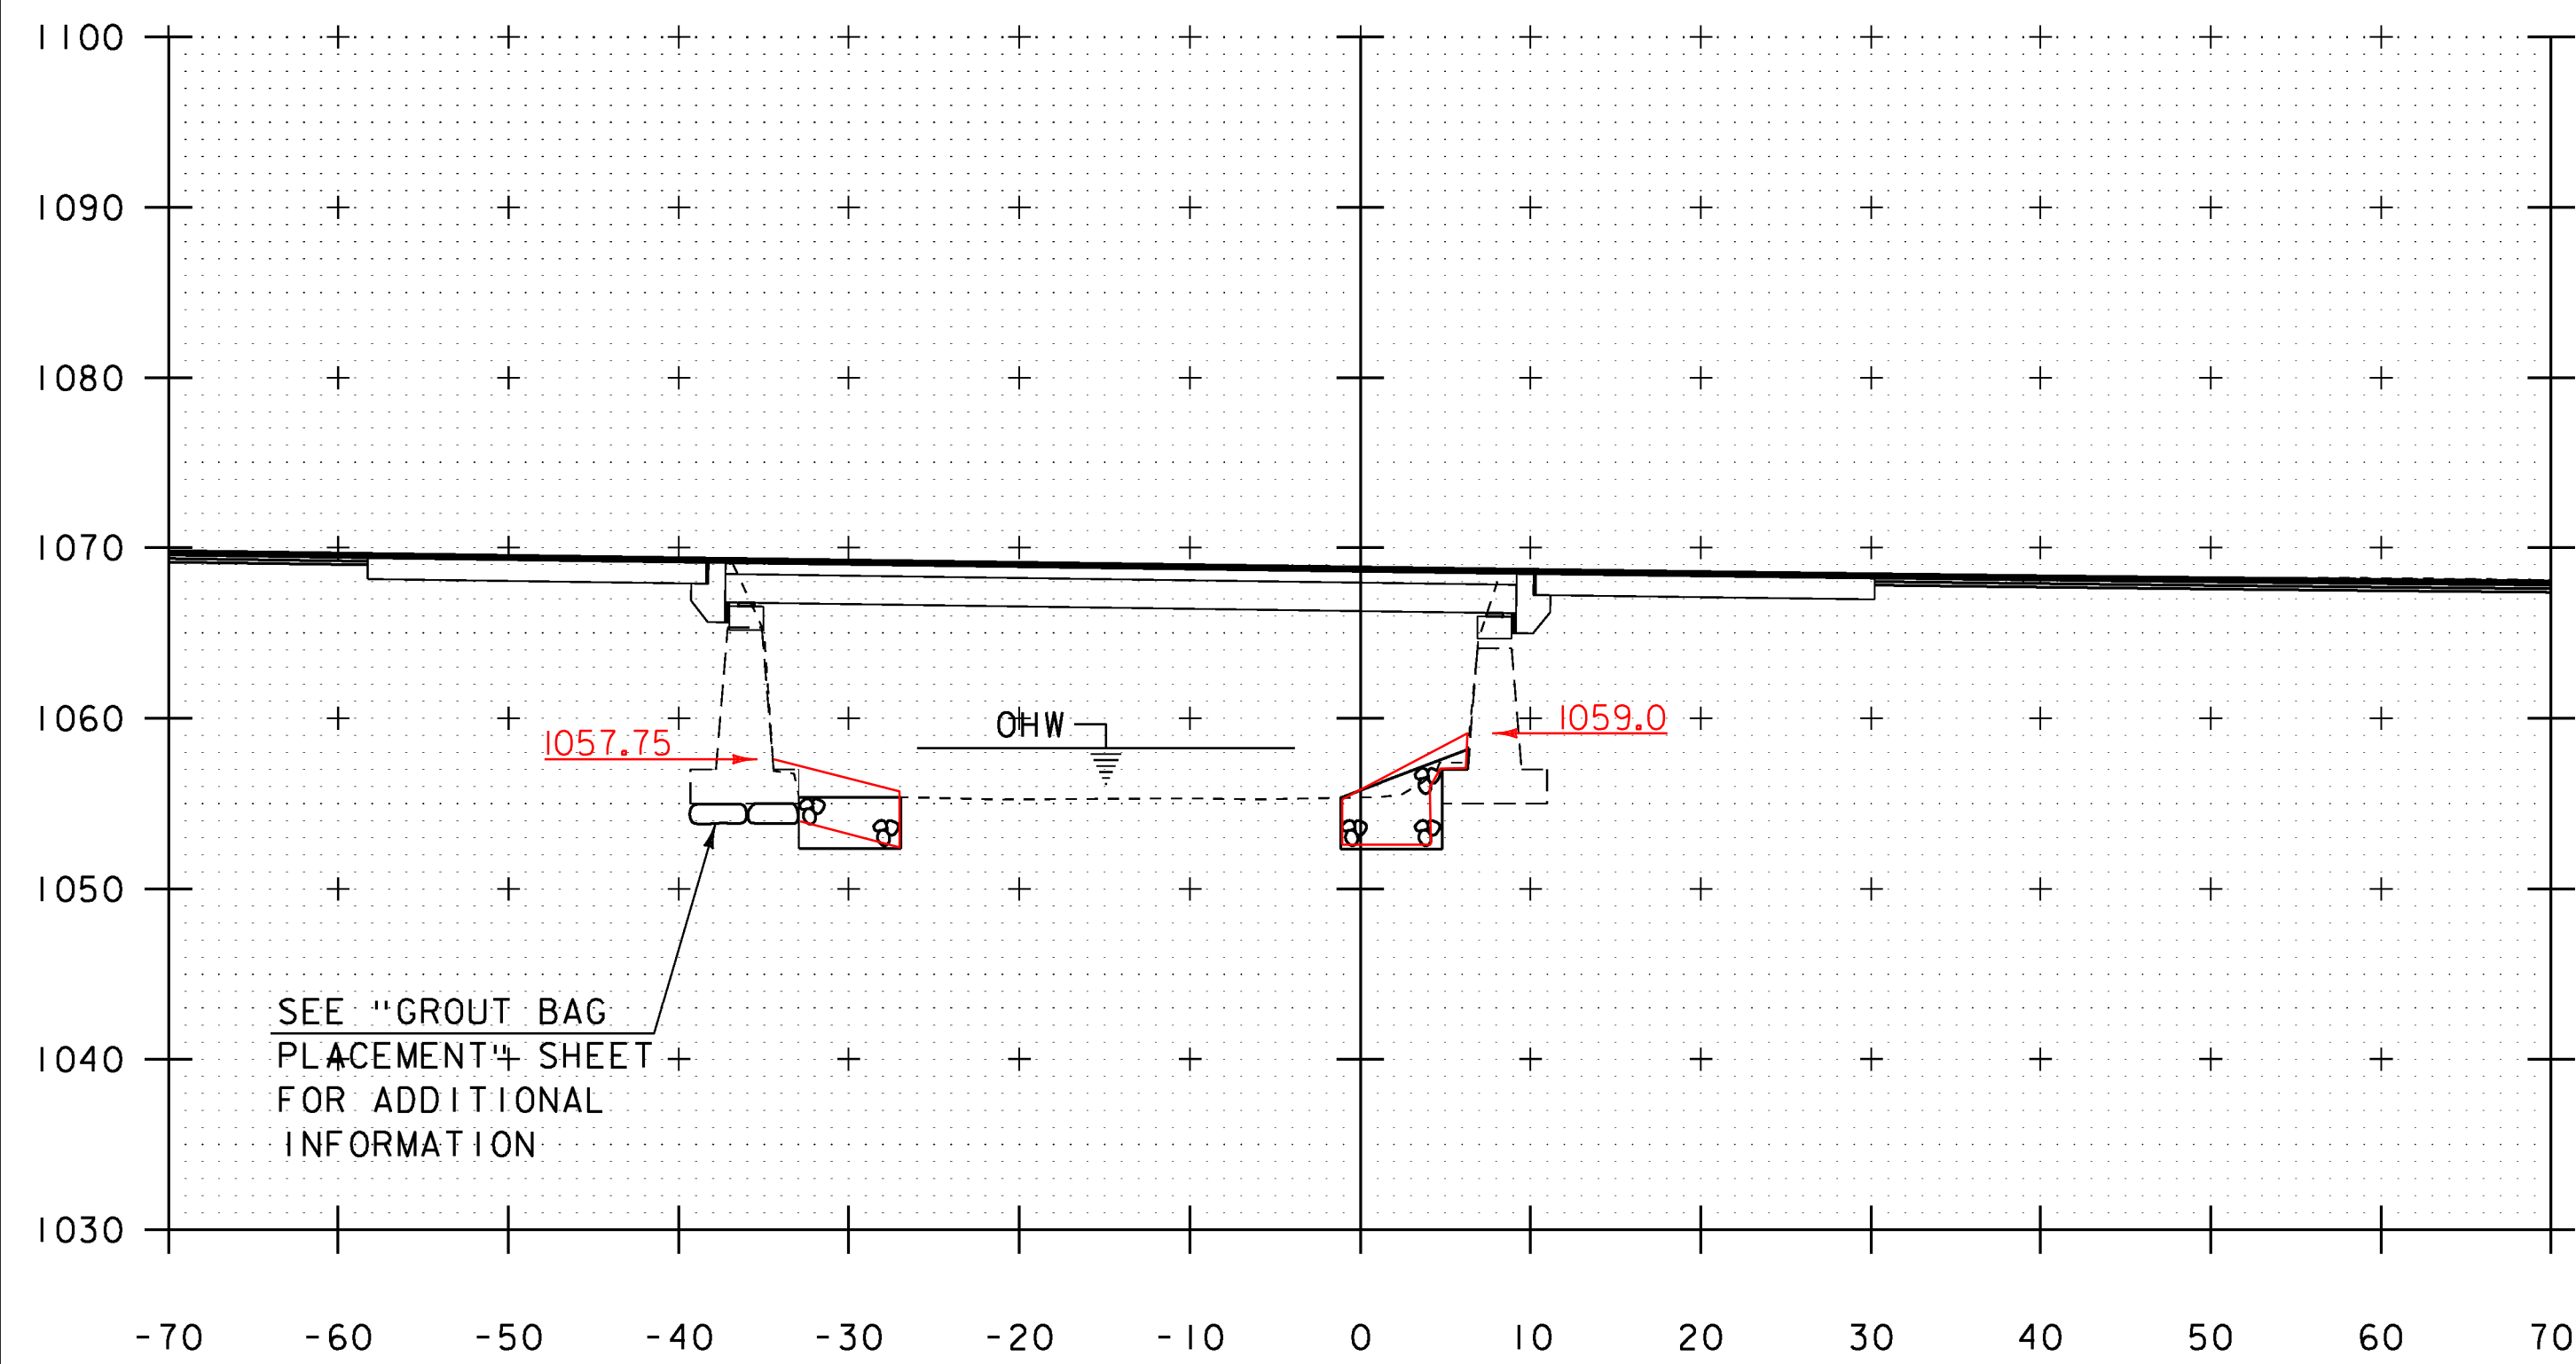

51+00

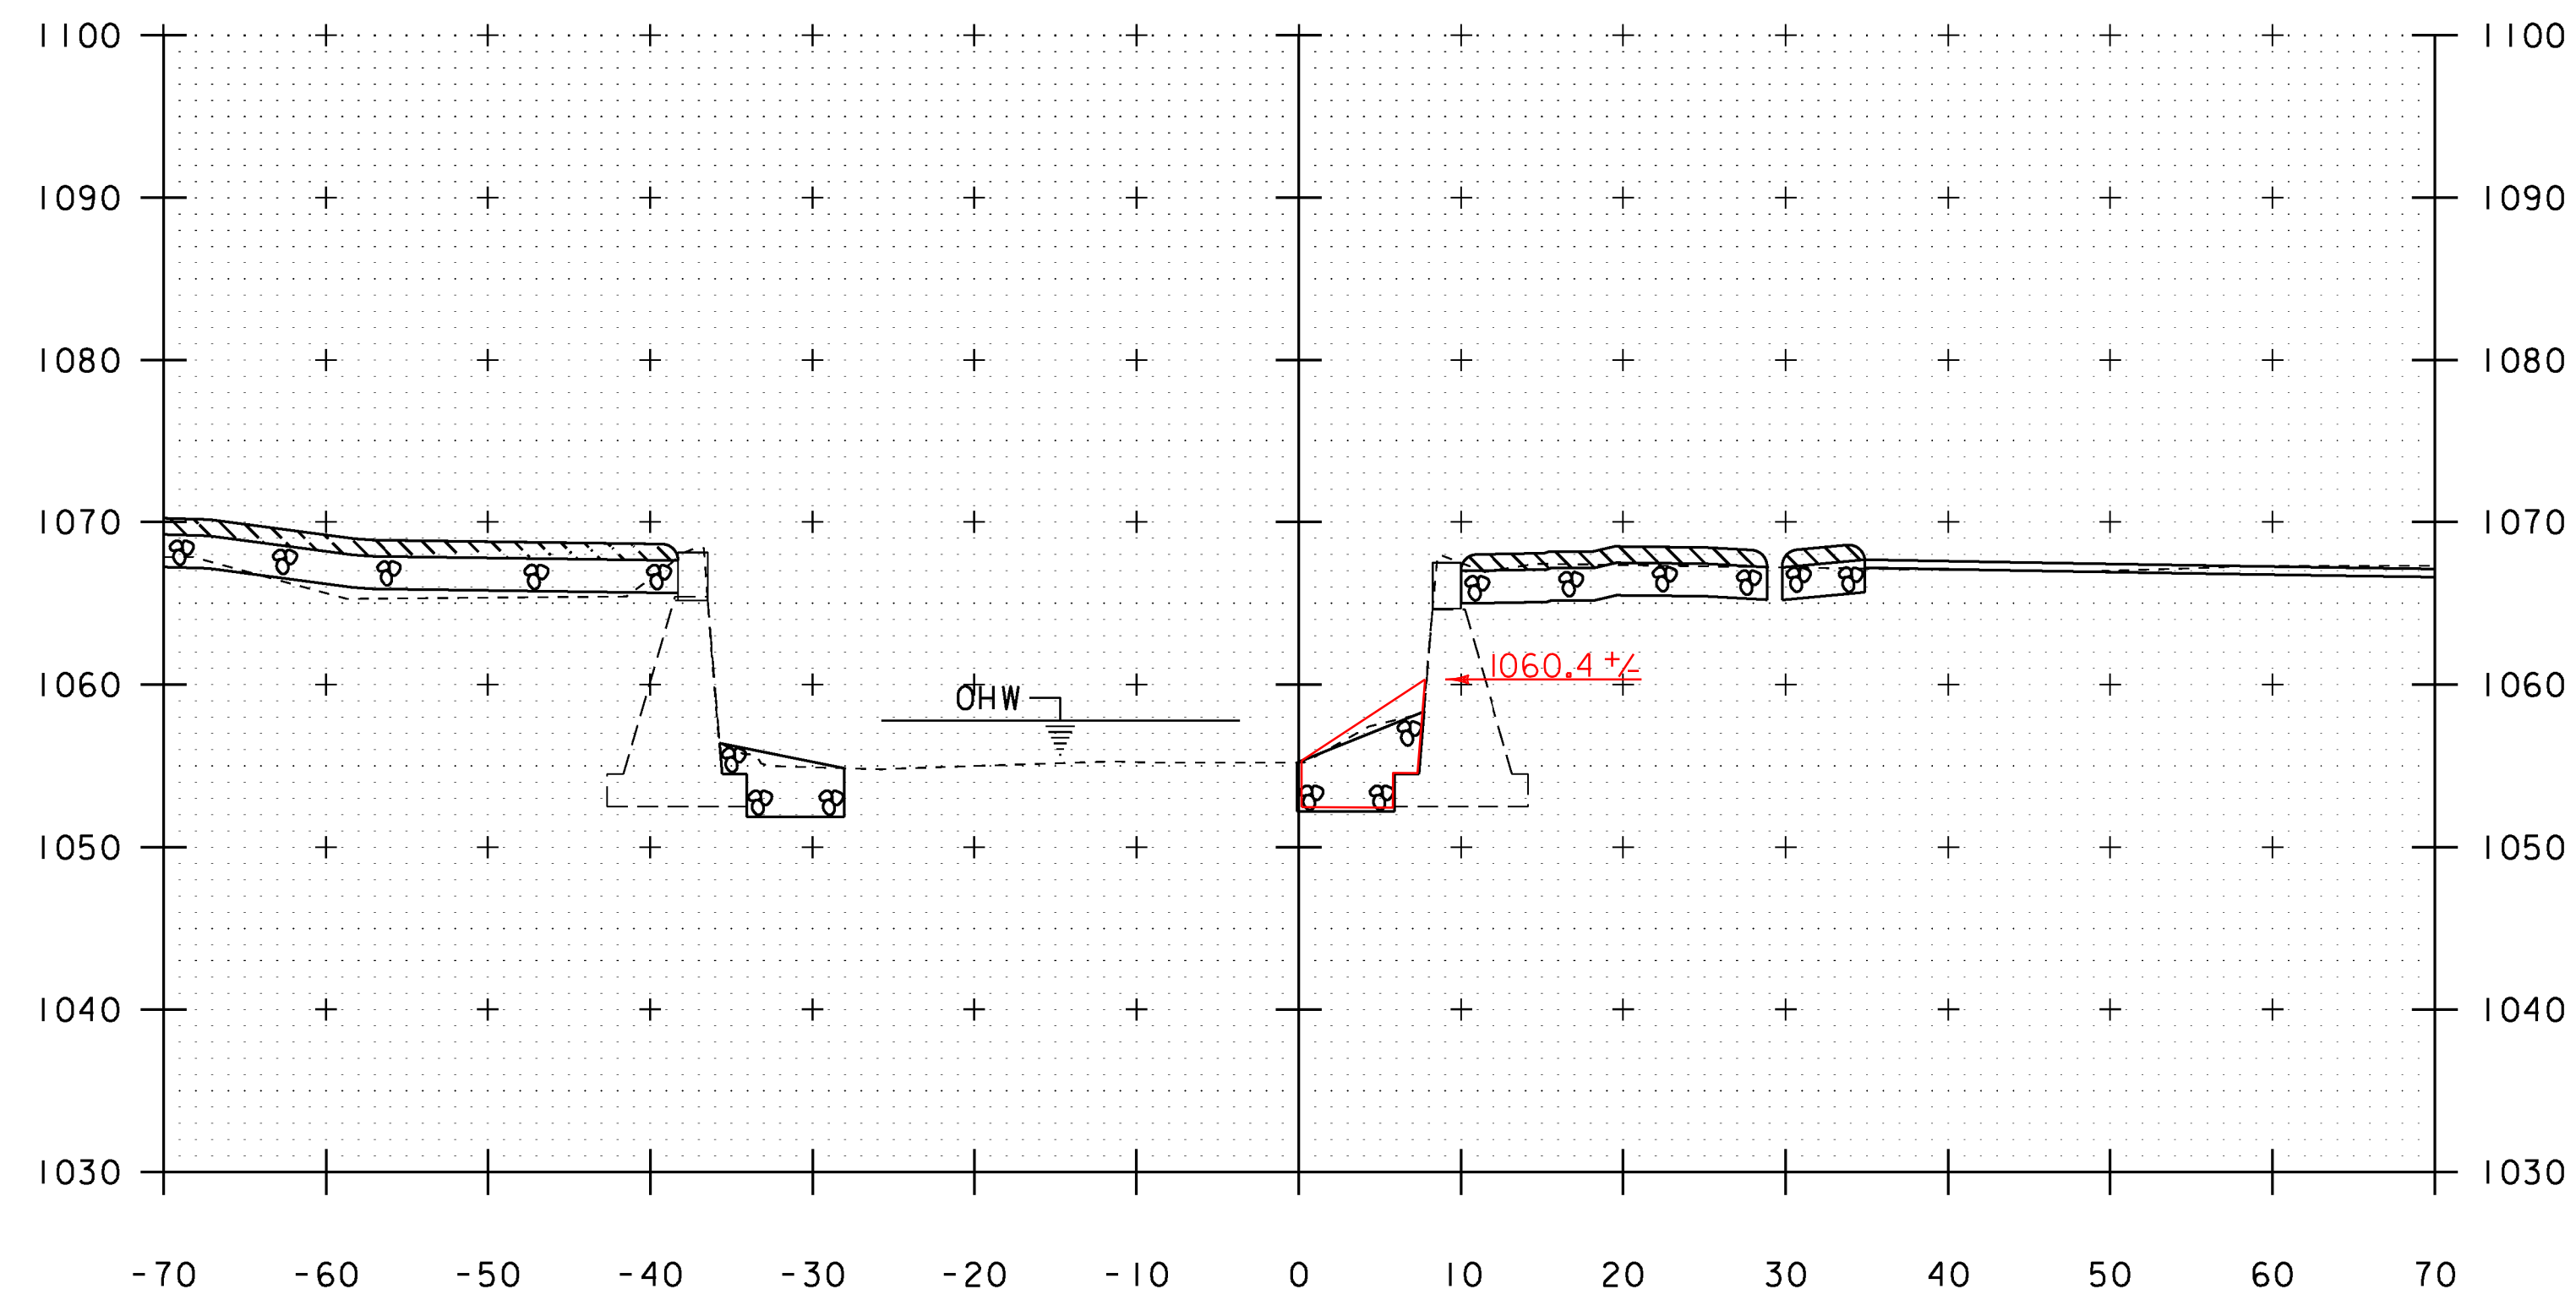

51+20

STA. 51+00 TO STA. 51+25

PROJECT NAME: ANDOVER	
PROJECT NUMBER: BHF 016-1(29)	
FILE NAME: s12b140xs.dgn	PLOT DATE: 06-JAN-2015
PROJECT LEADER: C. CARLSON	DRAWN BY: S. PIRO
DESIGNED BY: D. PETERSON	CHECKED BY: D. PETERSON
CHANNEL CROSS SECTIONS 2	SHEET 42 OF 48