


1 TRANSVERSE SOLID SLAB SECTION
 F2
 1/2" = 1'-0"

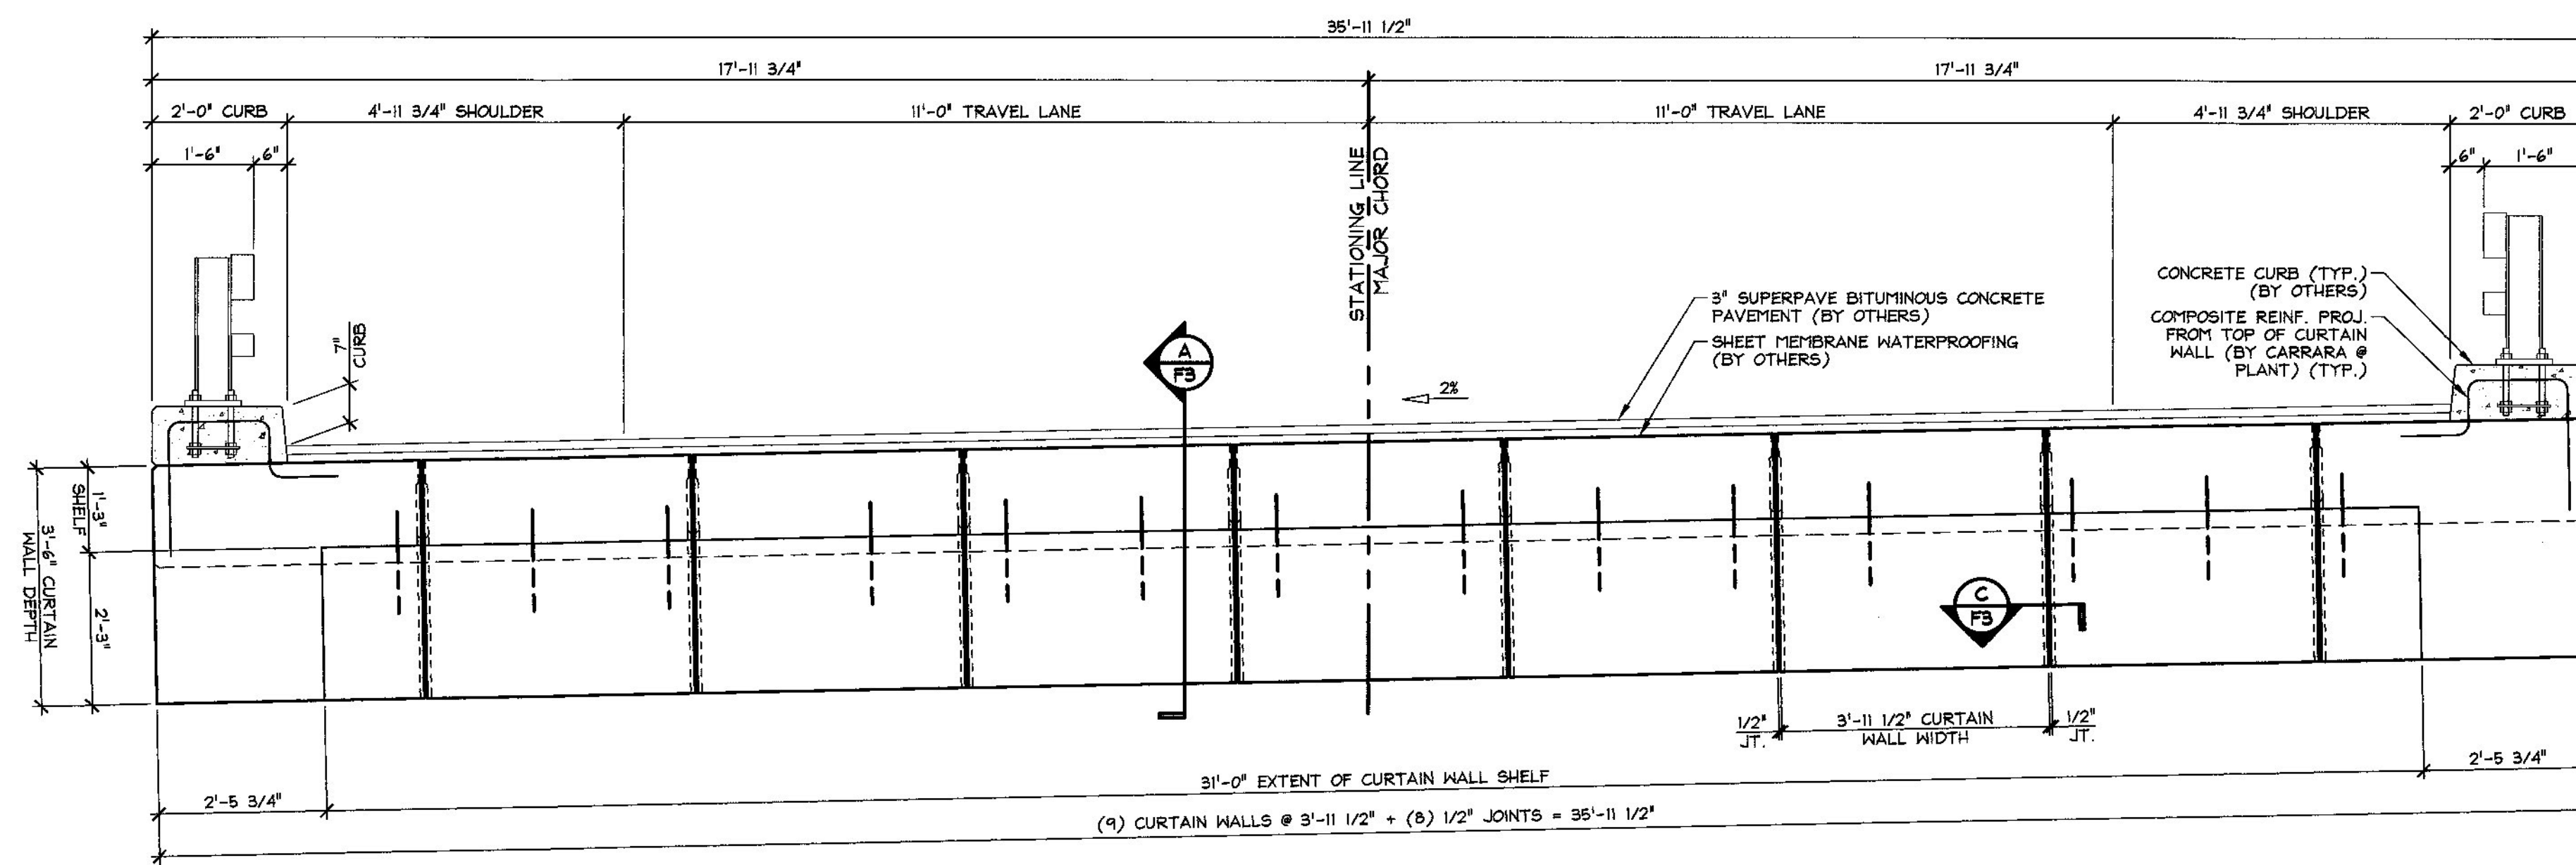

2 CURTAIN WALL ELEVATION
 F2
 1/2" = 1'-0"

Vermont Agency of Transportation
RECEIVED
 ON: June 10, 2015
 and Checked for
CONFORMANCE
 BY: D. PETERSON DATE: 06/11/2015

6-9-15 REVISED AS NOTED

APPROVAL STAMP:
 FOR DESIGN AND FABRICATION

 DATE 6/10/15

J.P. CARRARA & SONS INC. Precast & Prestress Manufacturer <small>2484 CASE ST., MIDDLEBURY, VERMONT 05753 Phone:(802)388-6361 Fax:(802)388-9010</small>		RENAUD BROS, INC. CONTRACTOR VERNON, VERMONT	
STATE OF VERMONT AGENCY OF TRANSPORTATION COUNTY OF WINDSOR		DATE: MAY 6, 2015 SCALE: NOTED	
TOWN OF ANDOVER VT RTE 11, RURAL MINOR ARTERIAL BRIDGE NO.: 41 PROJECT NO.: BHF 016-1(29)		CHKD: J.C. DFTM: B.L. JOB NO: 23465-015	
TRANSVERSE SECTION & CURTAIN WALL ELEVATION		DWG. NO: F2	