


1 ABUTMENT NO. 1 PARTIAL ELEVATION
 F2.1 1/2" = 1'-0"

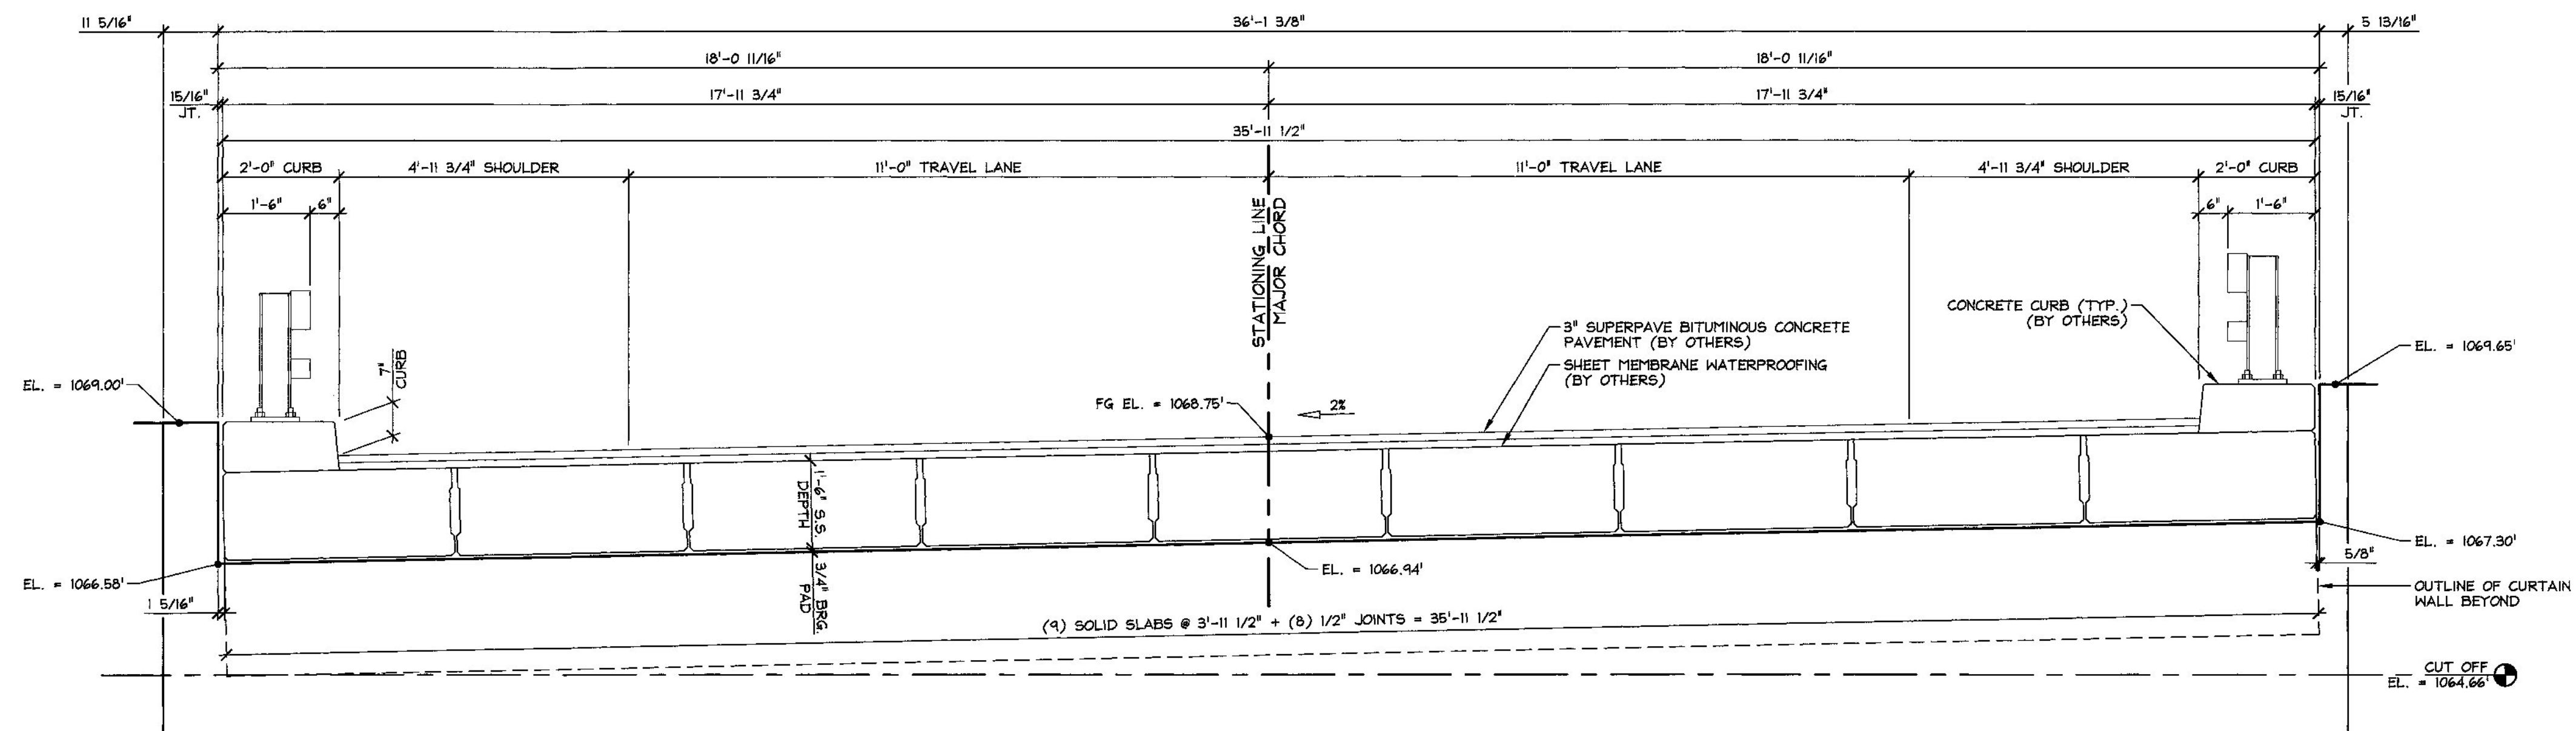


2 ABUTMENT NO. 2 PARTIAL ELEVATION
 F2.1 1/2" = 1'-0"

Vermont Agency of Transportation
RECEIVED
 ON: June 10, 2015
 and Checked for
CONFORMANCE
 BY: D. PETERSON DATE: 06/11/2015

6-1-15 GENERAL REVISIONS

APPROVAL STAMP:
 FOR DESIGN AND FABRICATION

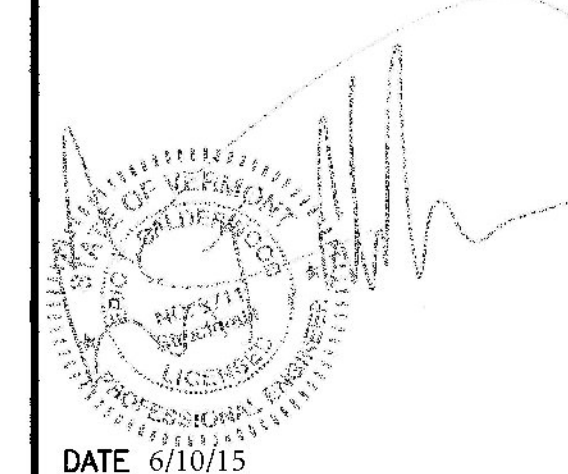

J.P. CARRARA & SONS INC.
 Precast & Prestress Manufacturer
 2464 CASE STR., WOODBURY, VERMONT 05753 Phone: (802)388-6361 Fax: (802)388-9010

RENAUD BROS, INC.
 CONTRACTOR
 VERNON, VERMONT

STATE OF VERMONT AGENCY OF TRANSPORTATION
 COUNTY OF WINDSOR

DATE: MAY 6, 2015

SCALE: NOTED

TOWN OF ANDOVER
 VT RTE 11, RURAL MINOR ARTERIAL
 BRIDGE NO.: 41 PROJECT NO.: BHF 016-1(29)

CHKD: J.C. DFTM: B.L.

JOB NO: 23465-015

PARTIAL ABUTMENT ELEVATIONS

DWG. NO: **F2.1**