




1 DIMENSIONAL PLAN VIEW IN FORM
3/4" = 1'-0"

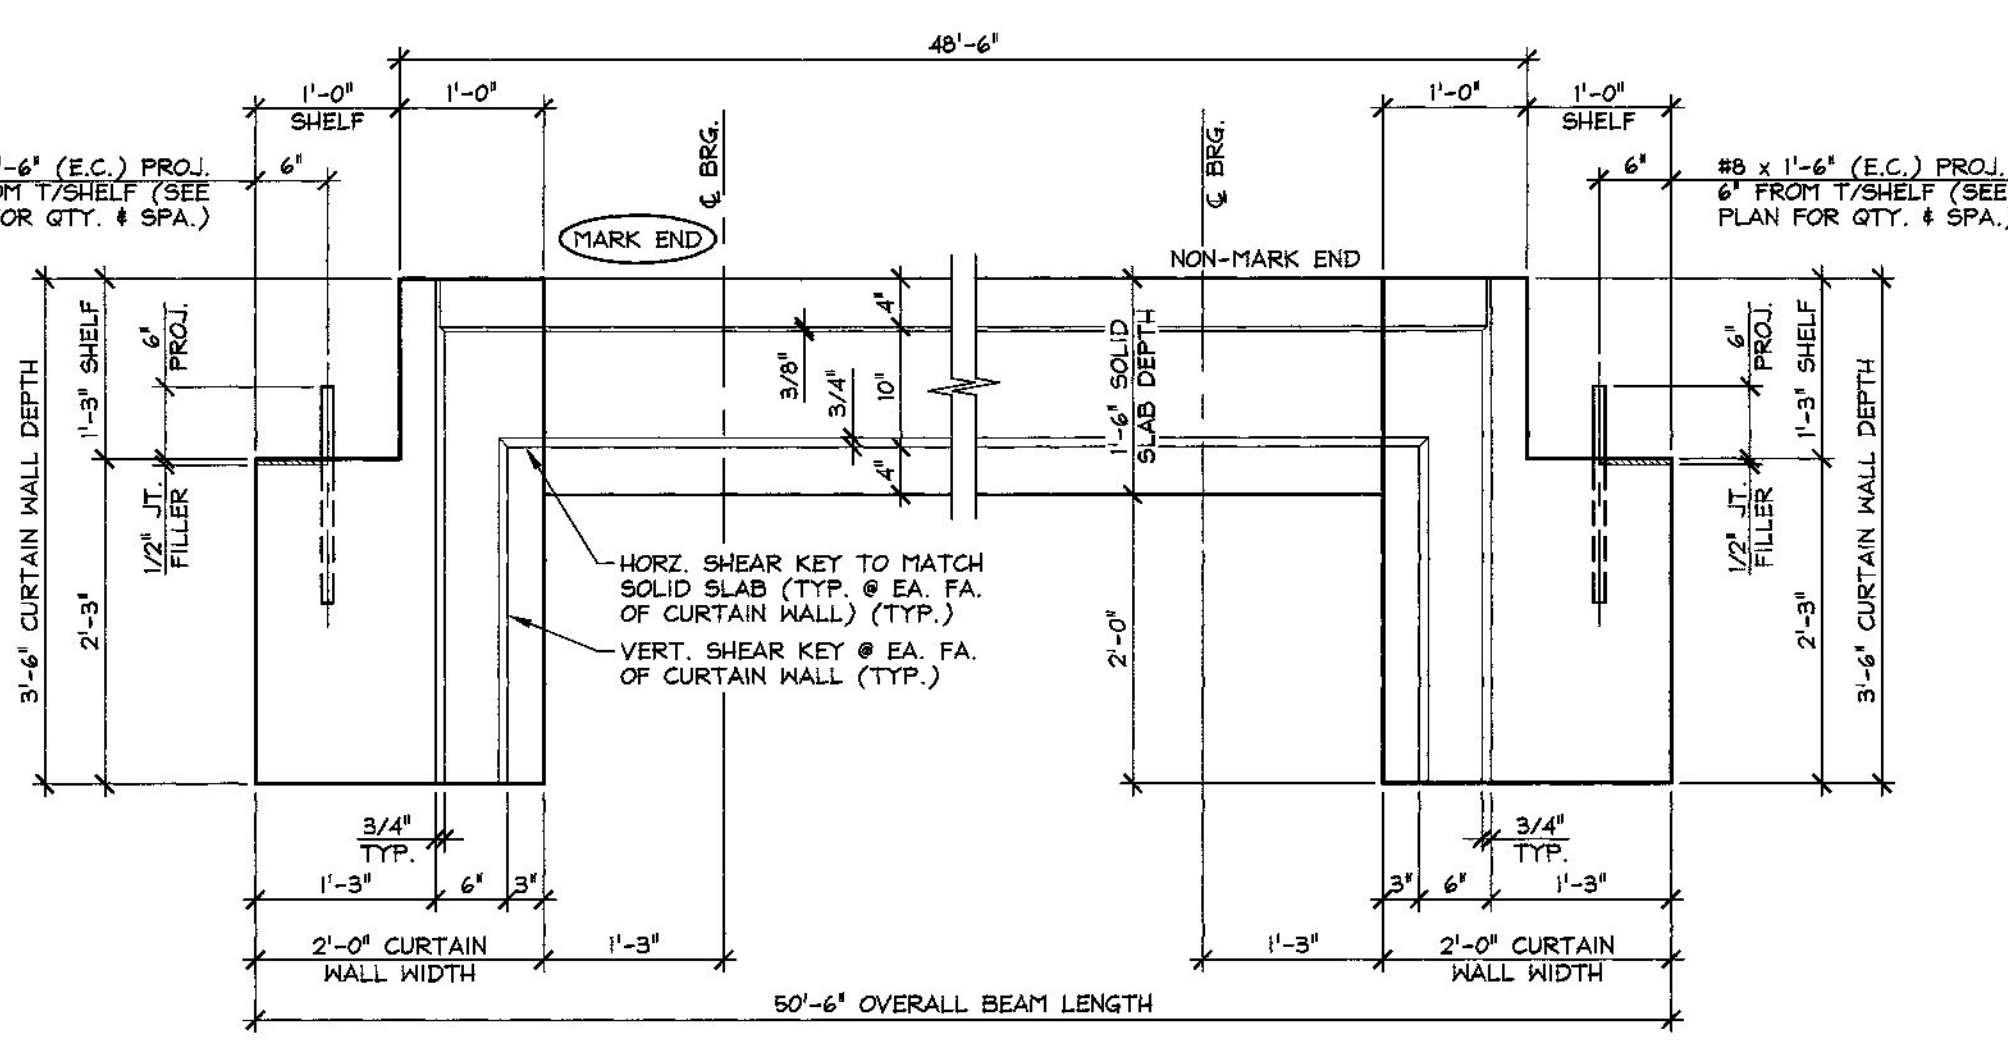


4 DIMENSIONAL ELEVATION
3/4" = 1'-0"

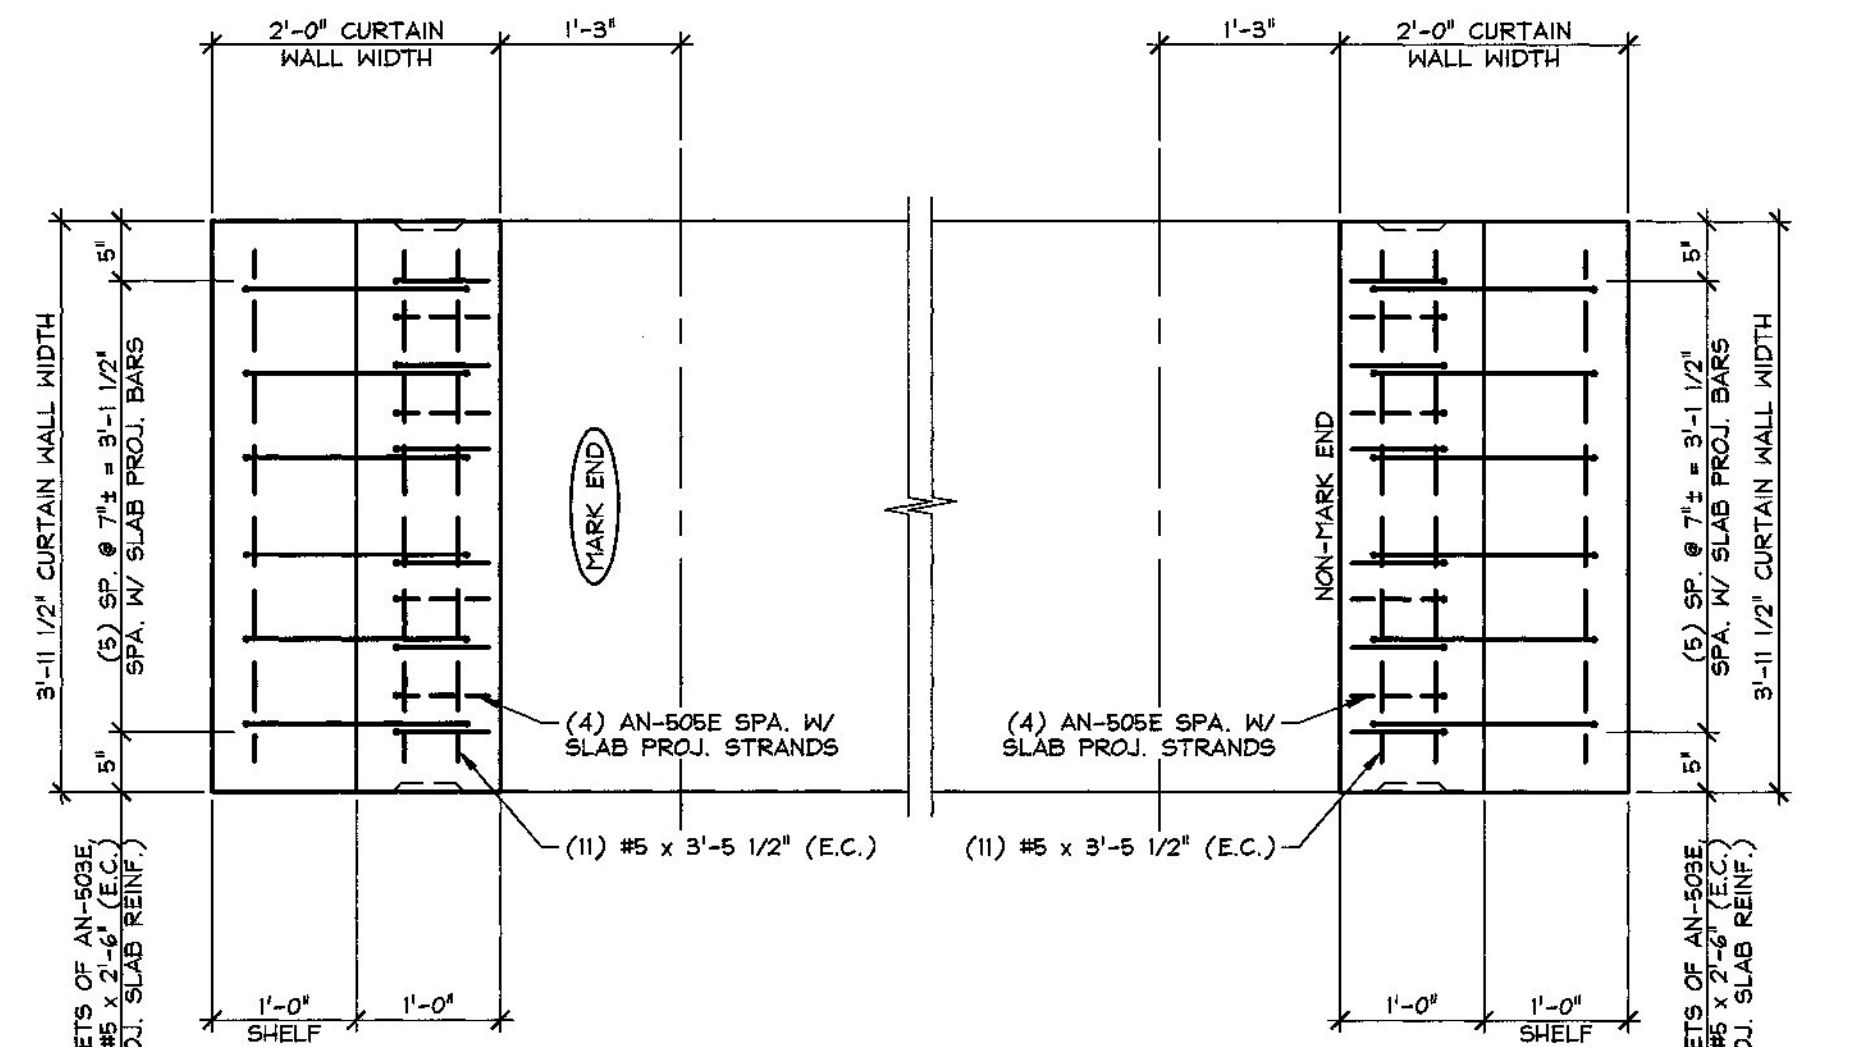


5 REINFORCING PLAN VIEW IN FORM
3/4" = 1'-0"

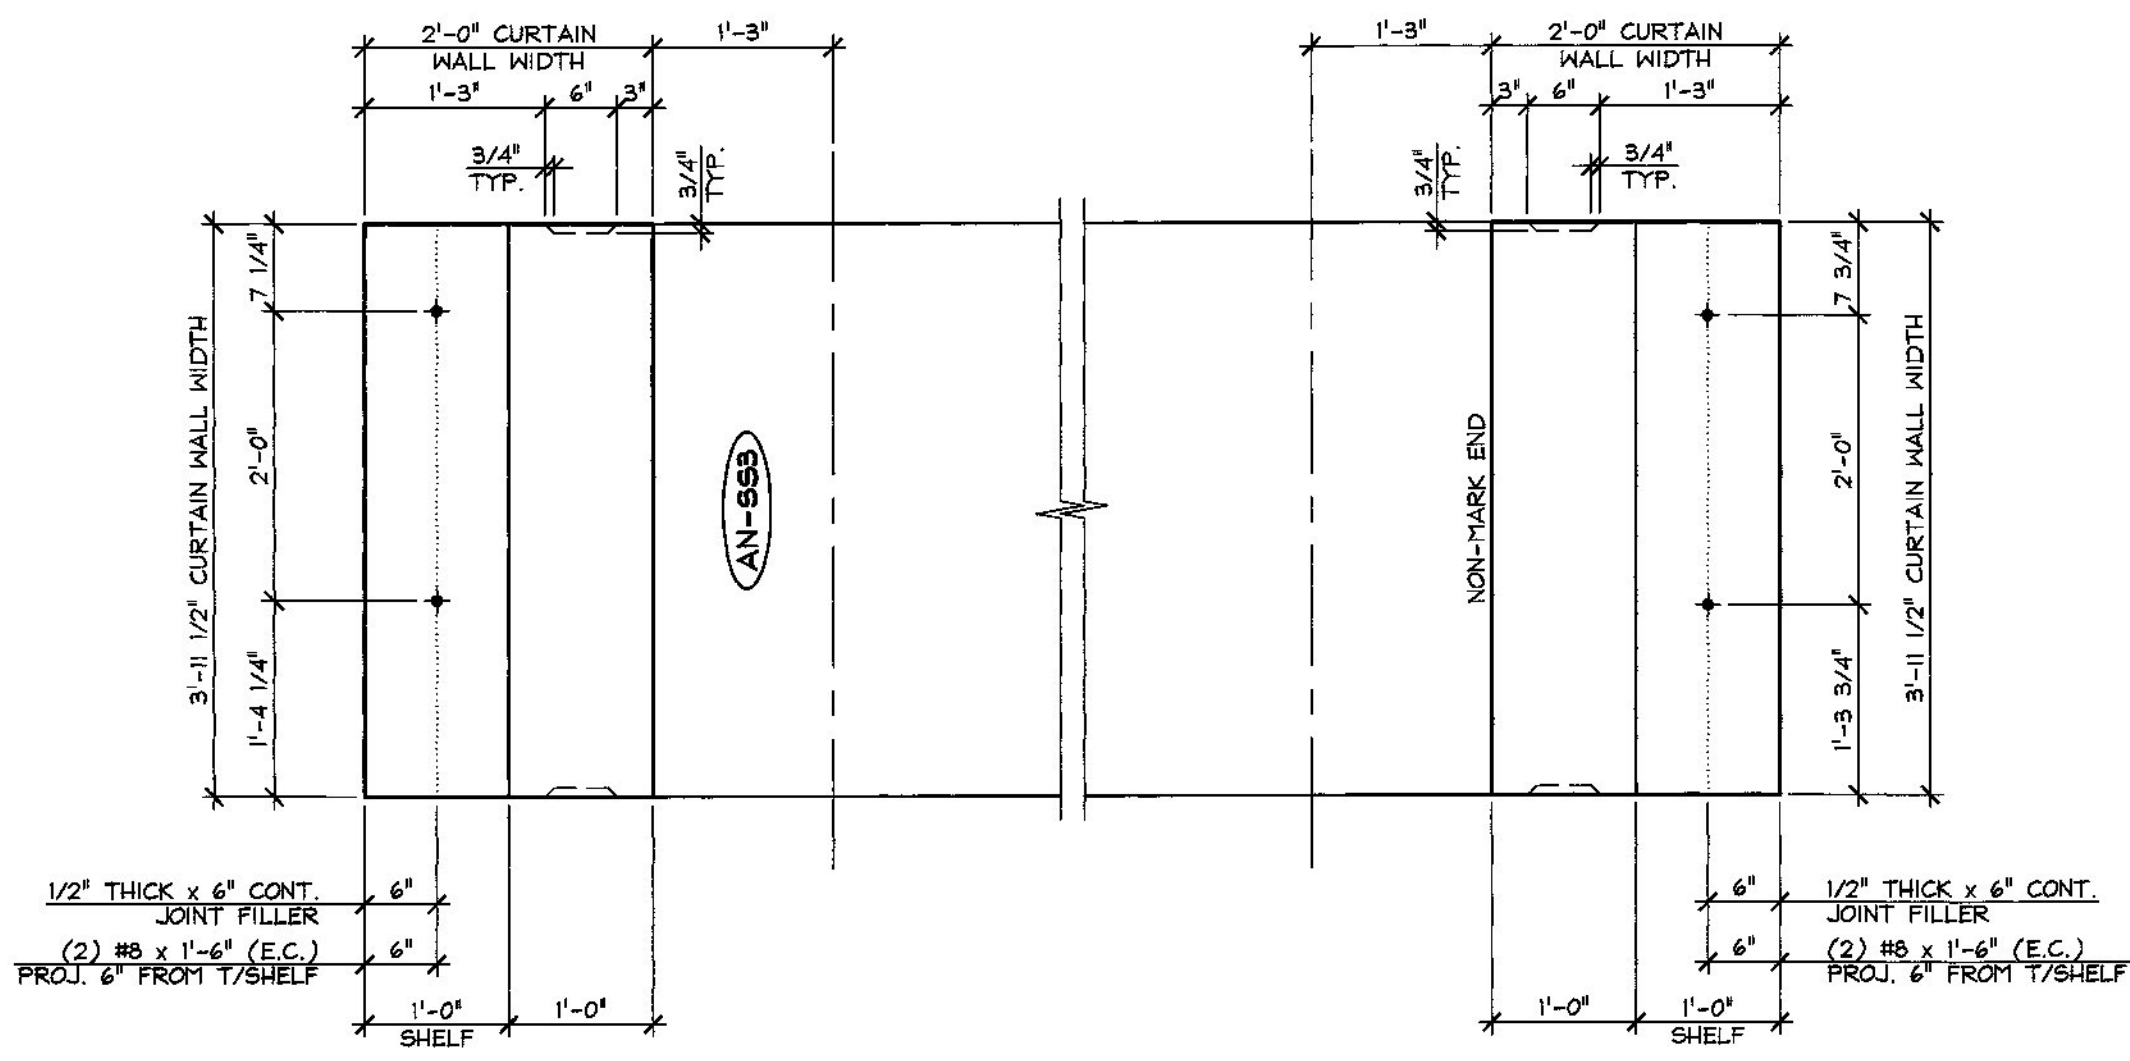

2 DIMENSIONAL PLAN VIEW IN FORM
3/4" = 1'-0"

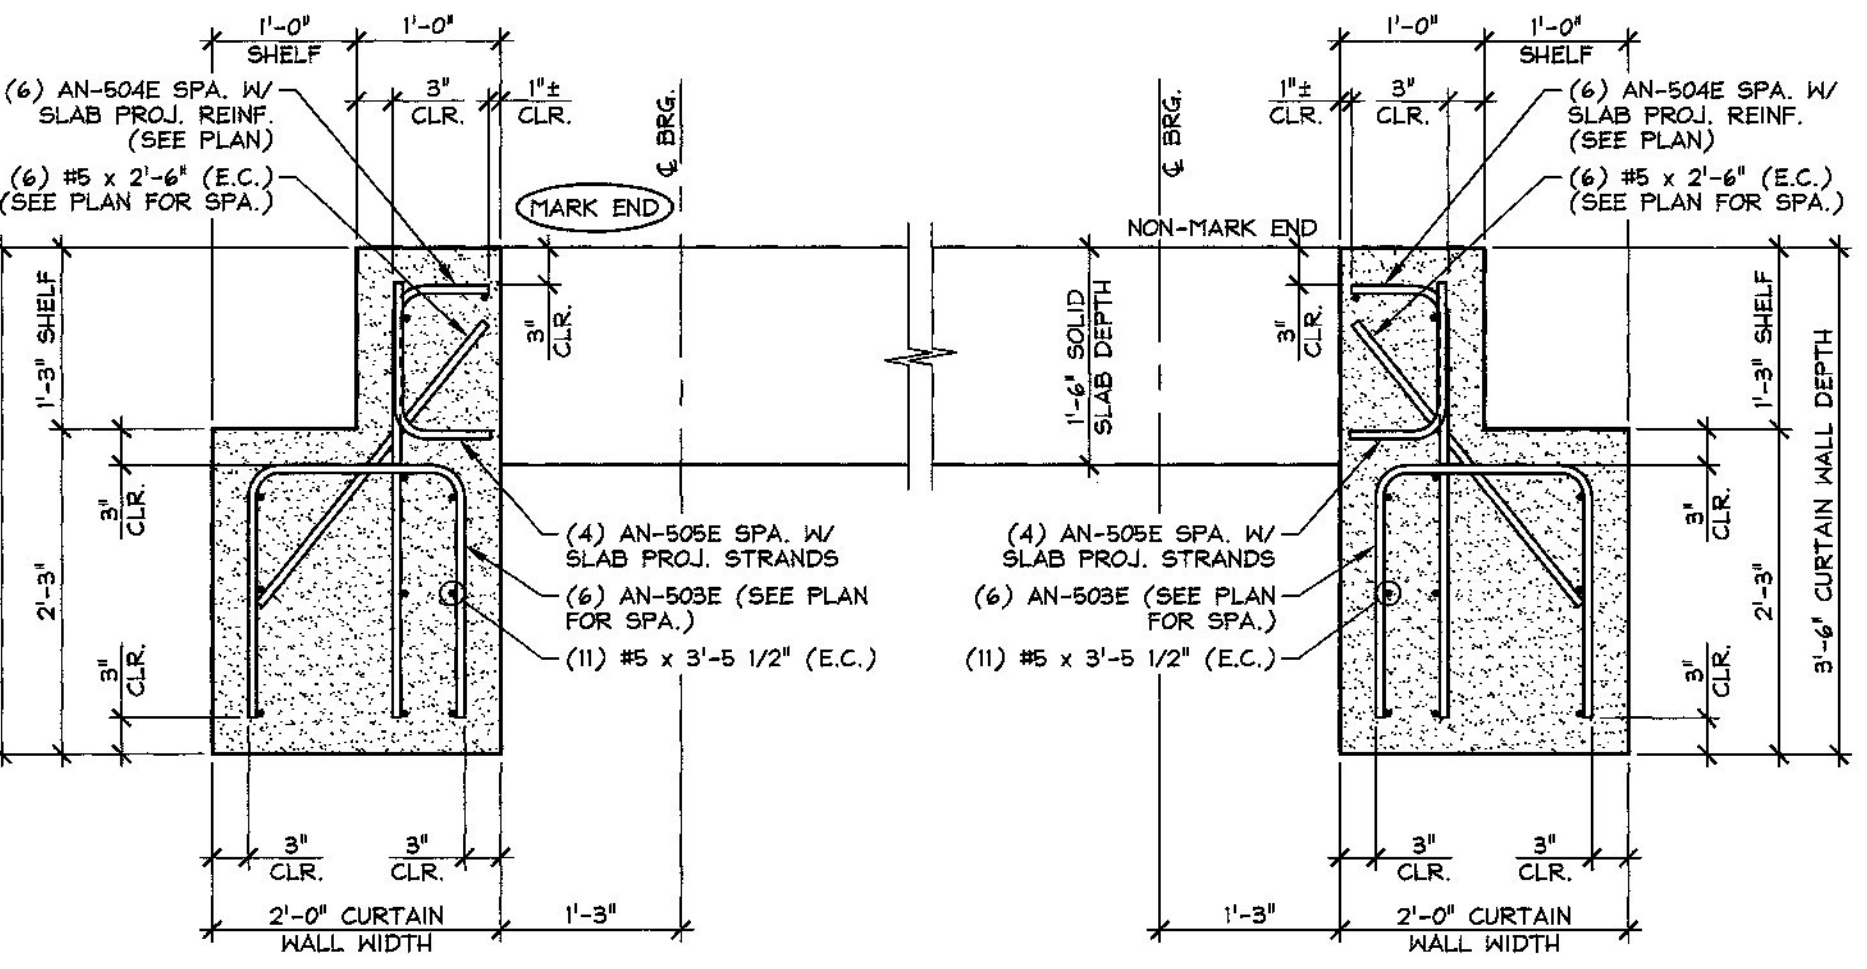

6 REINFORCING SECTION
3/4" = 1'-0"

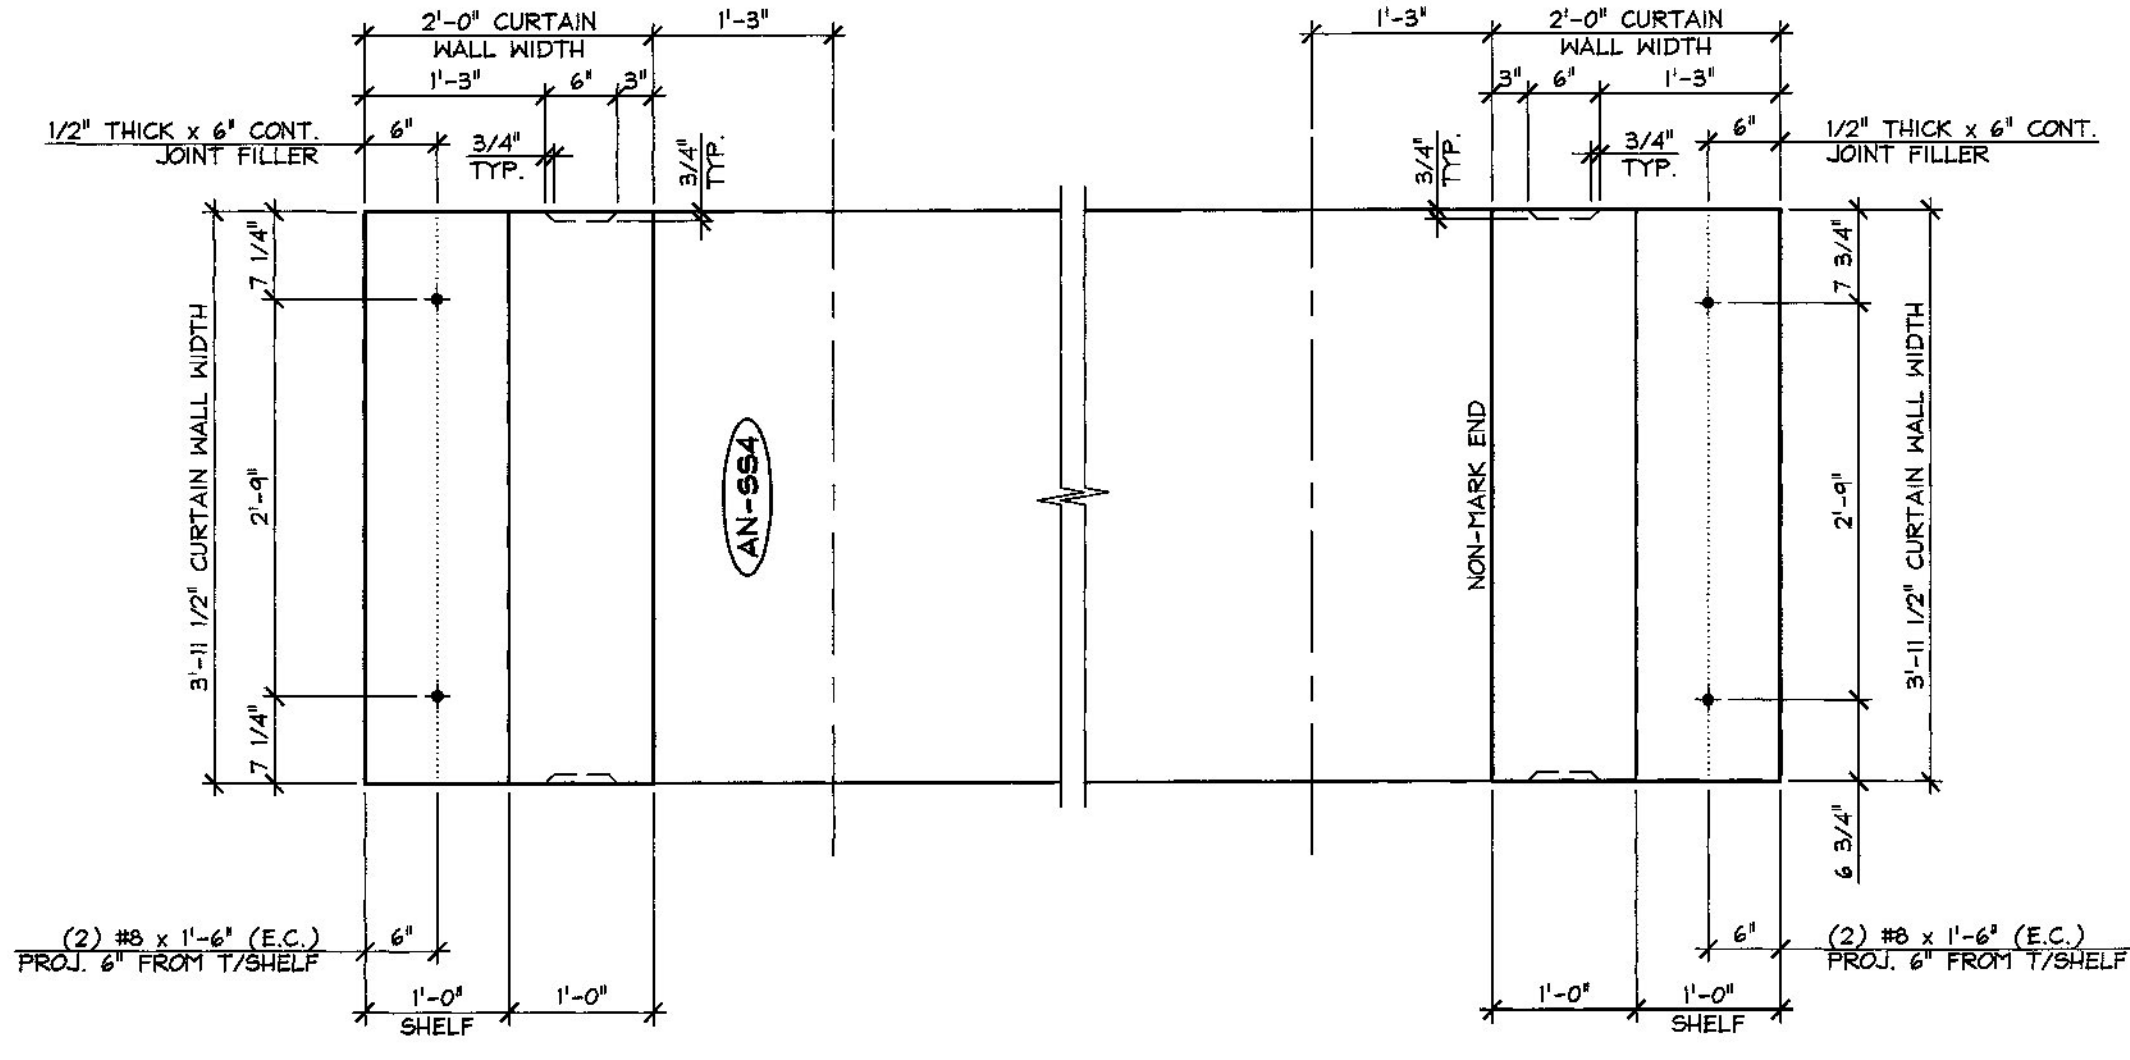

3 DIMENSIONAL PLAN VIEW IN FORM
3/4" = 1'-0"

MARK: AN-SS1	QTY.: 1
MARK: AN-SS3	QTY.: 1
MARK: AN-SS4	QTY.: 1


SHOP NOTE:
TOP OF CURTAIN WALL SHALL
RECEIVE A FINISH MATCHING
SOLID SLAB.

10.01 cy = SOLID SLAB
0.84 cy = CURTAIN WALL (MARK END)
0.84 cy = CURTAIN WALL (NON-MARK END)
11.69 cy = TOTAL SLAB VOL.

20.27 T = SOLID SLAB
1.71 T = CURTAIN WALL (MARK END)
1.71 T = CURTAIN WALL (NON-MARK END)
23.69 T = TOTAL SLAB WT.

MATERIAL LIST / CURTAIN WALL				
ITEM	MARK	DESCRIPTION	QTY./CURTAIN WALL	
			MARK END	NON-MARK END
1	AN-503E	#5 BENT BAR (LEVEL 1, EPOXY COATED)	6	6
2	AN-504E	#5 BENT BAR (LEVEL 1, EPOXY COATED)	6	6
3	AN-505E	#5 BENT BAR (LEVEL 1, EPOXY COATED)	4	4
4		#5 x 2'-6" (LEVEL 1, EPOXY COATED)	6	6
5		#5 x 3'-5 1/2" (LEVEL 1, EPOXY COATED)	11	11
6				
7		#8 x 1'-6" (LEVEL 1, EPOXY COATED)	2	2
8				

Vermont Agency of Transportation
RECEIVED
ON: June 10, 2015
and Checked for
CONFORMANCE
BY: D. PETERSON DATE: 06/11/2015

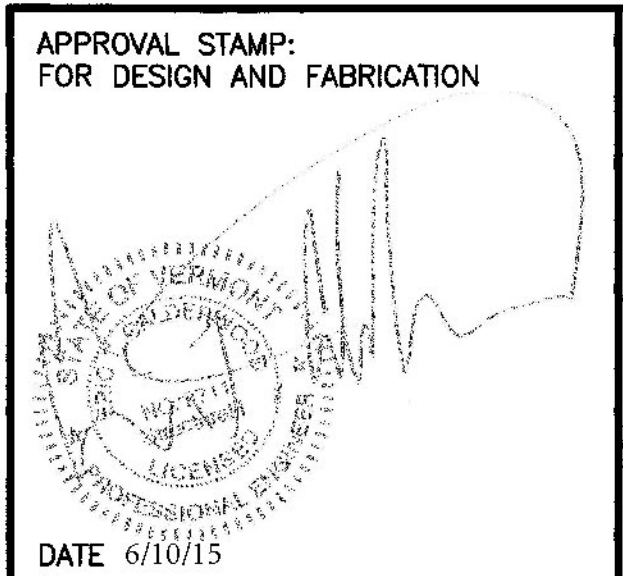

APPROVAL STAMP: FOR DESIGN AND FABRICATION	J.P. CARRARA & SONS INC. Precast & Prestress Manufacturer 2464 CASE STR. WOODBURY, VERMONT 05753 Phone: (802)388-6361 Fax: (802)388-9010	RENAUD BROS. INC. CONTRACTOR VERNON, VERMONT
STATE OF VERMONT AGENCY OF TRANSPORTATION COUNTY OF WINDSOR	DATE: MAY 6, 2015	SCALE: NOTED
TOWN OF ANDOVER VT RTE 11, RURAL MINOR ARTERIAL BRIDGE NO.: 41 PROJECT NO.: BHF 016-1(29)	CHKD: J.C. DFTM: B.L.	JOB NO: 23465-015
PRECAST CURTAIN WALL DETAILS	DWG. NO: CW1	