




1 DIMENSIONAL PLAN VIEW IN FORM
CW2 3/4" = 1'-0"

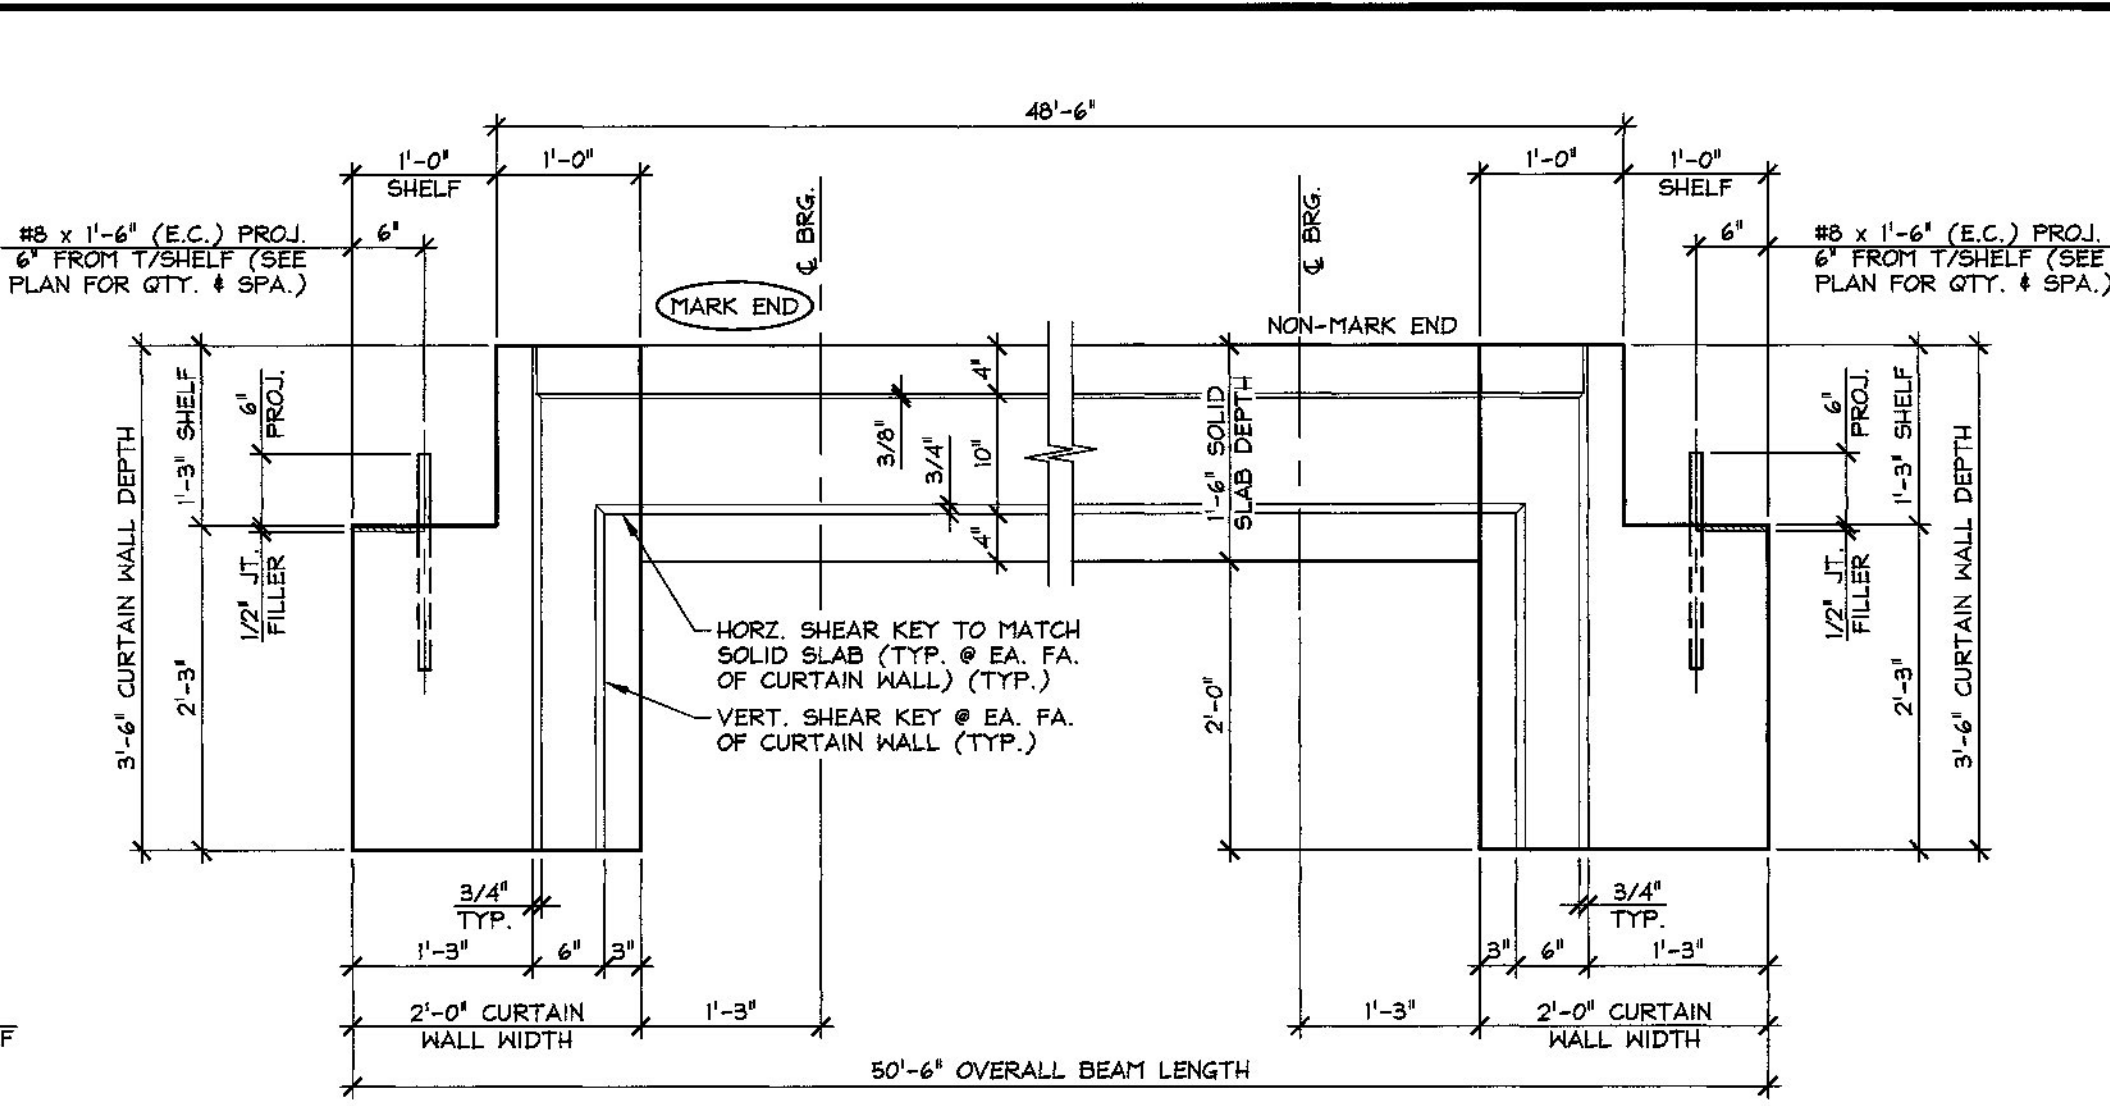


4 DIMENSIONAL ELEVATION
CW2 3/4" = 1'-0"

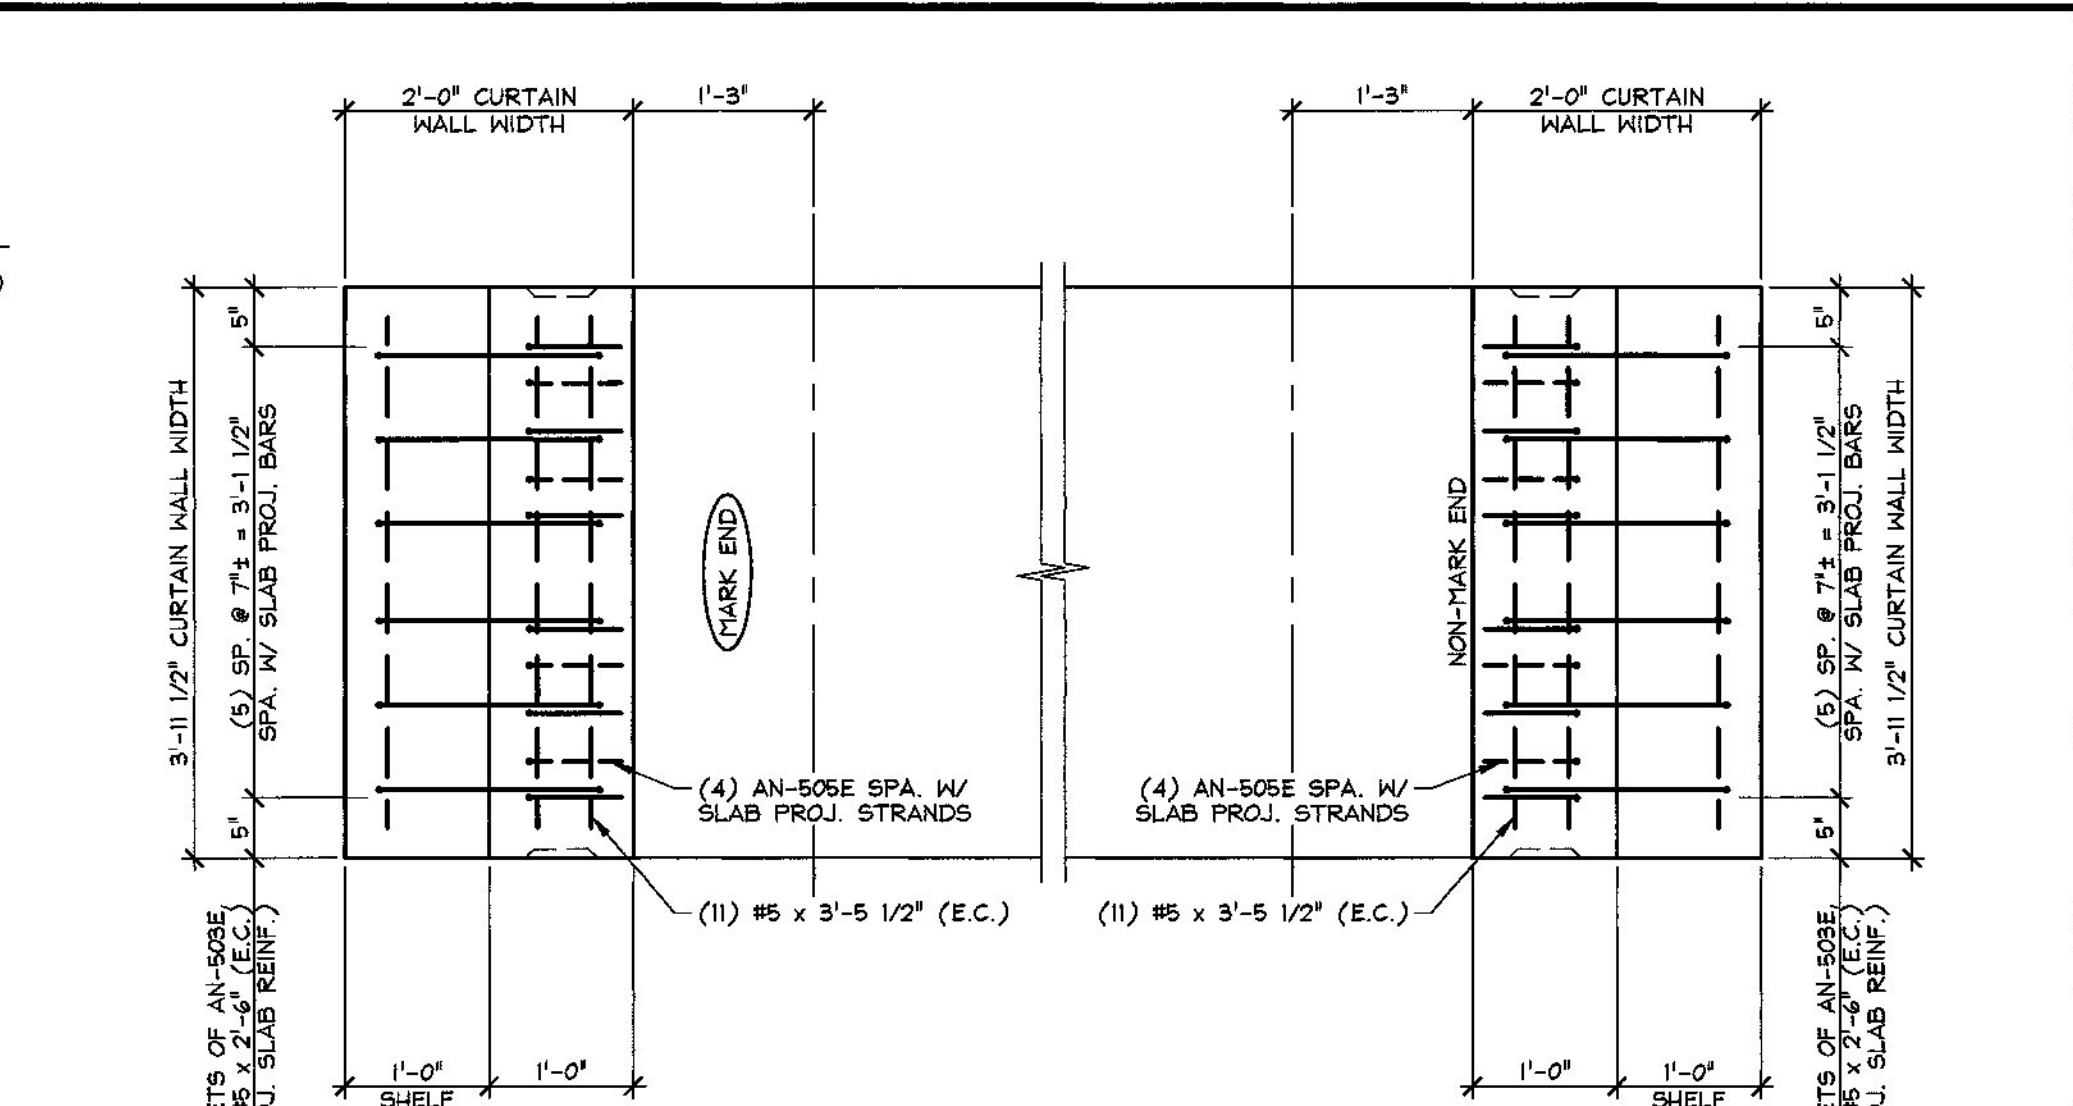

5 REINFORCING PLAN VIEW IN FORM
CW2 3/4" = 1'-0"

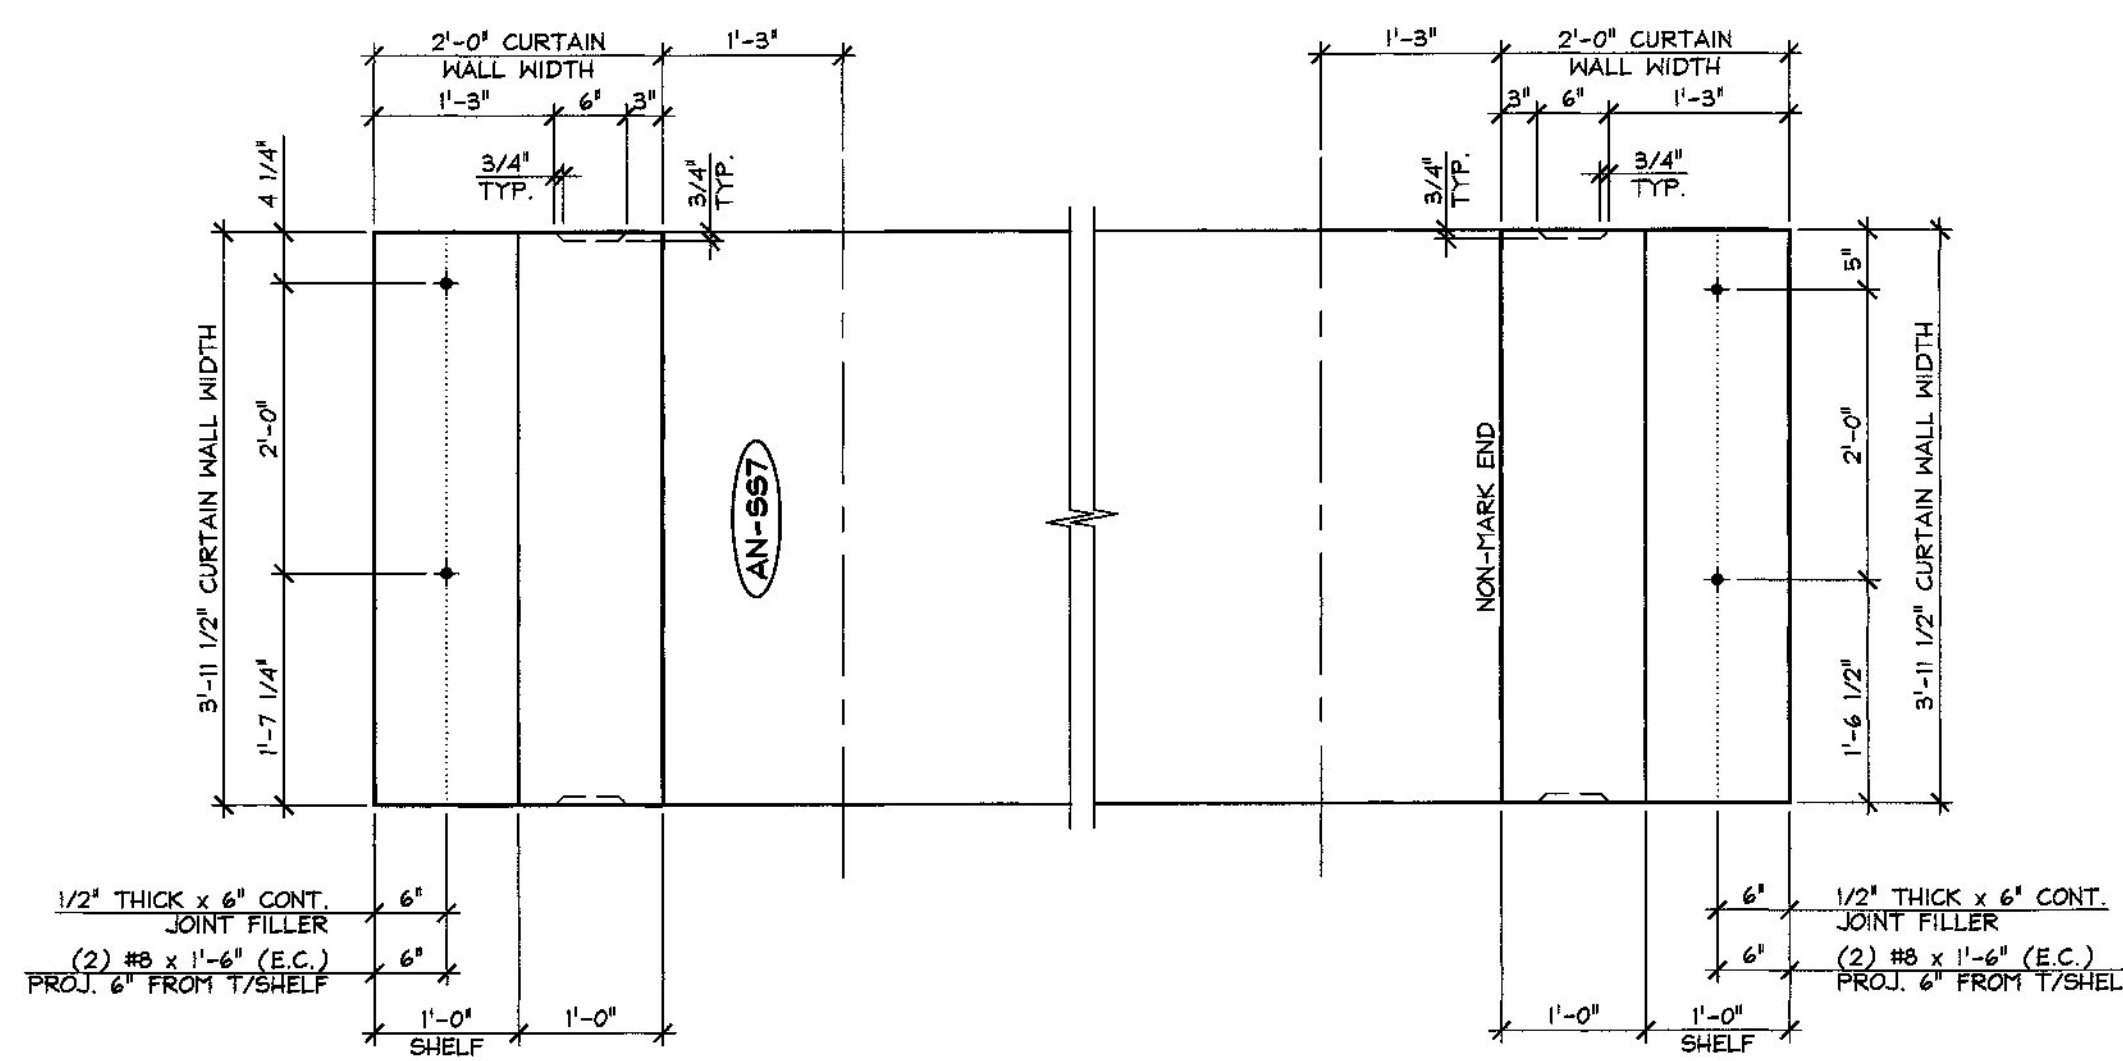

2 DIMENSIONAL PLAN VIEW IN FORM
CW2 3/4" = 1'-0"

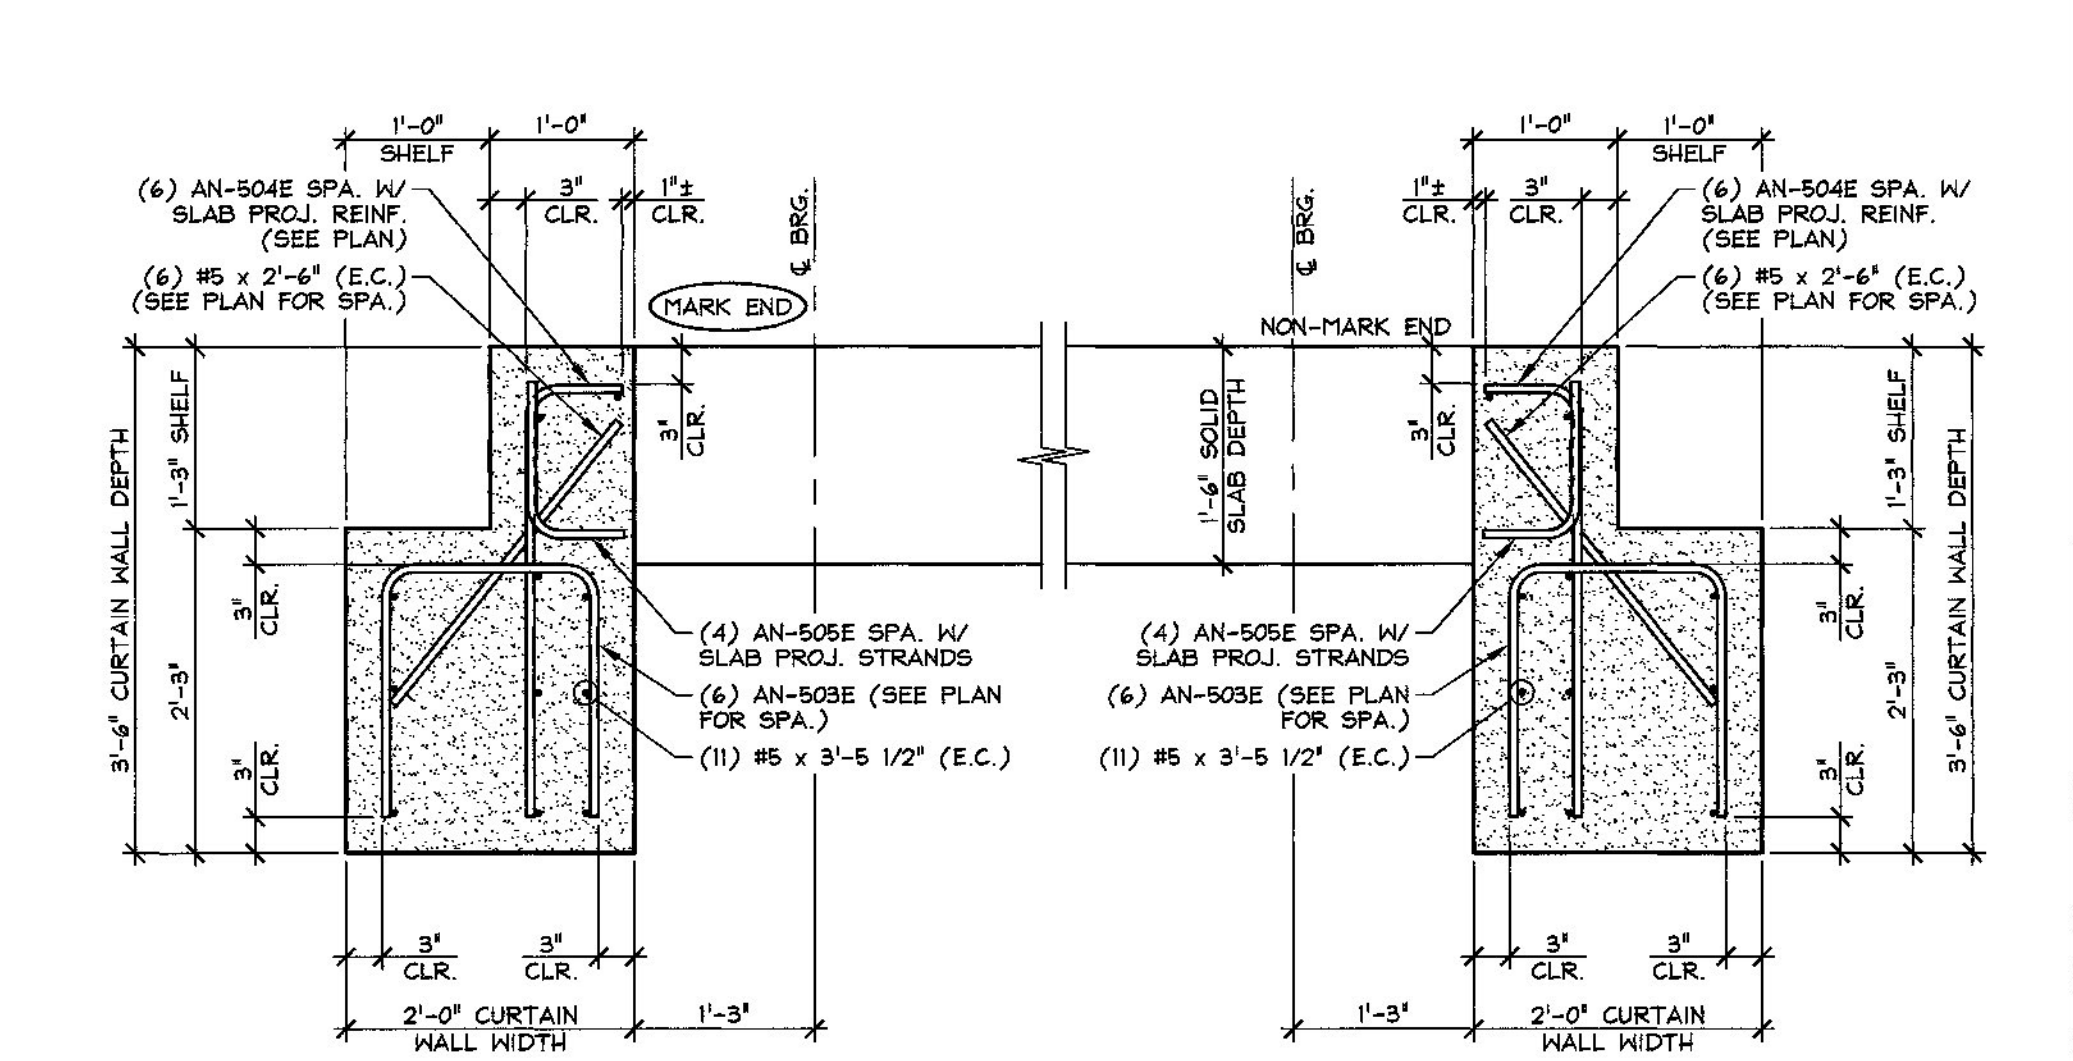

6 REINFORCING SECTION
CW2 3/4" = 1'-0"

MARK: AN-SS5	QTY.: 1
MARK: AN-SS7	QTY.: 1
MARK:	QTY.:

SHOP NOTE:
TOP OF CURTAIN WALL SHALL RECEIVE A FINISH MATCHING SOLID SLAB.

10.01 cy = SOLID SLAB
0.84 cy = CURTAIN WALL (MARK END)
0.84 cy = CURTAIN WALL (NON-MARK END)
11.69 cy = TOTAL SLAB VOL.


20.27 T = SOLID SLAB
1.71 T = CURTAIN WALL (MARK END)
1.71 T = CURTAIN WALL (NON-MARK END)
23.69 T = TOTAL SLAB WT.

MATERIAL LIST / CURTAIN WALL				
ITEM	MARK	DESCRIPTION	QTY./CURTAIN WALL	
			MARK END	NON-MARK END
1	AN-505E	#5 BENT BAR (LEVEL 1, EPOXY COATED)	6	6
2	AN-504E	#5 BENT BAR (LEVEL 1, EPOXY COATED)	6	6
3	AN-505E	#5 BENT BAR (LEVEL 1, EPOXY COATED)	4	4
4		#5 x 2'-6" (LEVEL 1, EPOXY COATED)	6	6
5		#5 x 3'-5 1/2" (LEVEL 1, EPOXY COATED)	11	11
6				
7		#8 x 1'-6" (LEVEL 1, EPOXY COATED)	2	2
8				

Vermont Agency of Transportation
RECEIVED
ON: June 10, 2015
and Checked for
CONFORMANCE
BY: D. PETERSON DATE: 06/11/2015

THIS PLAN NOT USED

3 DIMENSIONAL PLAN VIEW IN FORM
CW2 3/4" = 1'-0"

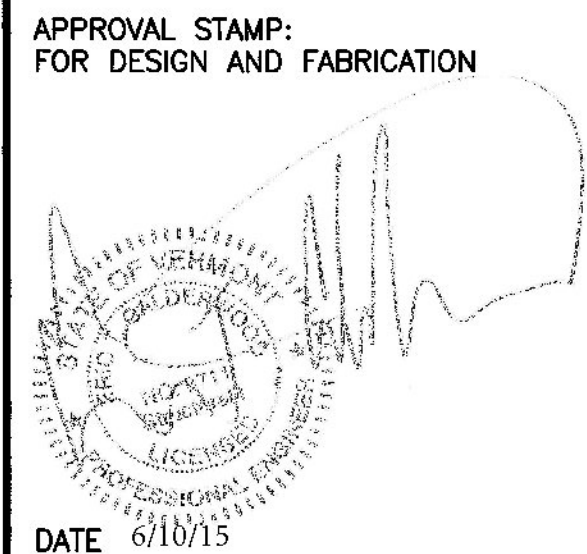

J.P. CARRARA & SONS INC.
Precast & Prestress Manufacturer
284 CASE STR., MIDDLEBURY, VERMONT 05753 Phone: (802)388-6381 Fax: (802)388-9010

RENAUD BROS. INC.
CONTRACTOR
VERNON, VERMONT

STATE OF VERMONT AGENCY OF TRANSPORTATION
COUNTY OF WINDSOR

TOWN OF ANDOVER
VT RTE 11, RURAL MINOR ARTERIAL
BRIDGE NO.: 41 PROJECT NO.: BHF 016-1(29)

DATE: MAY 6, 2015
SCALE: NOTED
CHKD: J.C. DFTM: B.L.
JOB NO: 23465-015
DWG. NO: CW2

PRECAST CURTAIN WALL DETAILS