




1 DIMENSIONAL PLAN VIEW IN FORM  
CW3 3/4" = 1'-0"

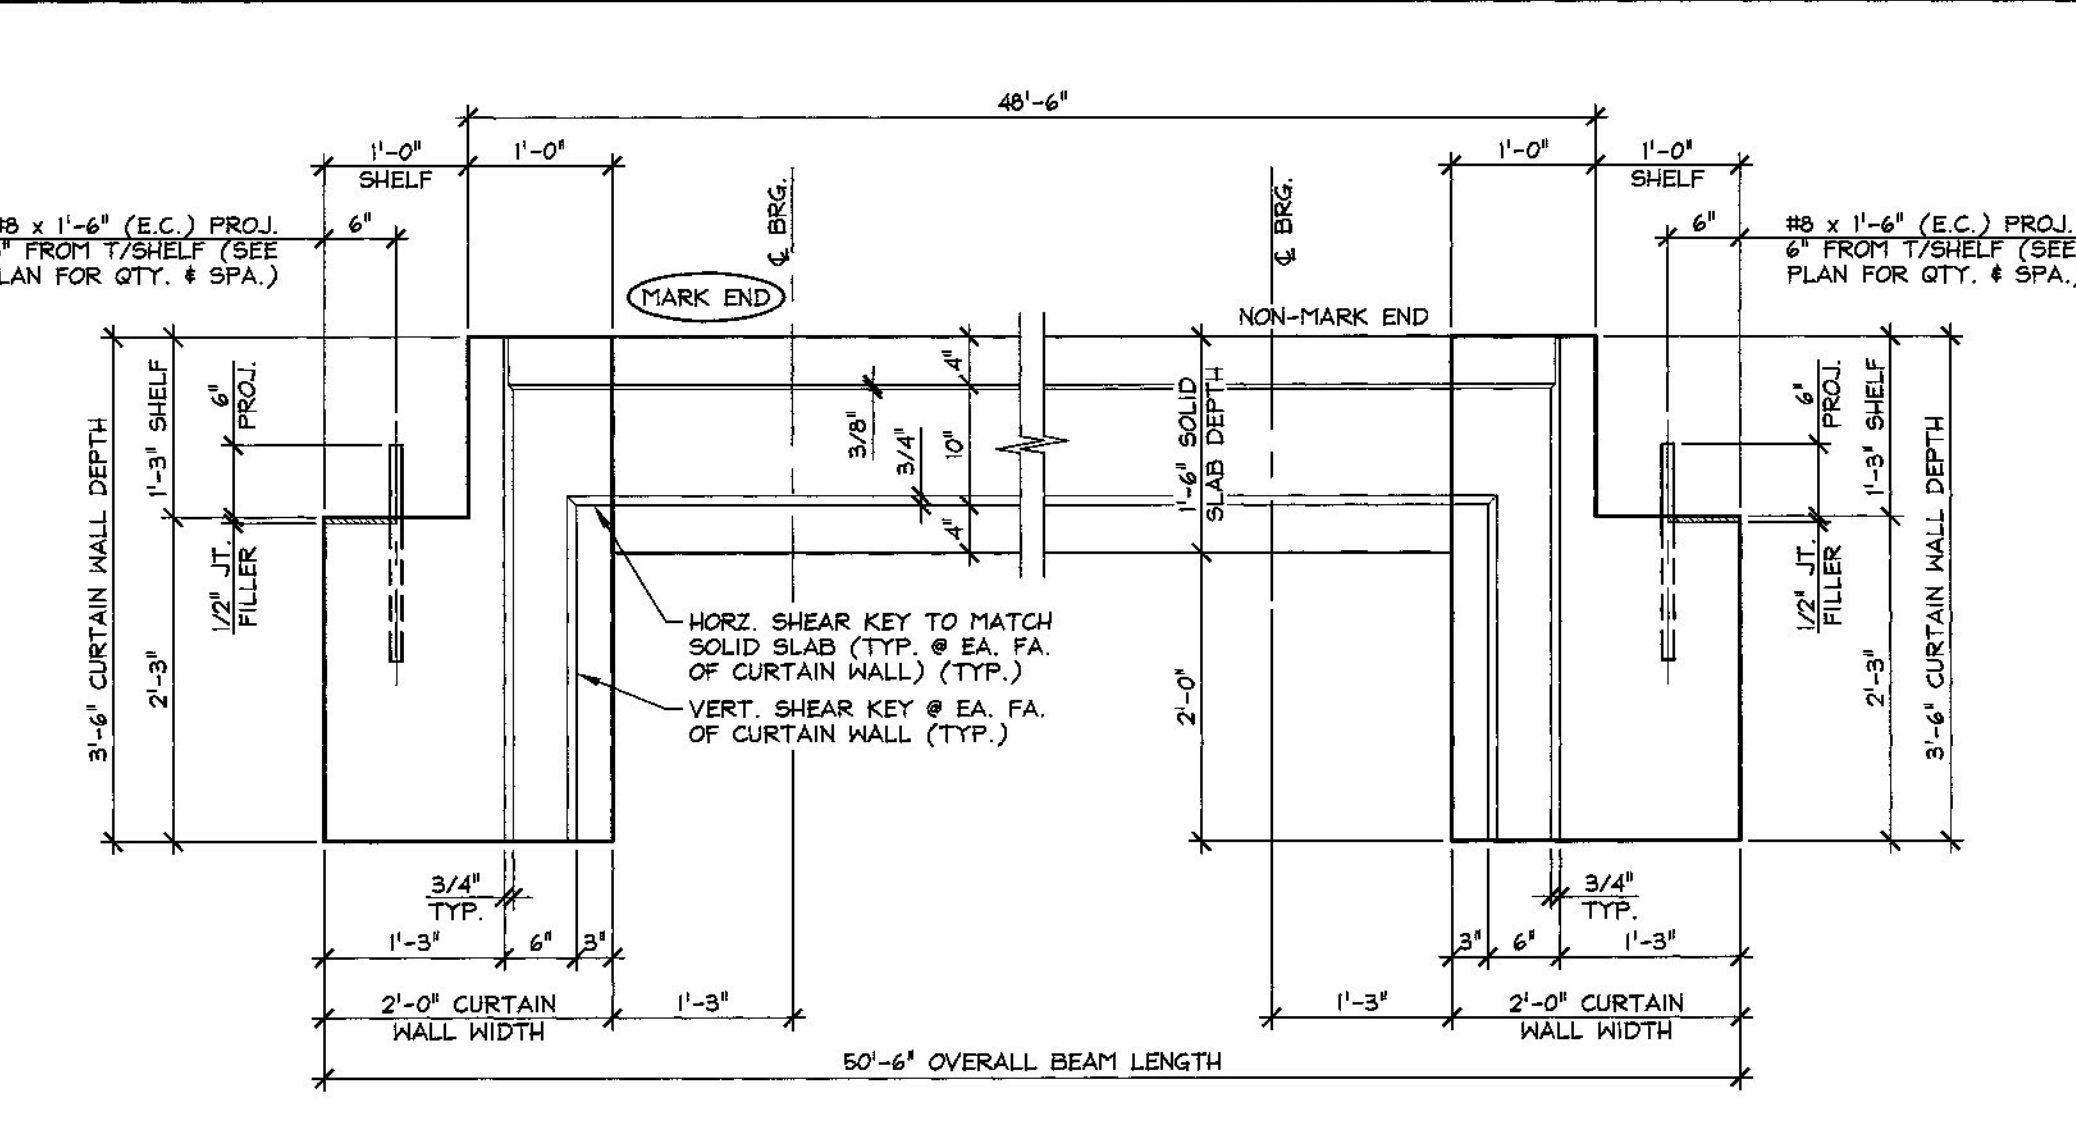


4 DIMENSIONAL ELEVATION  
CW3 3/4" = 1'-0"

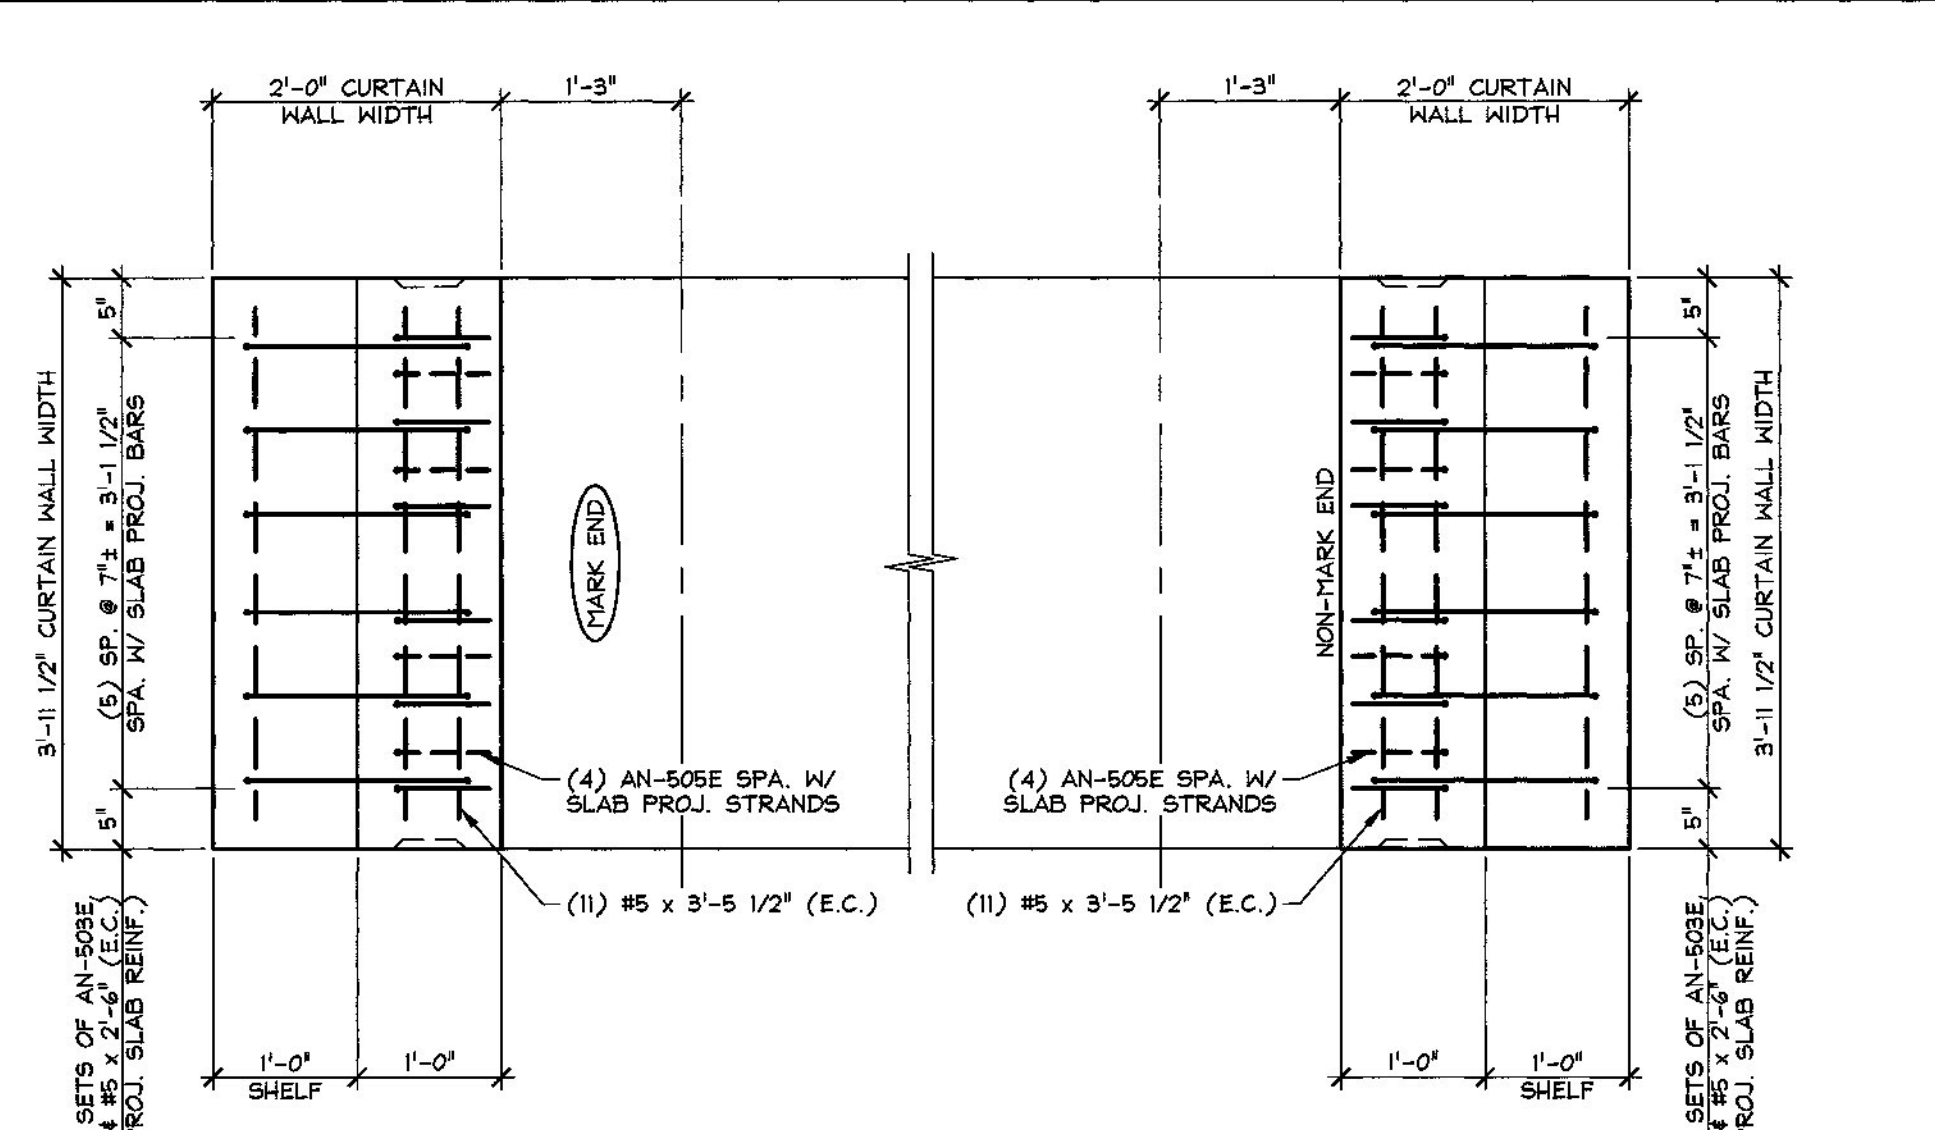


5 REINFORCING PLAN VIEW IN FORM  
CW3 3/4" = 1'-0"

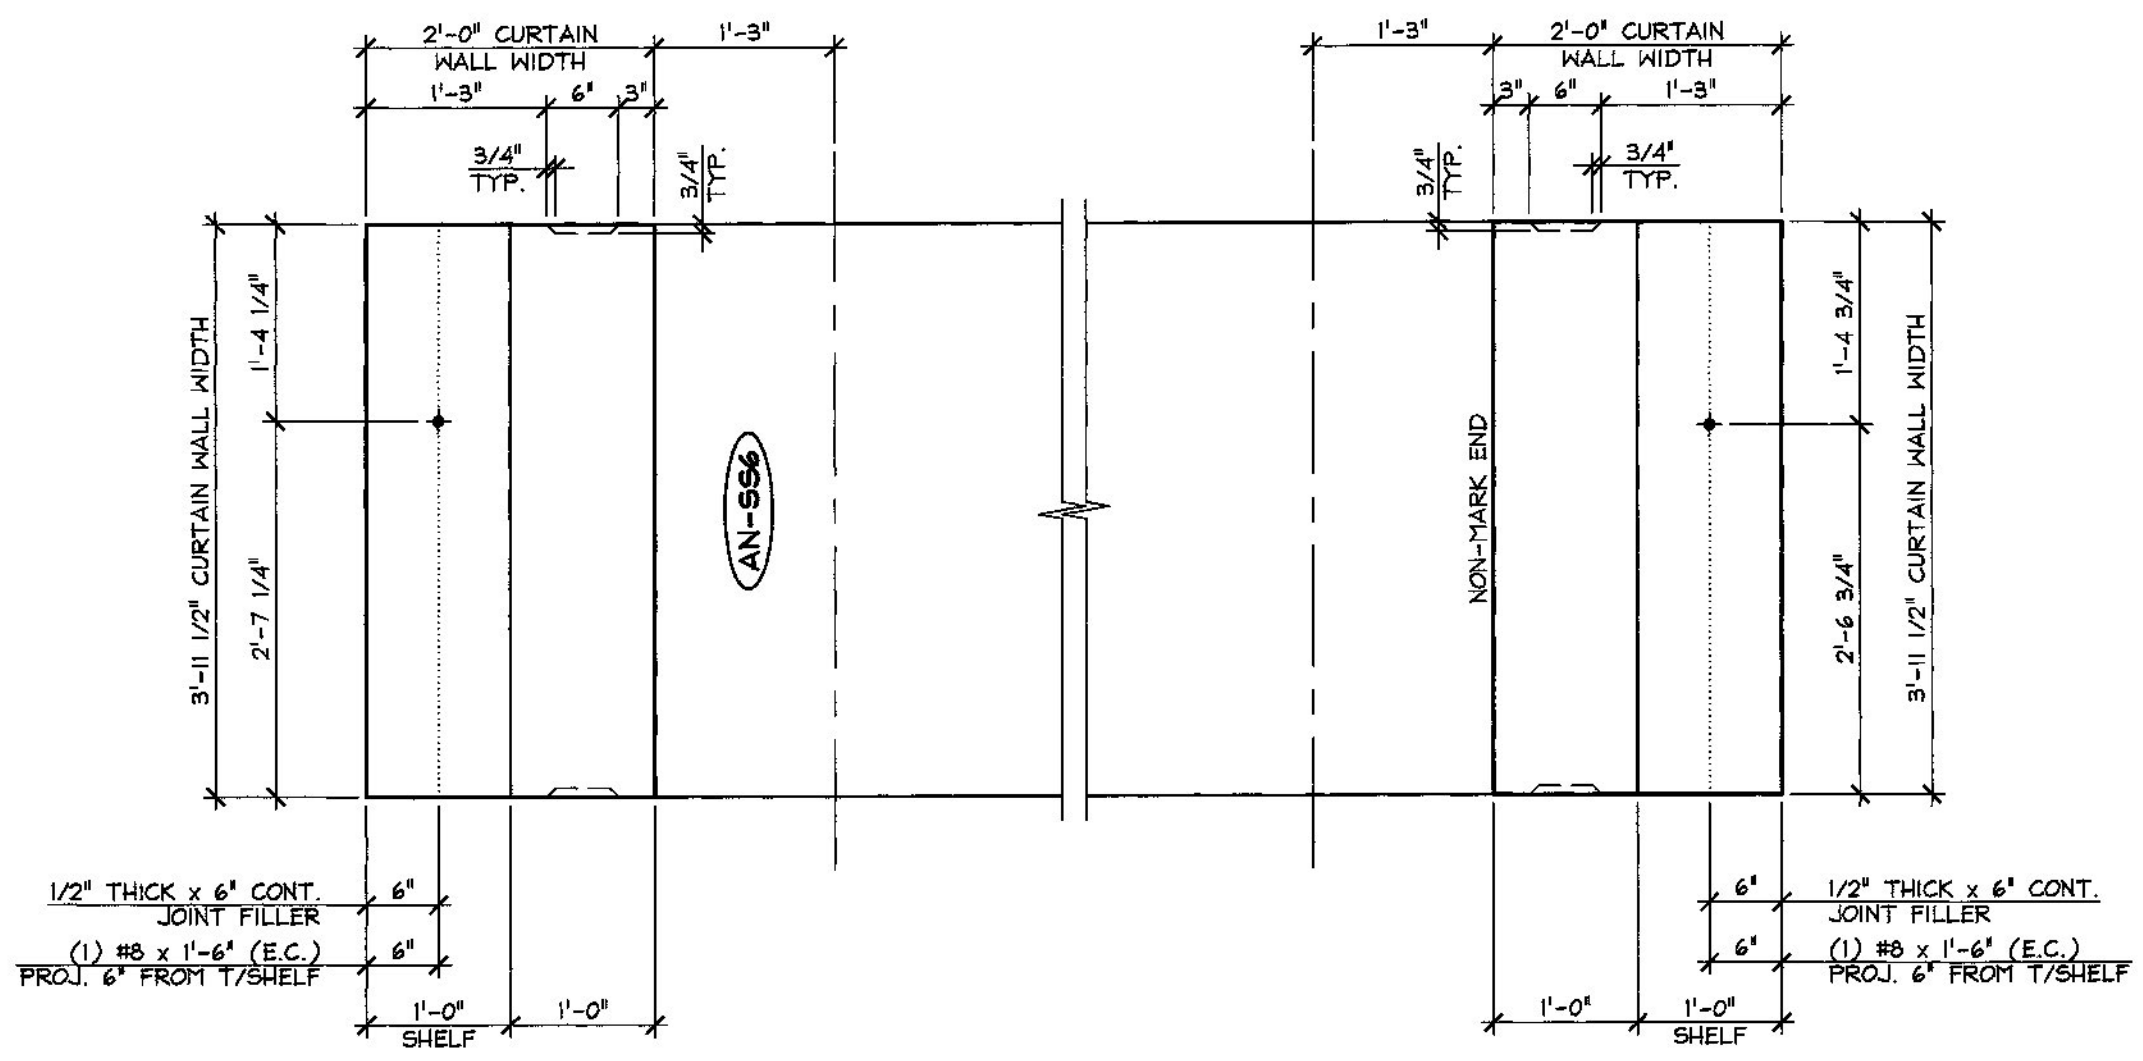

2 DIMENSIONAL PLAN VIEW IN FORM  
CW3 3/4" = 1'-0"

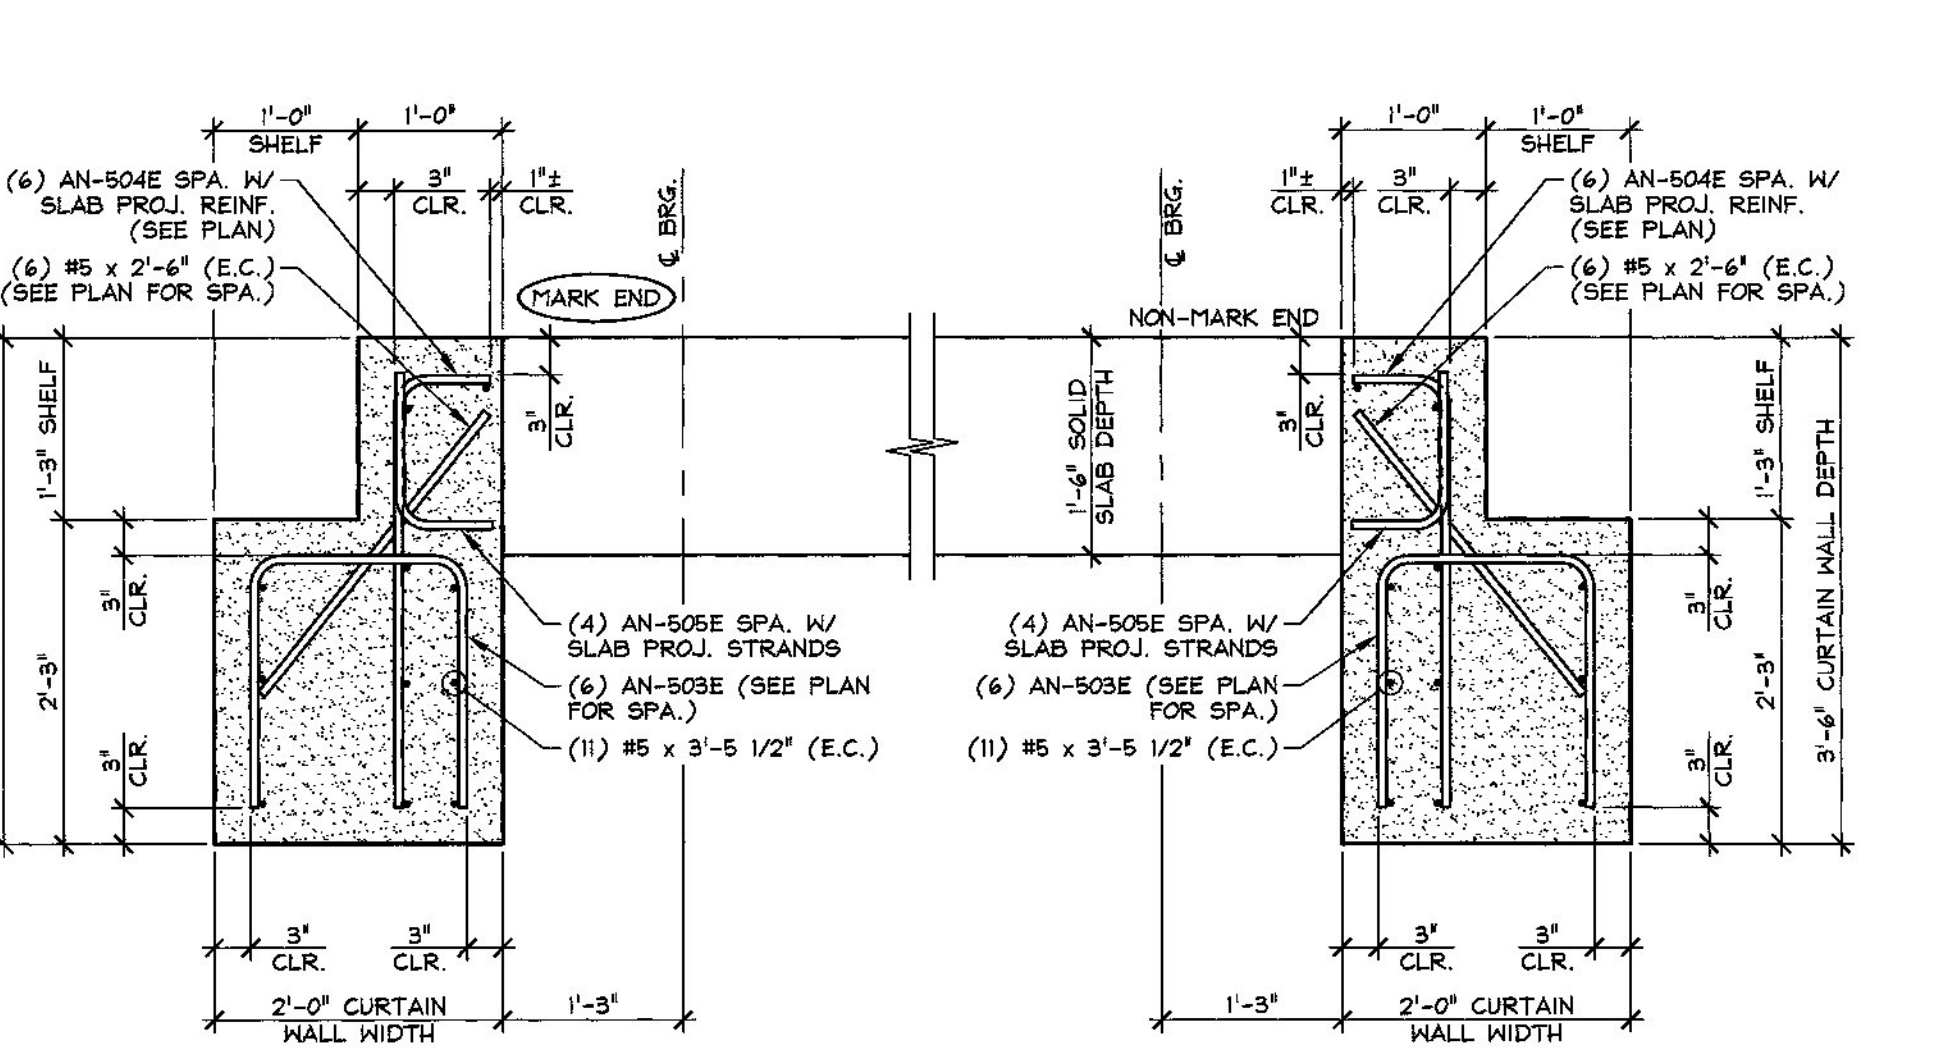

6 REINFORCING SECTION  
CW3 3/4" = 1'-0"

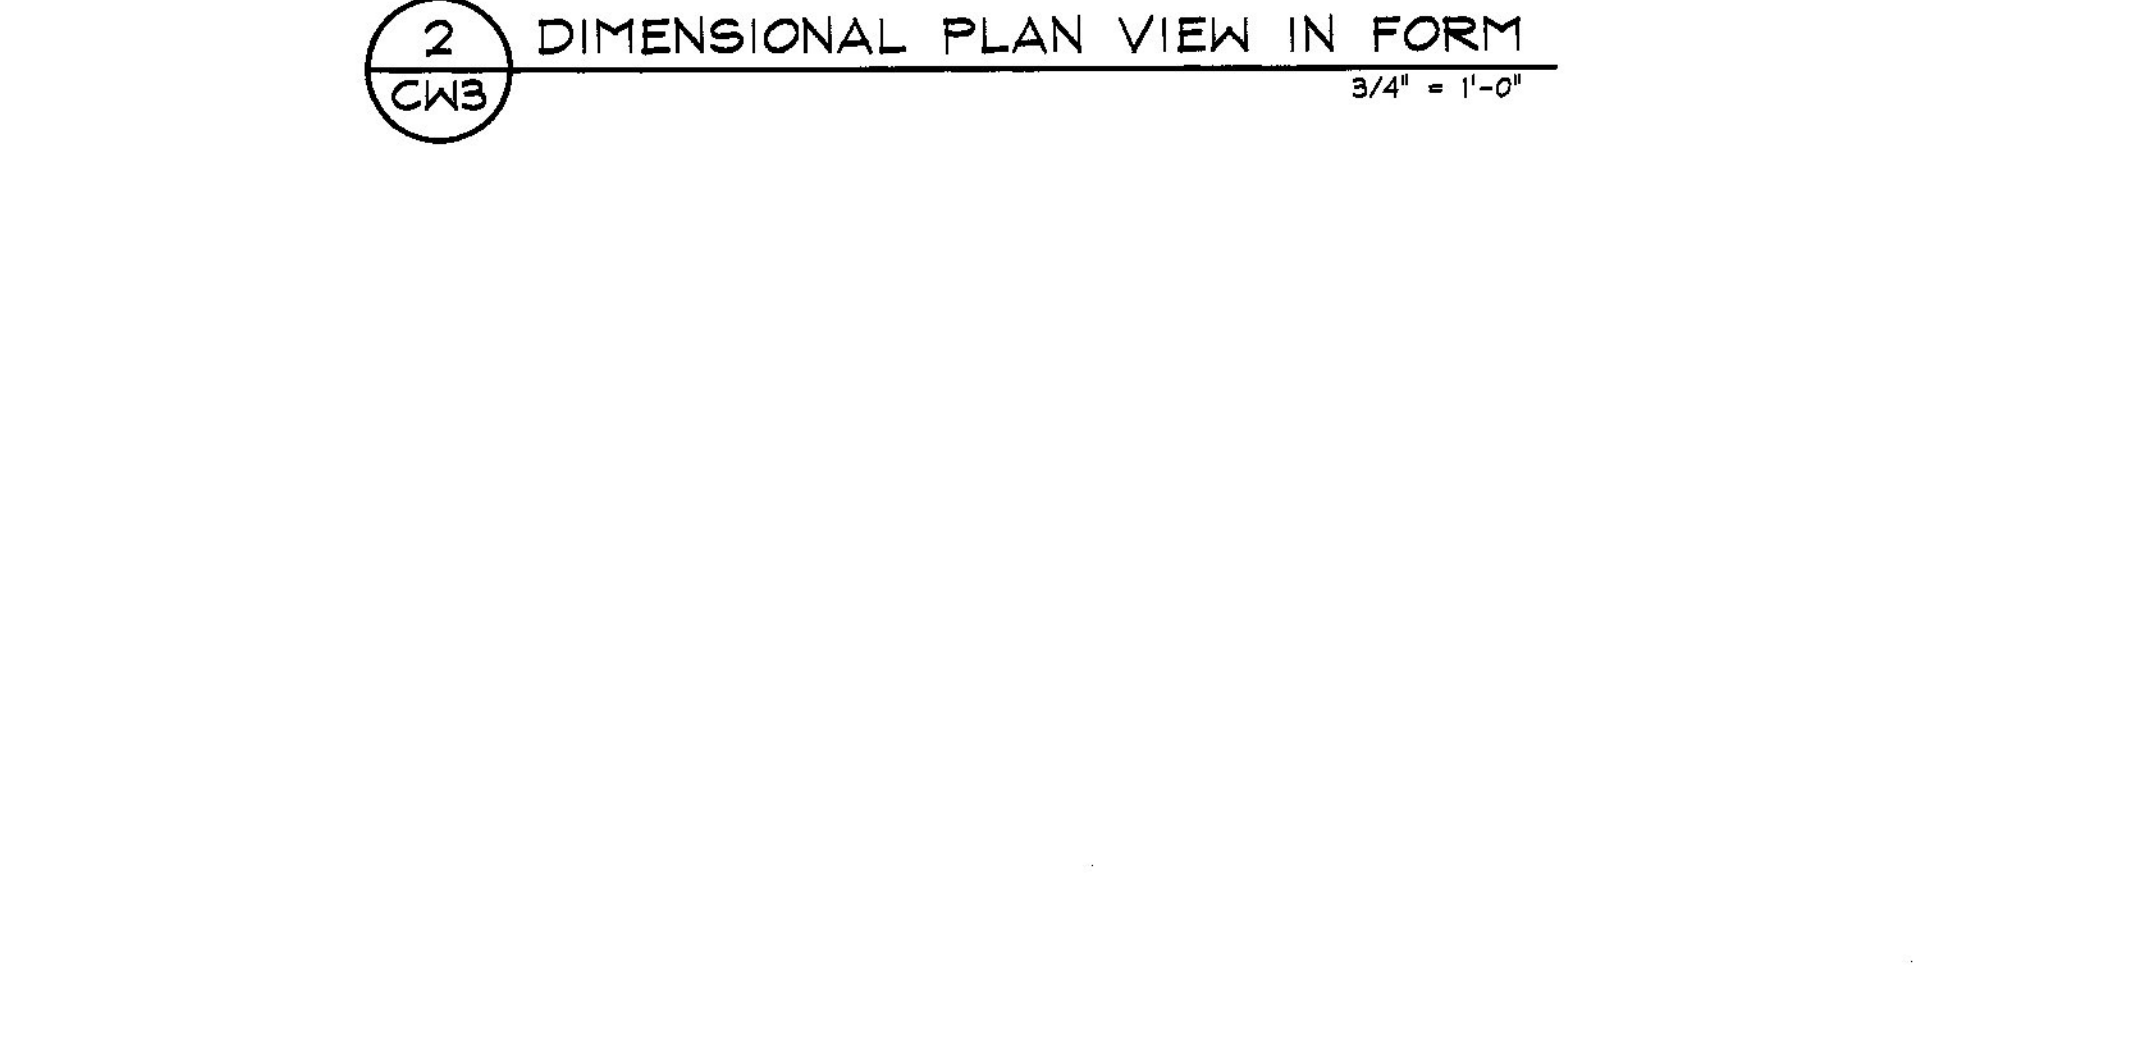

3 DIMENSIONAL PLAN VIEW IN FORM  
CW3 3/4" = 1'-0"

THIS PLAN NOT USED

Vermont Agency of Transportation  
**RECEIVED**  
ON: June 10, 2015  
and Checked for  
**CONFORMANCE**  
BY: D. PETERSON DATE: 06/11/2015

10.01 cy = SOLID SLAB  
0.84 cy = CURTAIN WALL (MARK END)  
0.84 cy = CURTAIN WALL (NON-MARK END)  
11.69 cy = TOTAL SLAB VOL.

20.27 T = SOLID SLAB  
1.71 T = CURTAIN WALL (MARK END)  
1.71 T = CURTAIN WALL (NON-MARK END)  
23.69 T = TOTAL SLAB WT.

MARK: AN-SS2	QTY.: 1
MARK: AN-SS6	QTY.: 1
MARK:	QTY.:

SHOP NOTE:  
TOP OF CURTAIN WALL SHALL  
RECEIVE A FINISH MATCHING  
SOLID SLAB.

MATERIAL LIST / CURTAIN WALL				
ITEM	MARK	DESCRIPTION	QTY./CURTAIN WALL	
			MARK END	NON-MARK END
1	AN-503E	#5 BENT BAR (LEVEL 1, EPOXY COATED)	6	6
2	AN-504E	#5 BENT BAR (LEVEL 1, EPOXY COATED)	6	6
3	AN-505E	#5 BENT BAR (LEVEL 1, EPOXY COATED)	4	4
4		#5 x 2'-6" (LEVEL 1, EPOXY COATED)	6	6
5		#5 x 3'-5 1/2" (LEVEL 1, EPOXY COATED)	11	11
6				
7	#8 x 1'-6" (LEVEL 1, EPOXY COATED)		1	1
8				

APPROVAL STAMP:  
FOR DESIGN AND FABRICATION  
DATE 6/10/15

**J.P. CARRARA & SONS INC.**  
Precast & Prestress Manufacturer  
2444 CASE STR., MIDDLEBURY, VERMONT 05753 Phone: (802)388-6361 Fax: (802)388-8010

RENAUD BROS., INC.  
CONTRACTOR  
VERNON, VERMONT

STATE OF VERMONT AGENCY OF TRANSPORTATION  
COUNTY OF WINDSOR

TOWN OF ANDOVER  
VT RTE 11, RURAL MINOR ARTERIAL  
BRIDGE NO.: 41 PROJECT NO.: BHF 016-1(29)

DATE: MAY 6, 2015  
SCALE: NOTED  
CHKD: J.C. DFTM: B.L.  
JOB NO: 23465-015  
DWG. NO: CW3

PRECAST CURTAIN WALL DETAILS