




AN-401E
#4 BENT BAR
LEVEL I (EPOXY COATED)
USE 2" Ø (50 mm) PIN
(603) REQ'D.

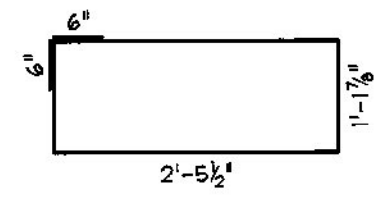

AN-402E
#4 BENT BAR
LEVEL I (EPOXY COATED)
USE 2" Ø (50 mm) PIN
(180) REQ'D.

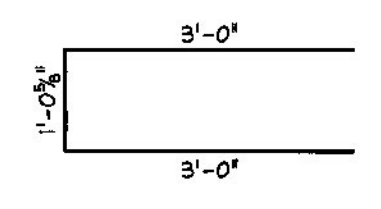


AN-403E
#4 BENT BAR
LEVEL I (EPOXY COATED)
USE 2" Ø (50 mm) PIN
(72) REQ'D.

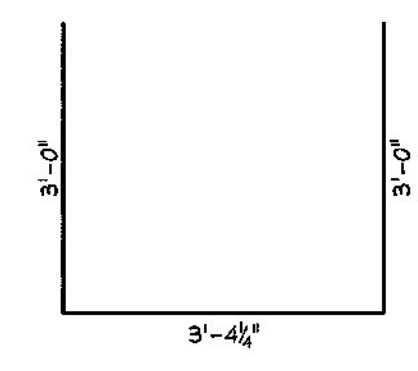


AN-404E
#4 BENT BAR
LEVEL I (EPOXY COATED)
USE 2" Ø (50 mm) PIN
(36) REQ'D.

THIS DETAIL NOT USED


AN-501E

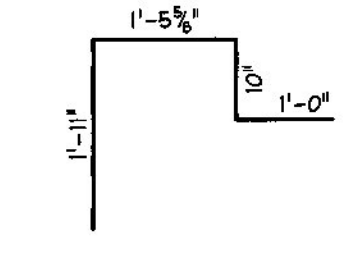

AN-502E
#5 BENT BAR
LEVEL I (EPOXY COATED)
USE 2 3/4" Ø (70 mm) PIN
(146) REQ'D.

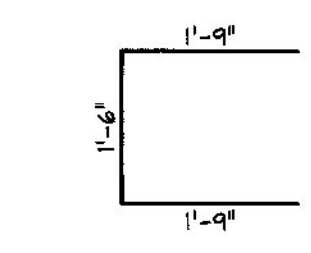


AN-503E
#5 BENT BAR
LEVEL I (EPOXY COATED)
USE 2 3/4" Ø (70 mm) PIN
(92) REQ'D.

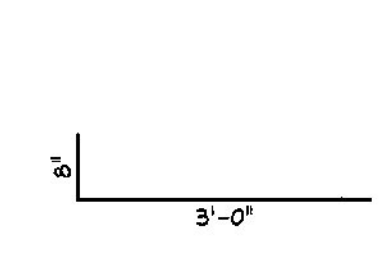

AN-504E
#5 BENT BAR
LEVEL I (EPOXY COATED)
USE 2 3/4" Ø (70 mm) PIN
(108) REQ'D.




AN-505E
#5 BENT BAR
LEVEL I (EPOXY COATED)
USE 2 3/4" Ø (70 mm) PIN
(72) REQ'D.

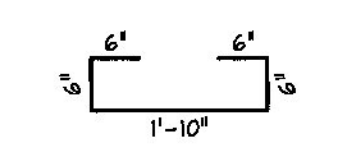


AN-506E
#5 BENT BAR
LEVEL I (EPOXY COATED)
USE 2 3/4" Ø (70 mm) PIN
(24) REQ'D.

MISCELLANEOUS MATERIALS				
ITEM	MARK	QTY.	DESCRIPTION	REMARKS
1	EM-ANI	8	1" THICK x 6' x 6' W/ (1) 3/4" Ø HOLE (GALV.)	FOR ERECTION; SEE DETAIL THIS SHEET
2		16	0.60" Ø SINGLE USE STRESSING CHUCK	FOR ERECTION
3		8	0.60" Ø x 270 KSI x 38'-9" LONG POLYSTRAND	FOR ERECTION
4		32	COMPRESSIBLE SEALER SELF ADHESIVE	FOR ERECTION
5				
6				
7				
8		54	#5 x 50'-0" (LEVEL I, EPOXY COATED)	
9				
10	MK-AN2	22	DAYTON C-24 TYPE 4-APR DECK FORM HANGER	GALVANIZE
11		36	(SET OF 4) 1/2" Ø STRAND LIFTING LOOPS	
12				
13				
14				
15		92	#5 x 2'-6" (LEVEL I, EPOXY COATED)	CAST INTO CURTAIN WALL
16		156	#5 x 3'-5 1/2" (LEVEL I, EPOXY COATED)	CAST INTO CURTAIN WALL
17		12	#5 x 11 3/4" (LEVEL I, EPOXY COATED)	CAST INTO CURTAIN WALL
18				
19		28	#8 x 1'-6" (LEVEL I, EPOXY COATED)	CAST INTO CURTAIN WALL
20				

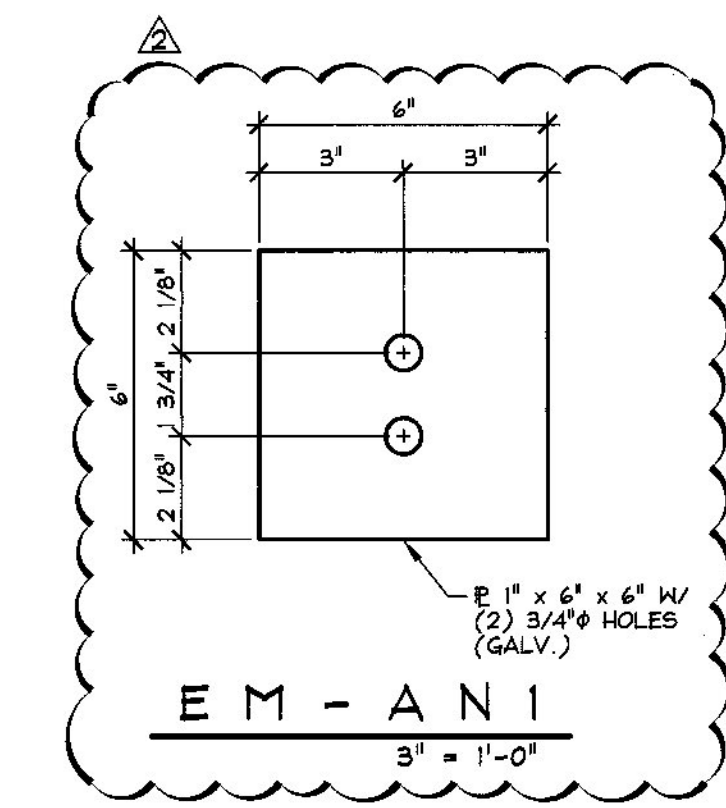

△ 6-9-15 REVISE POST-TENSIONING
△ 6-1-15 REVISED AS NOTED

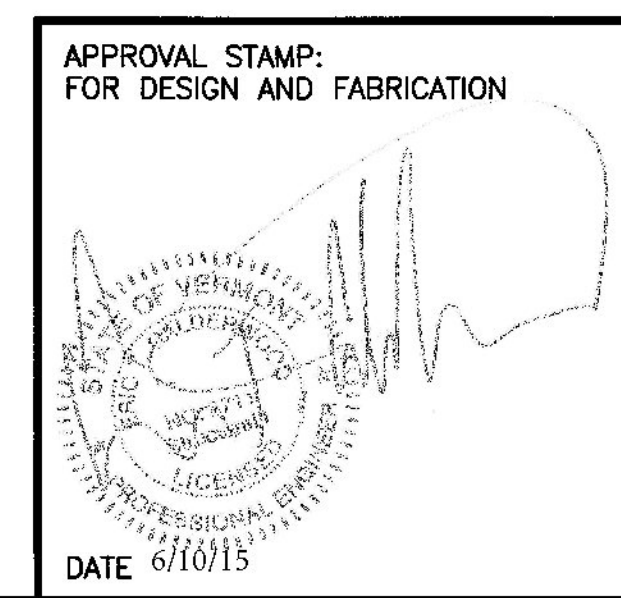

Vermont Agency of Transportation
RECEIVED
ON: June 10, 2015
and Checked for
CONFORMANCE
BY: D. PETERSON DATE: 06/11/2015

J.P. CARRARA & SONS INC. Precast & Prestress Manufacturer 2464 ONE STR. WINDSOR, VERMONT 05255 Phone: (802) 388-6361 Fax: (802) 388-8010		RENAUD BROS, INC. CONTRACTOR VERNON, VERMONT	
STATE OF VERMONT AGENCY OF TRANSPORTATION COUNTY OF WINDSOR		DATE: MAY 6, 2015	SCALE: NOTED
TOWN OF ANDOVER VT RTE 11, RURAL MINOR ARTERIAL BRIDGE NO.: 41 PROJECT NO.: BHF 016-1(29)		CHKD: J.C.	DFTM: B.L.
MATERIALS LIST		JOB NO: 23465-015	DWG. NO: M1