

RECORD PLANS

CONTRACTOR: KUBRICKY CONSTRUCTION CORP. - GLENS FALLS, NY


RESIDENT ENGINEER: CHAD GREENWOOD

CONSTRUCTION BEGAN: JUNE 30, 2014

CONSTRUCTION COMPLETE: OCTOBER 8, 2015

RECORD PLANS BY: CHAD GREENWOOD & AARON JAMES

I HEREBY CERTIFY THAT ALL THE CONSTRUCTION REQUIRED BY THIS SET OF DRAWINGS HAS BEEN ACCOMPLISHED AS INDICATED HEREIN.

BY  RESIDENT ENGINEER


DATE 2/19/16

NOTE: Any further information concerning final quantities, amounts or other details relative to this project may be found at Central Files in the electronic archives.

STATE OF VERMONT
AGENCY OF TRANSPORTATION



PROPOSED IMPROVEMENT
TOWNS OF WARDSBORO AND JAMAICA
COUNTY OF WINDHAM
VT ROUTE 100 (MINOR ARTERIAL)

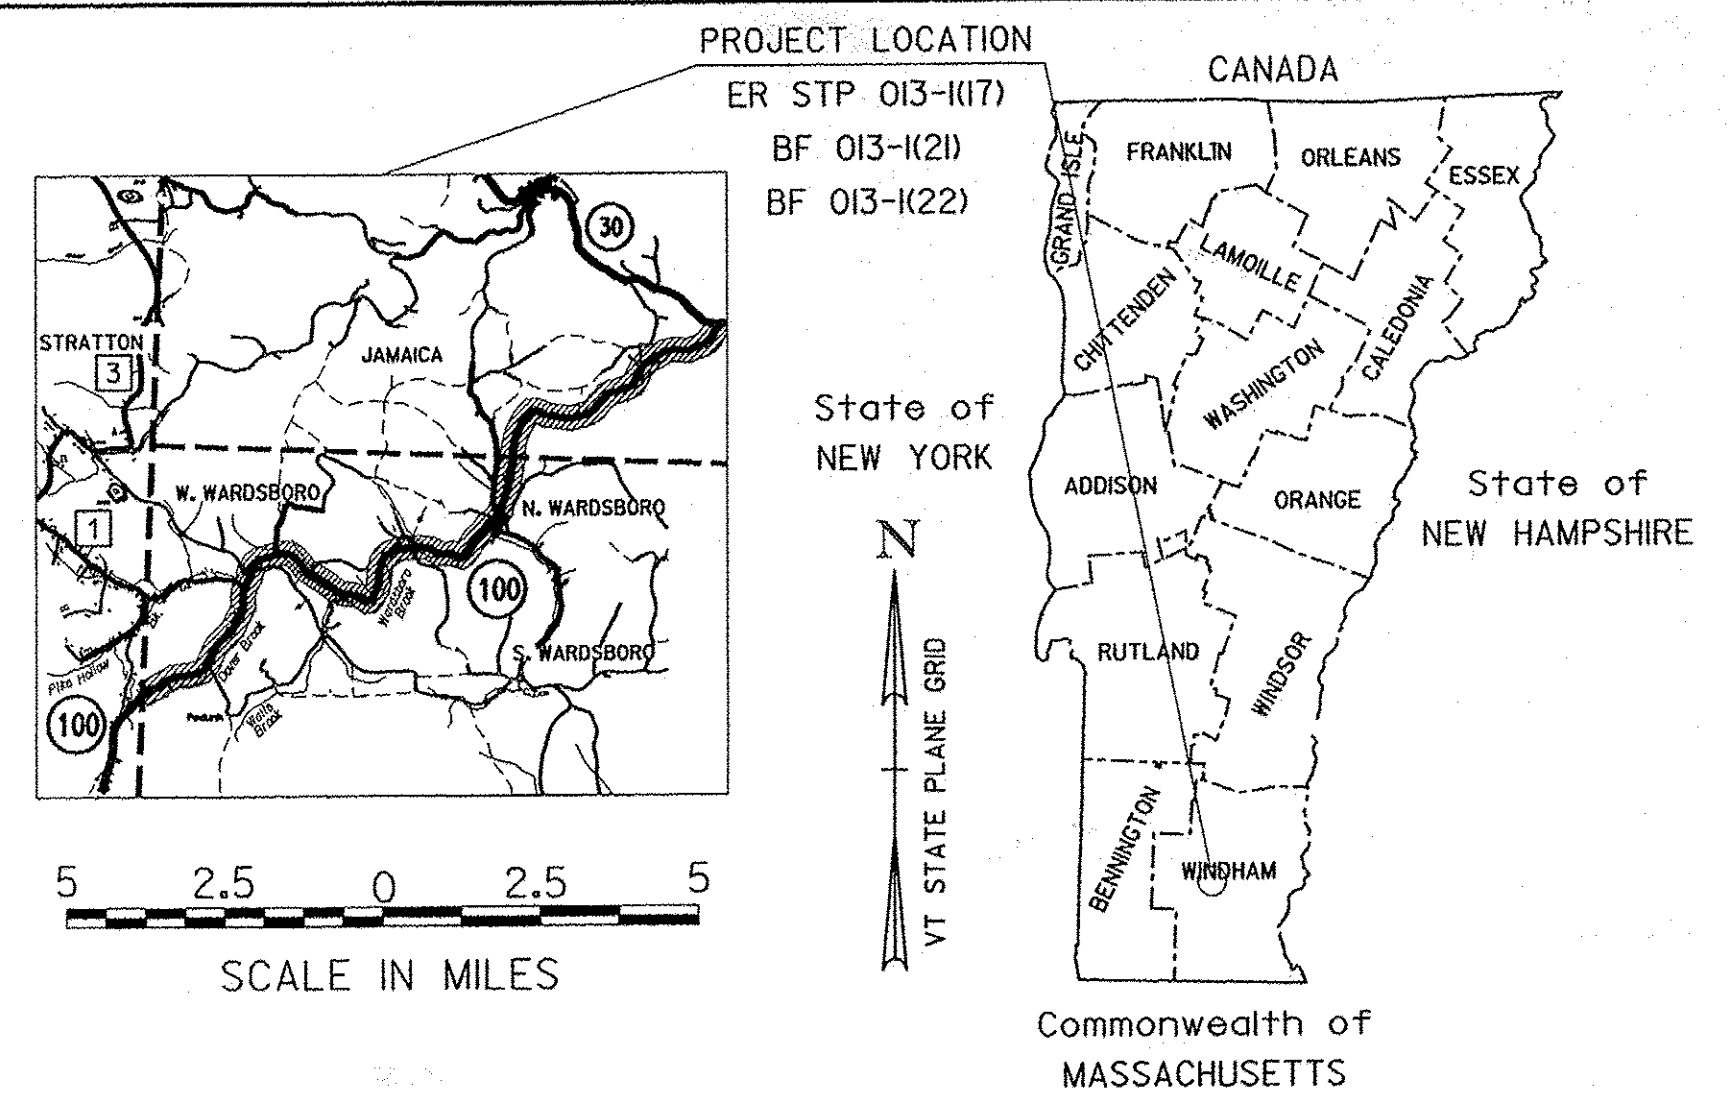

**WARDSBORO-JAMAICA
ER STP 013-1(17)**

PROJECT LOCATION: BEGINNING IN THE TOWN OF WARDSBORO ON VT ROUTE 100 AT STATION A 1+75.00 (MM 0.033) EXTENDING NORTHERLY 56462.74 FEET (10.694 MILES) TO STATION B 178+38.00 (MM 3.378) IN THE TOWN OF JAMAICA.

PROJECT DESCRIPTION: WORK TO BE PERFORMED UNDER THIS PROJECT INCLUDES PAVEMENT RECLAMATION, PAVEMENT RESURFACING, PAVEMENT MARKINGS, GUARDRAIL ADJUSTMENT AND REPLACEMENT, NEW SIGNS, DRAINAGE IMPROVEMENTS, TRAFFIC CONTROL AND OTHER HIGHWAY RELATED ITEMS.

**WARDSBORO
BF 013-1(21)**


PROJECT LOCATION: 7.7 MILES SOUTH OF THE JUNCTION OF VT ROUTE 100 AND VT ROUTE 30.

PROJECT DESCRIPTION: REMOVAL OF EXISTING STRUCTURE AND REPLACEMENT WITH A NEW PRECAST STRUCTURE.

**WARDSBORO
BF 013-1(22)**

PROJECT LOCATION: 5.6 MILES SOUTH OF THE JUNCTION OF VT ROUTE 100 AND VT ROUTE 30.


PROJECT DESCRIPTION: REMOVAL OF EXISTING STRUCTURE AND REPLACEMENT WITH A NEW PRECAST STRUCTURE.

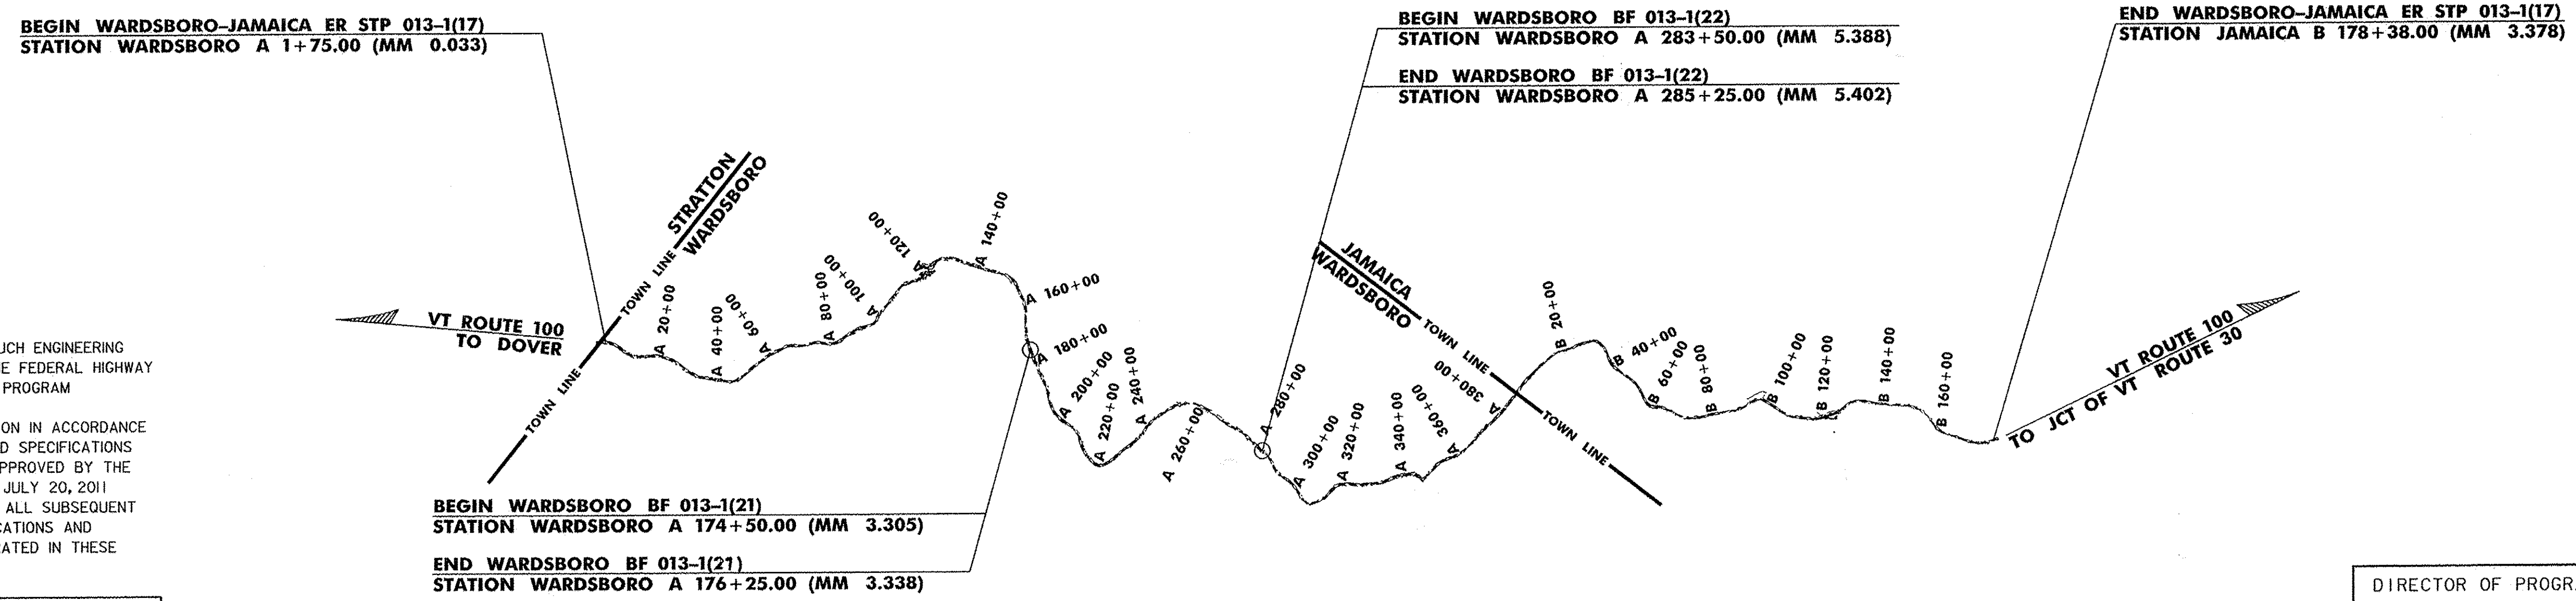

THESE PLANS ARE SUBJECT TO SUCH ENGINEERING CHANGES AS MAY BE REQUIRED BY THE FEDERAL HIGHWAY ADMINISTRATION OR THE DIRECTOR OF PROGRAM DEVELOPMENT.

CONSTRUCTION IS TO BE CARRIED ON IN ACCORDANCE WITH THESE PLANS AND THE STANDARD SPECIFICATIONS FOR CONSTRUCTION DATED 2011, AS APPROVED BY THE FEDERAL HIGHWAY ADMINISTRATION ON JULY 20, 2011 FOR USE ON THIS PROJECT, INCLUDING ALL SUBSEQUENT REVISIONS AND SUCH REVISED SPECIFICATIONS AND SPECIAL PROVISIONS AS ARE INCORPORATED IN THESE PLANS.

QUALITY ASSURANCE PROGRAM : LEVEL 2
SURVEYED BY : VTRANS
SURVEYED DATE : 1/3/13
DATUM
VERTICAL NAVD 88
HORIZONTAL NAD 83 (2007)

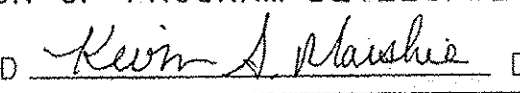DIRECTOR OF PROGRAM DEVELOPMENT
APPROVED  DATE 2/25/14
PROJECT MANAGER : KEN UPMAL, P.E. KRISTIN HIGGINS, P.E.
PROJECT NAME : WARDSBORO - JAMAICA
PROJECT NUMBER : ER STP 013-1 (17) BF 013-1 (21) BF 013-1 (22)
SHEET 1 OF 444 SHEETS