
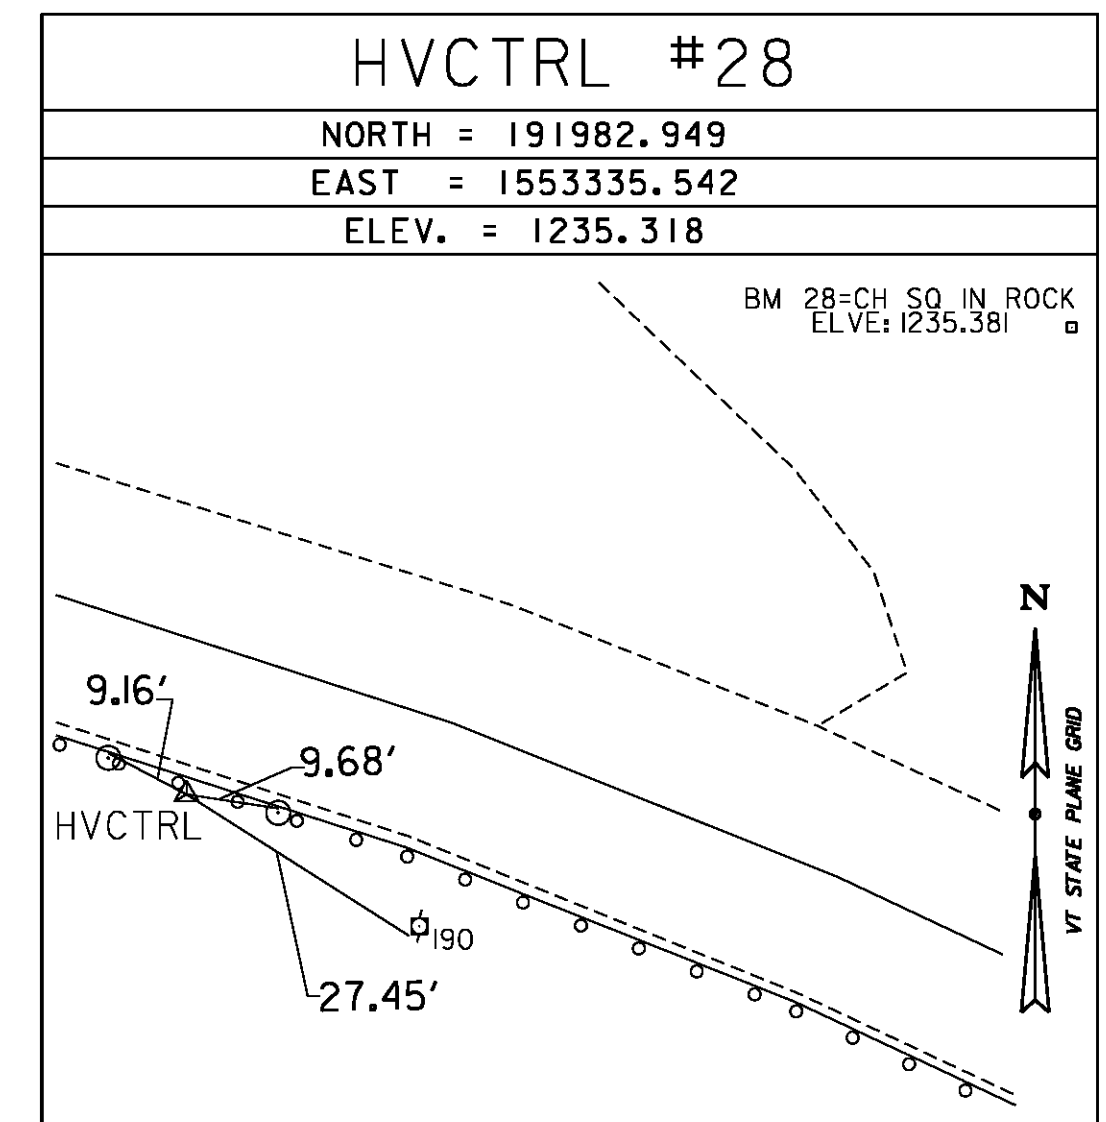
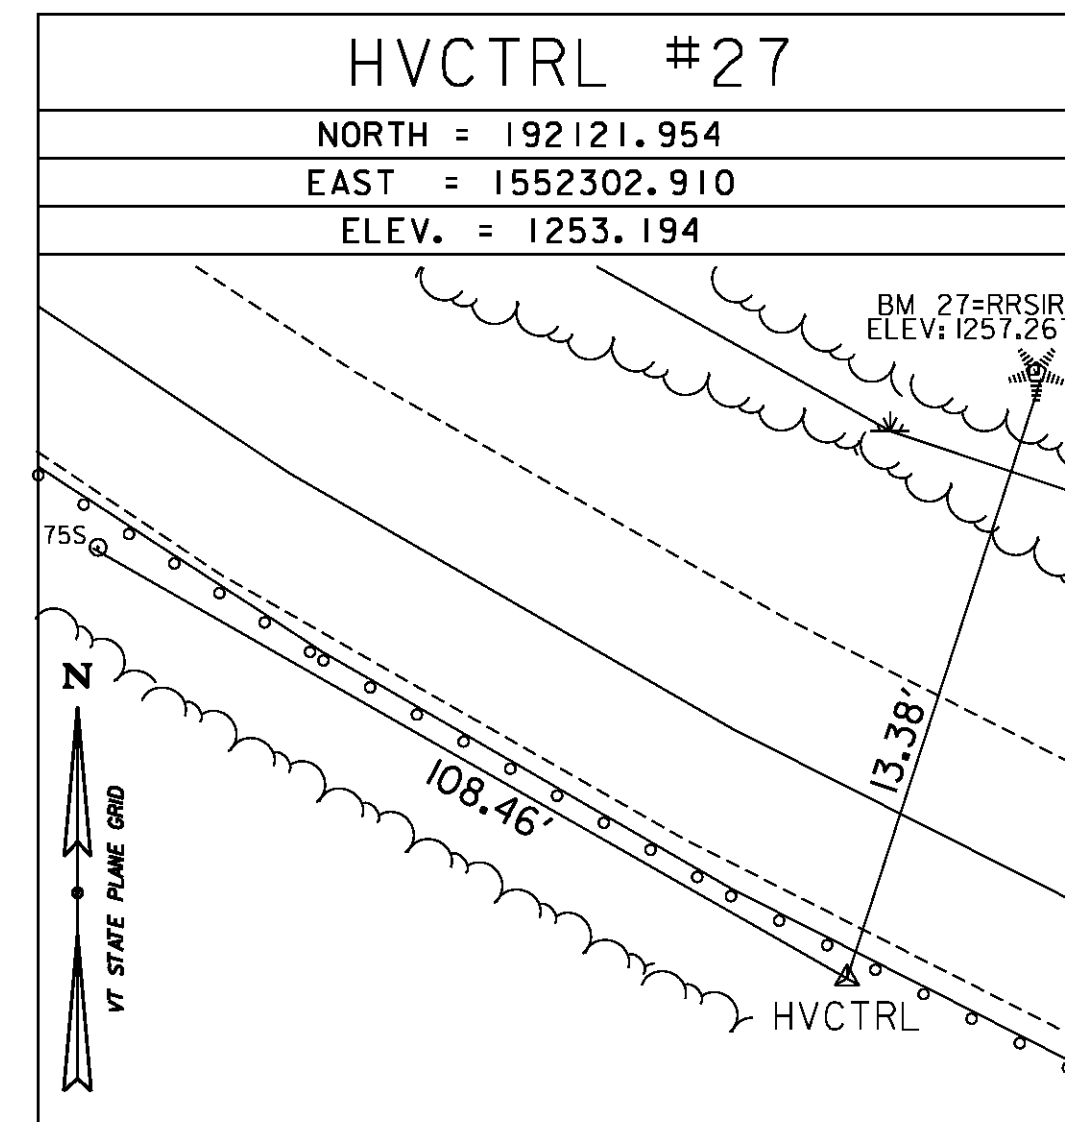
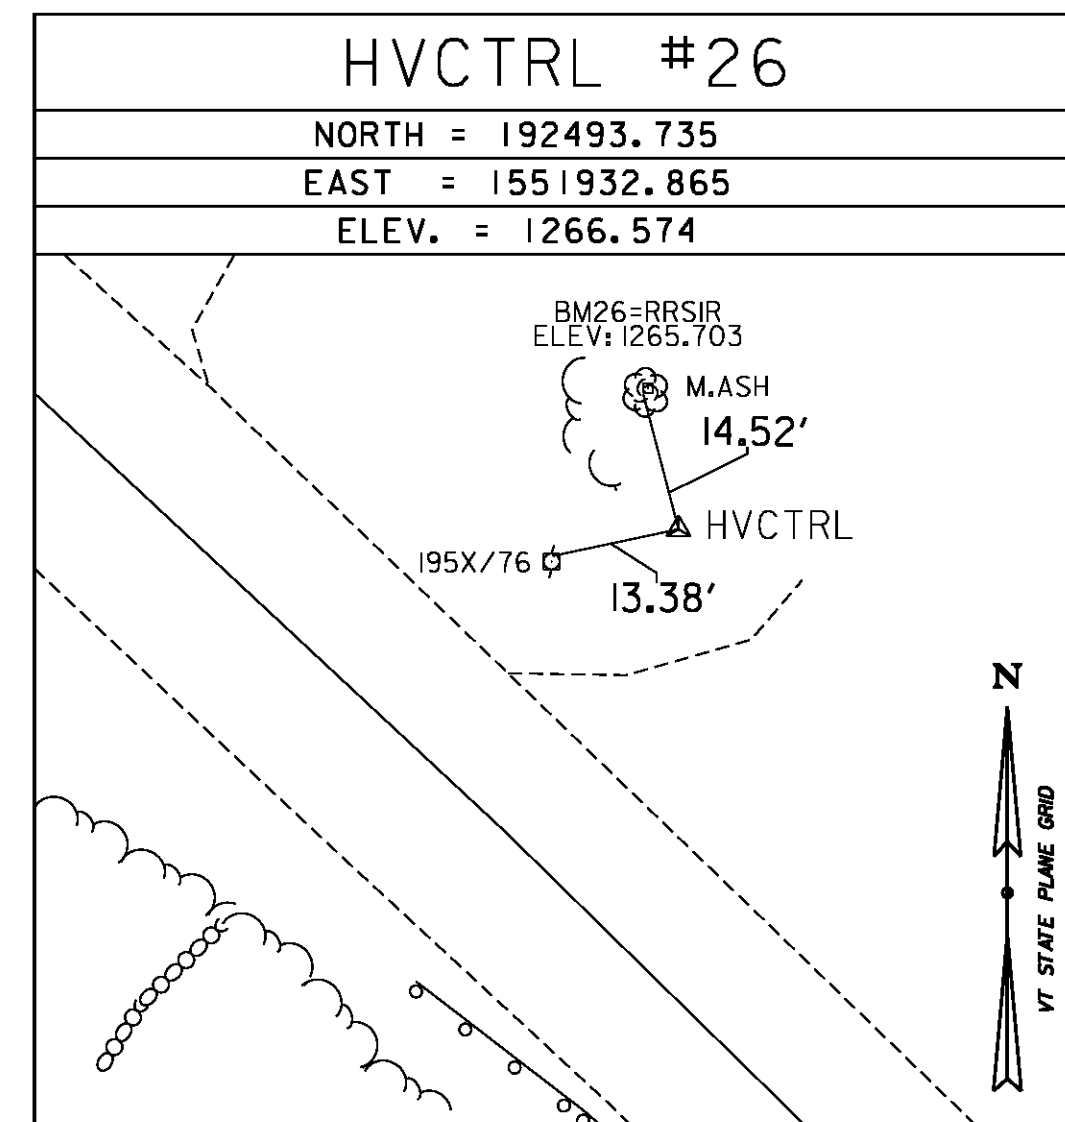
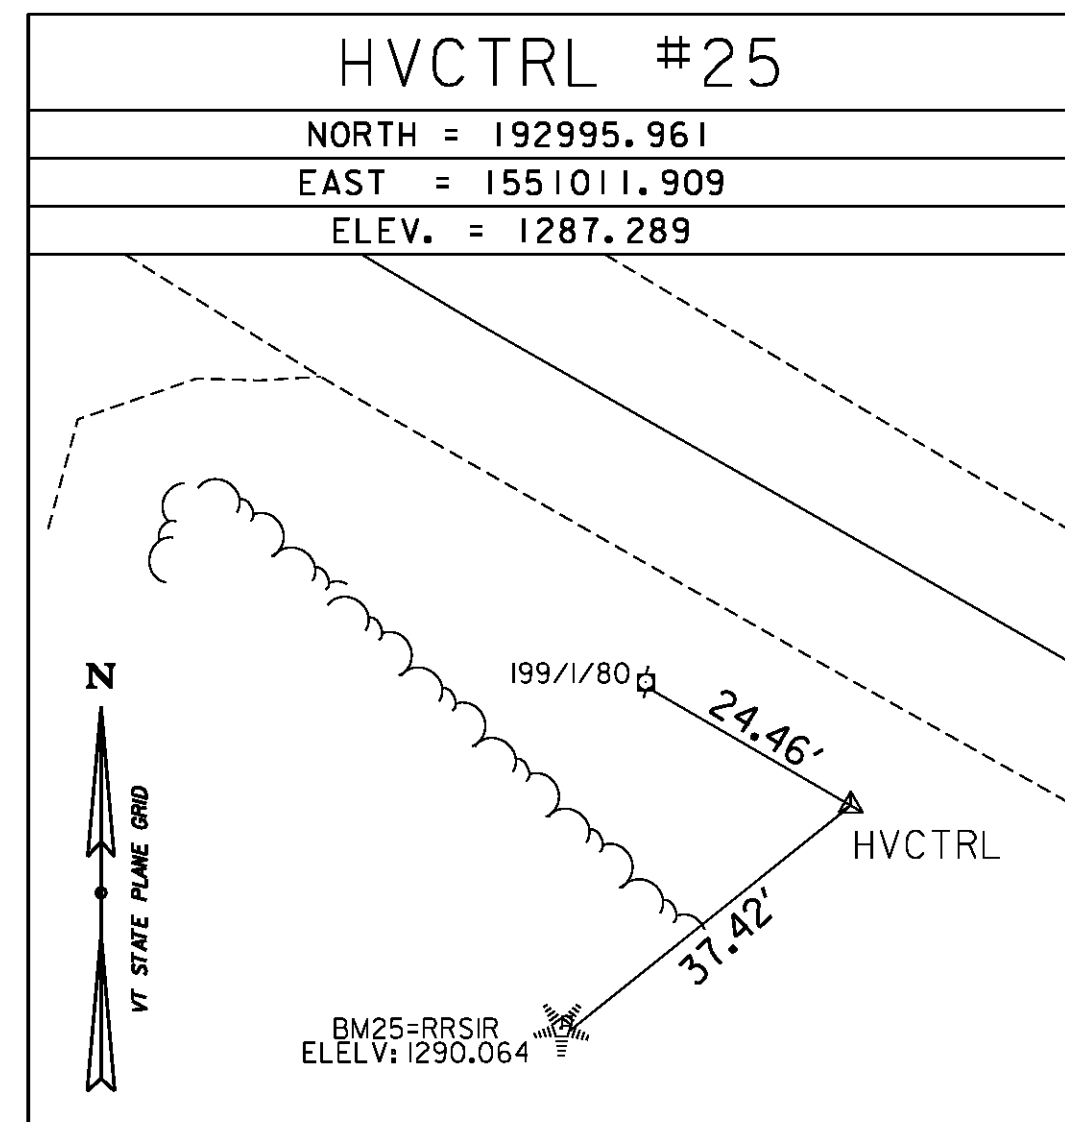


GPS CONTROL POINTS

TRAVERSE TIES

ALIGNMENT TIES

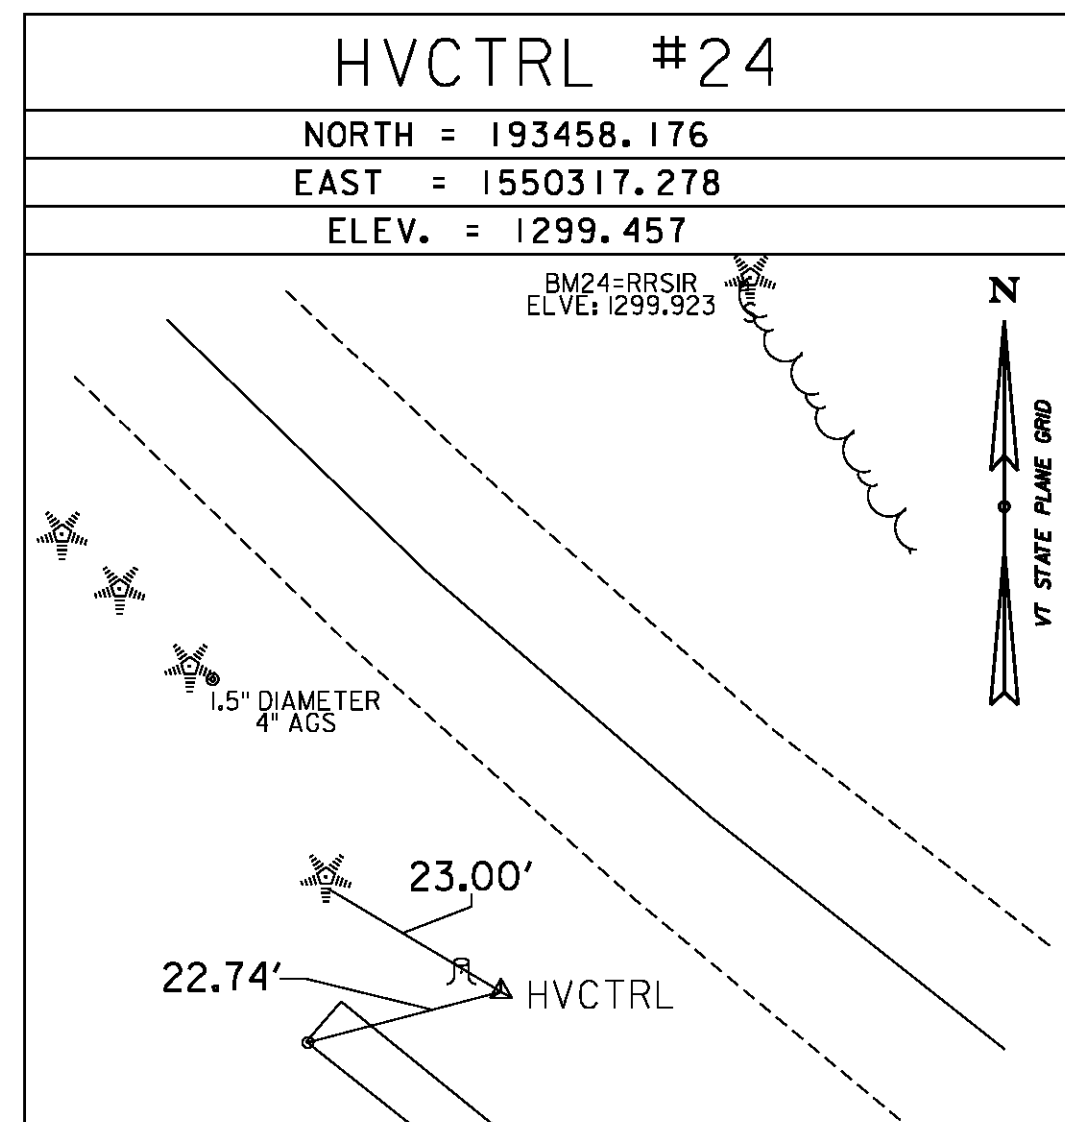

NORTH = _____

EAST = _____

ELEV. = _____

NORTH = _____

EAST = _____

ELEV. = _____

DATUM

VERTICAL	NAVD 88
HORIZONTAL	NAD 83 (2007)
ADJUSTMENT	COMPASS

PROJECT NAME:	WARDSBORO-JAMAICA	
PROJECT NUMBER:	ER STP 013-1(17)	
FILE NAME:	XI2B236T1.DGN	PLOT DATE: 2/26/2014
PROJECT LEADER:	K. UPMAL	DRAWN BY: S. DONOVAN
DESIGNED BY:	B. KIPP	CHECKED BY: P. BEYOR
TIE SHEET	6	SHEET 20 OF 44