
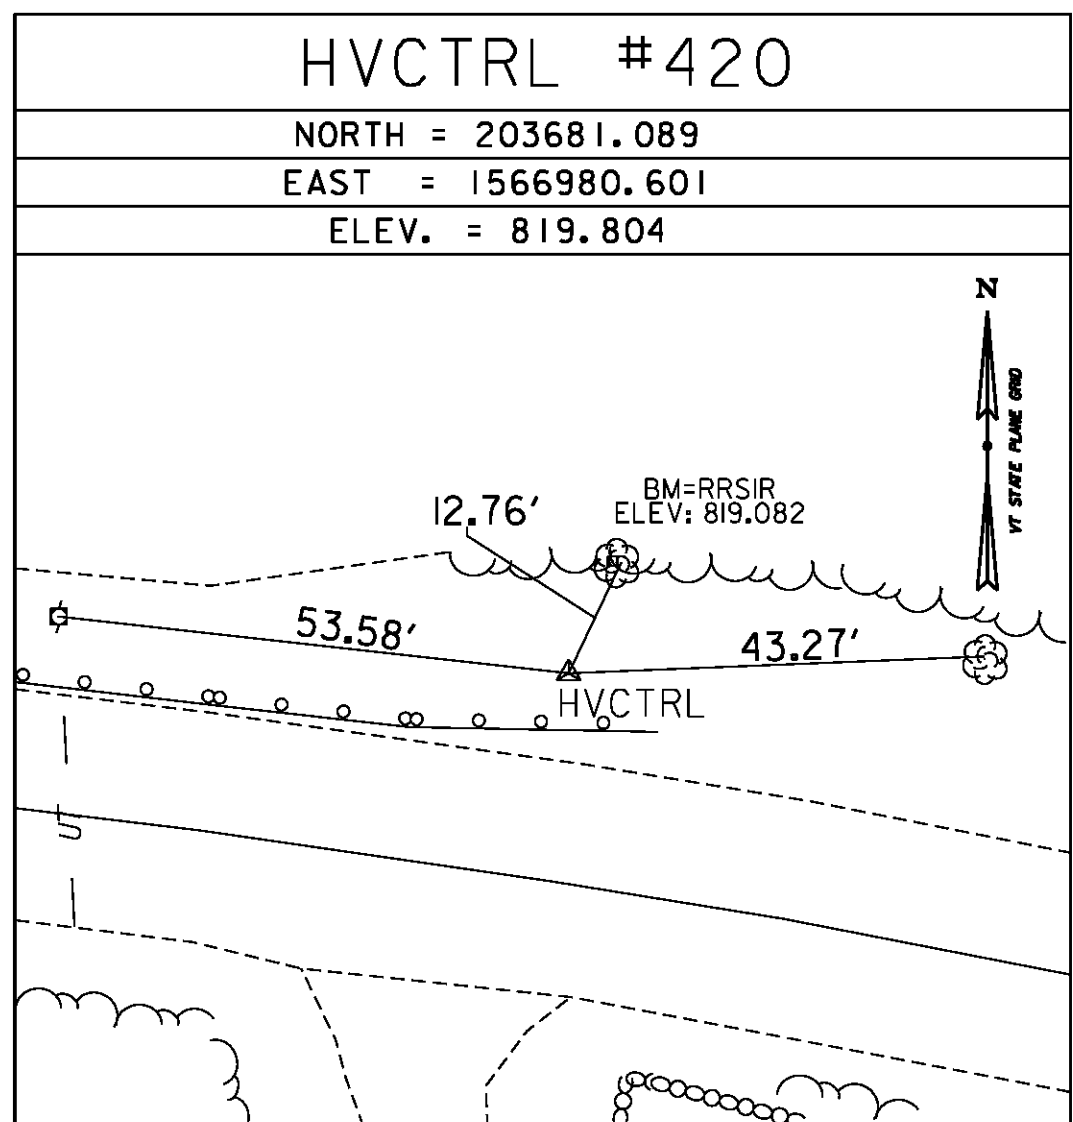
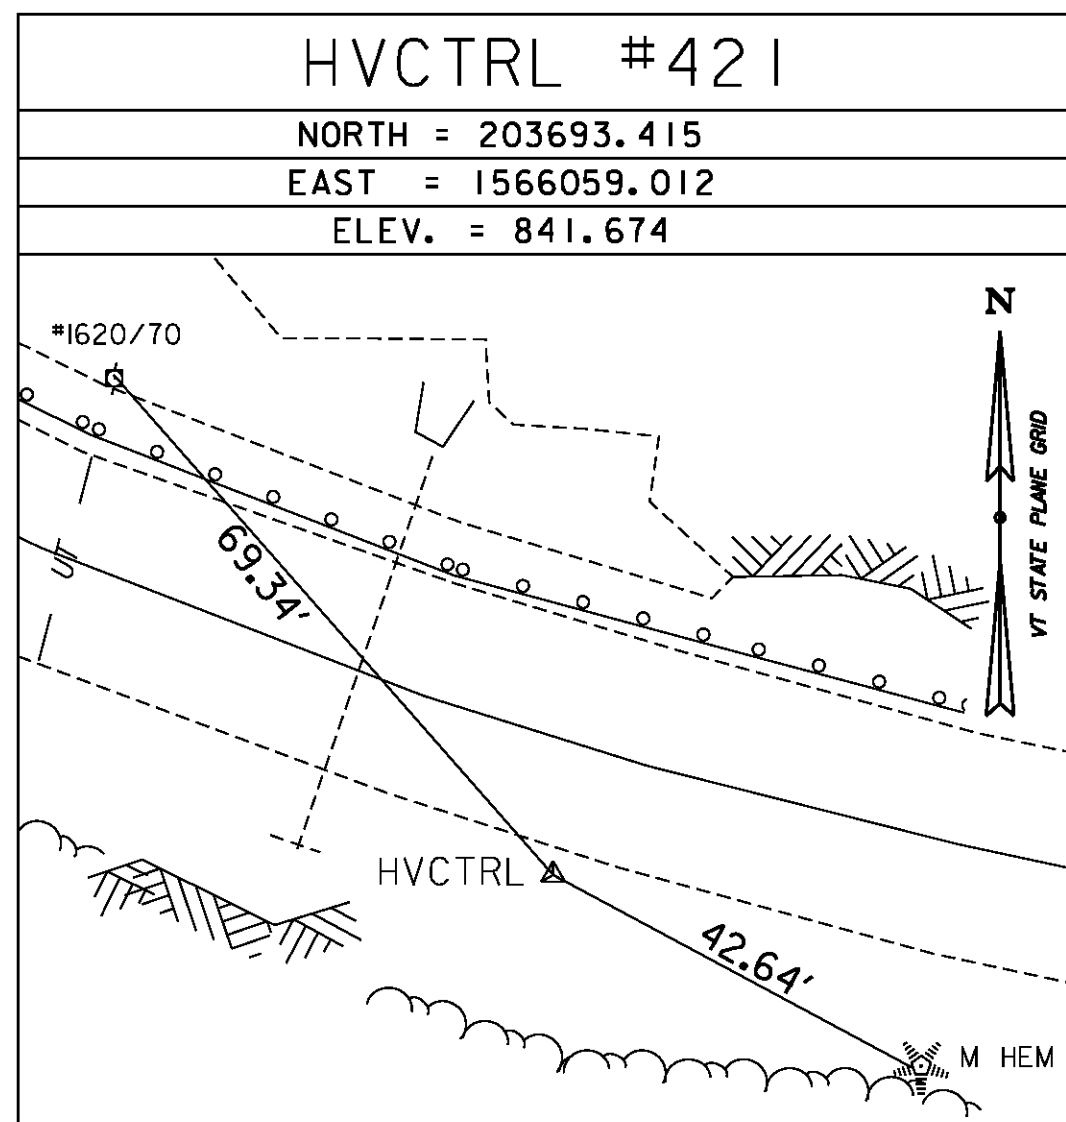
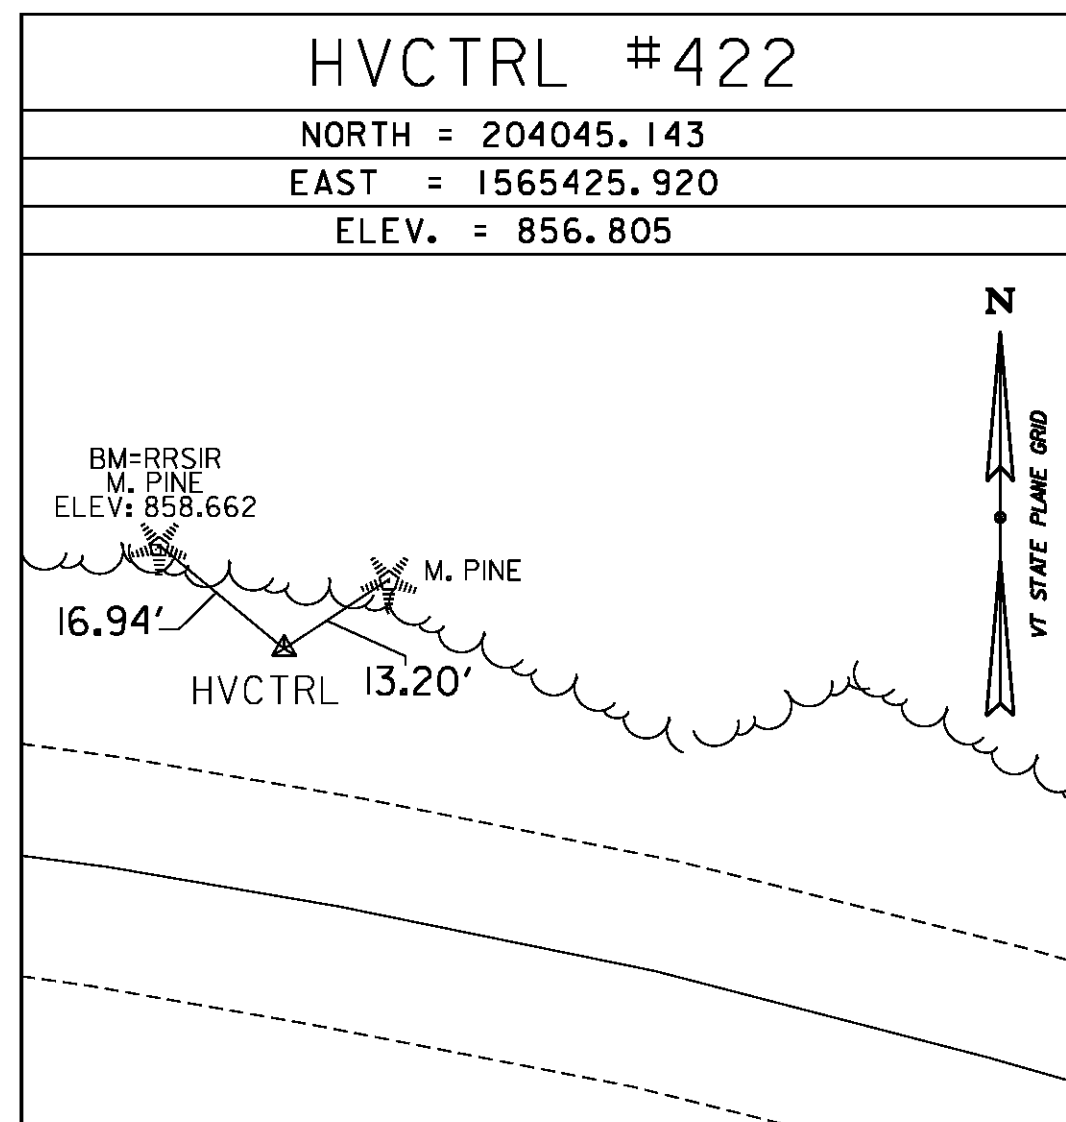
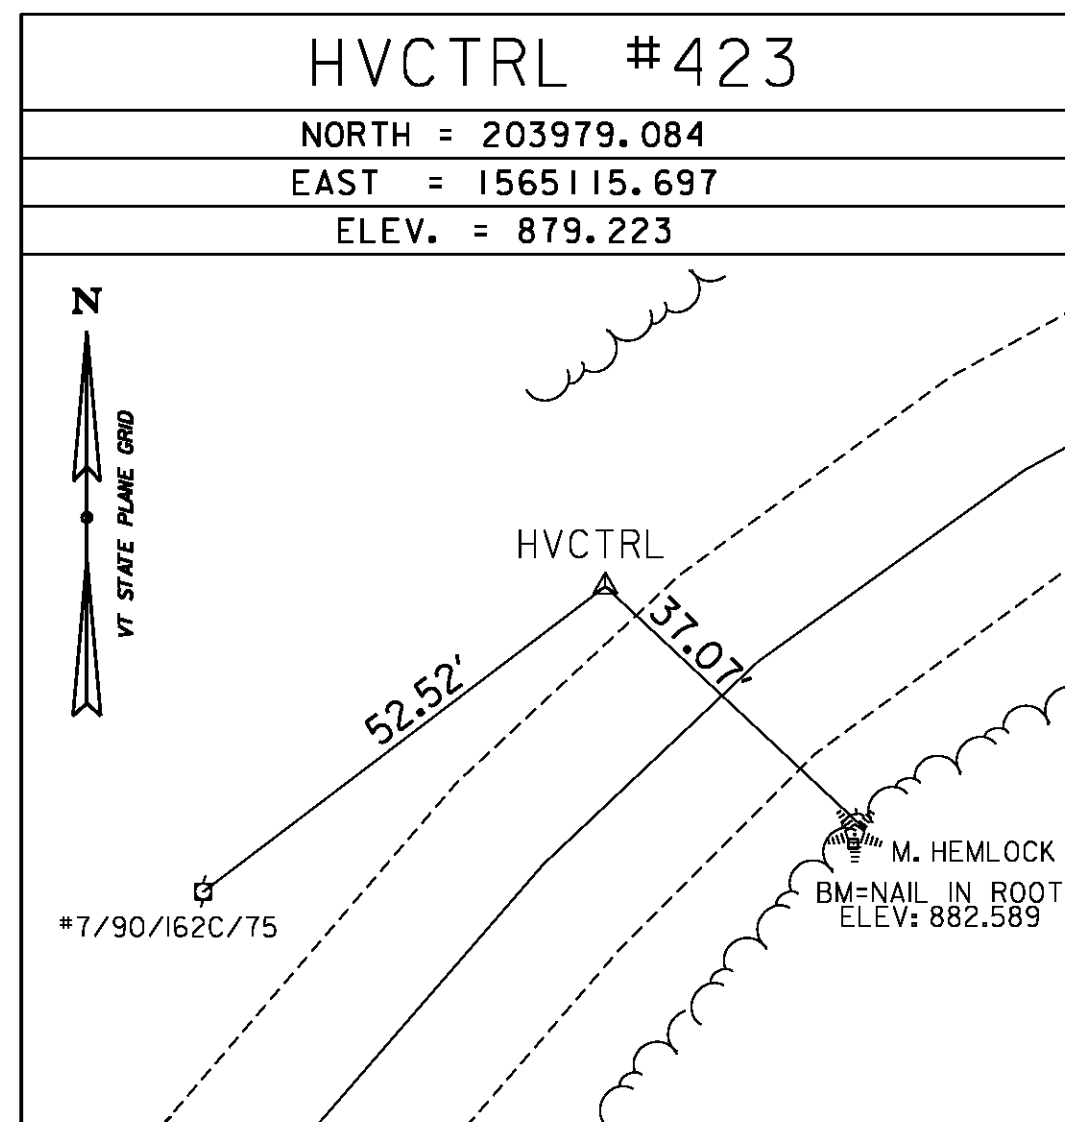


GPS CONTROL POINTS

TRAVERSE TIES

ALIGNMENT TIES

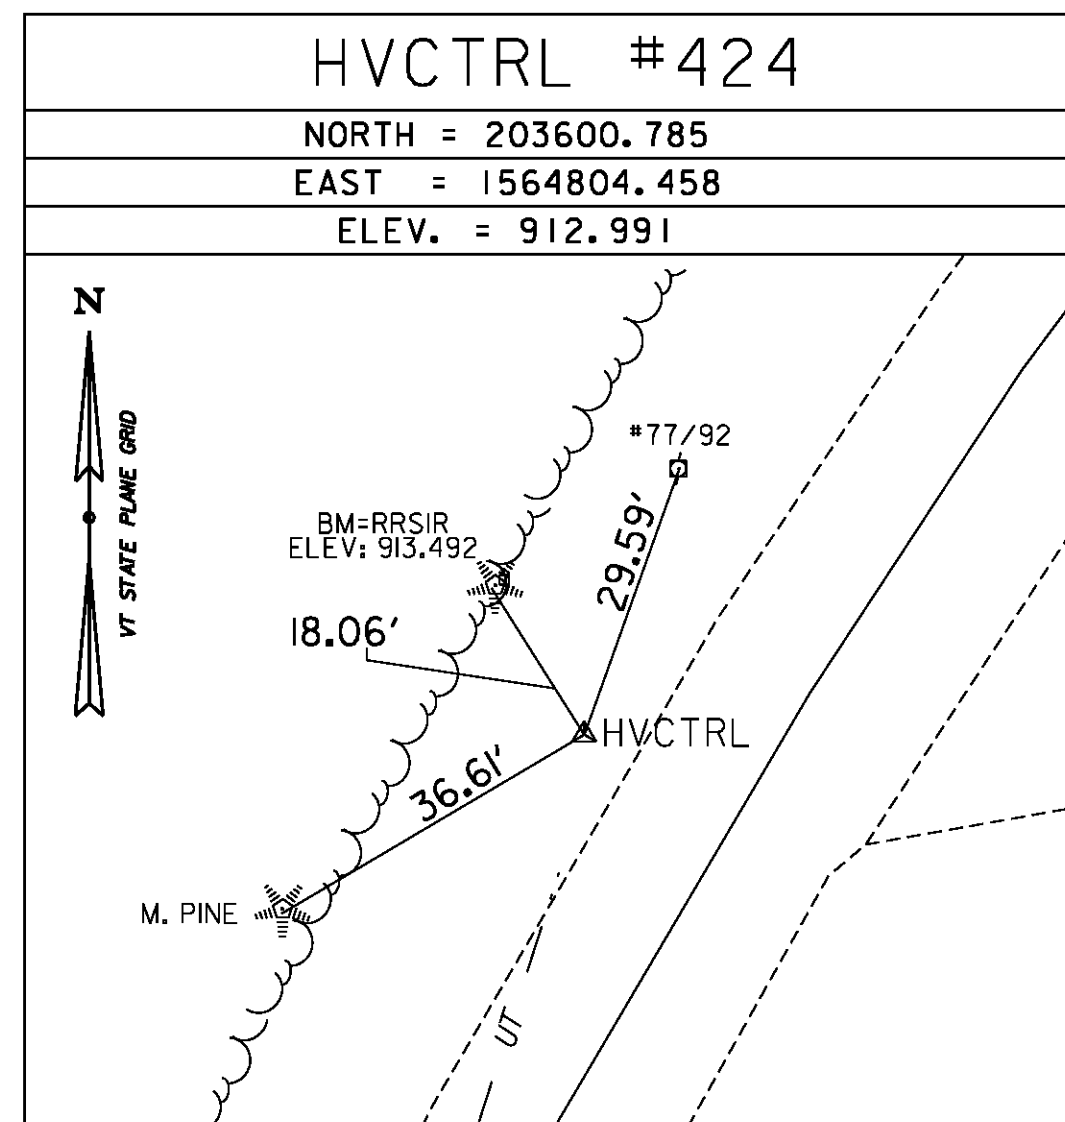

NORTH = \_\_\_\_\_  
 EAST = \_\_\_\_\_  
 ELEV. = \_\_\_\_\_

NORTH = \_\_\_\_\_  
 EAST = \_\_\_\_\_  
 ELEV. = \_\_\_\_\_

DATUM	
VERTICAL	NAVD 88
HORIZONTAL	NAD 83 (2007)
ADJUSTMENT	COMPASS

PROJECT NAME: WARDBORO-JAMAICA	
PROJECT NUMBER: ER STP 013-1(17)	
FILE NAME: XI2B236TI.DGN	PLOT DATE: 2/26/2014
PROJECT LEADER: K. UPMAL	DRAWN BY: S. DONOVAN
DESIGNED BY: B. KIPP	CHECKED BY: P. BEYOR
TIE SHEET 13	SHEET 27 OF 444