

STEEL BEAM GUARDRAIL, GALVANIZED W/ 8 FT POSTS  
 STA A 63+06 - STA A 84+14 LT  
 STA A 83+29 - STA A 101+00 RT



REMOVE AND DISPOSE OF GUARDRAIL  
 STA A 62+97 - STA A 84+37 LT  
 STA A 83+21 - STA A 101+10 RT

STEEL BEAM GUARDRAIL, GALVANIZED  
 STA A 83+16 - STA A 83+29 RT

STONE FILL TYPE I  
 STA A 74+70 - STA A 78+40 RT  
 STA A 74+00 - STA A 74+60 RT

ANCHOR FOR STEEL BEAM RAIL  
 STA A 83+25 RT

DELINATOR WITH STEEL POSTS  
 STA A 83+16 RT

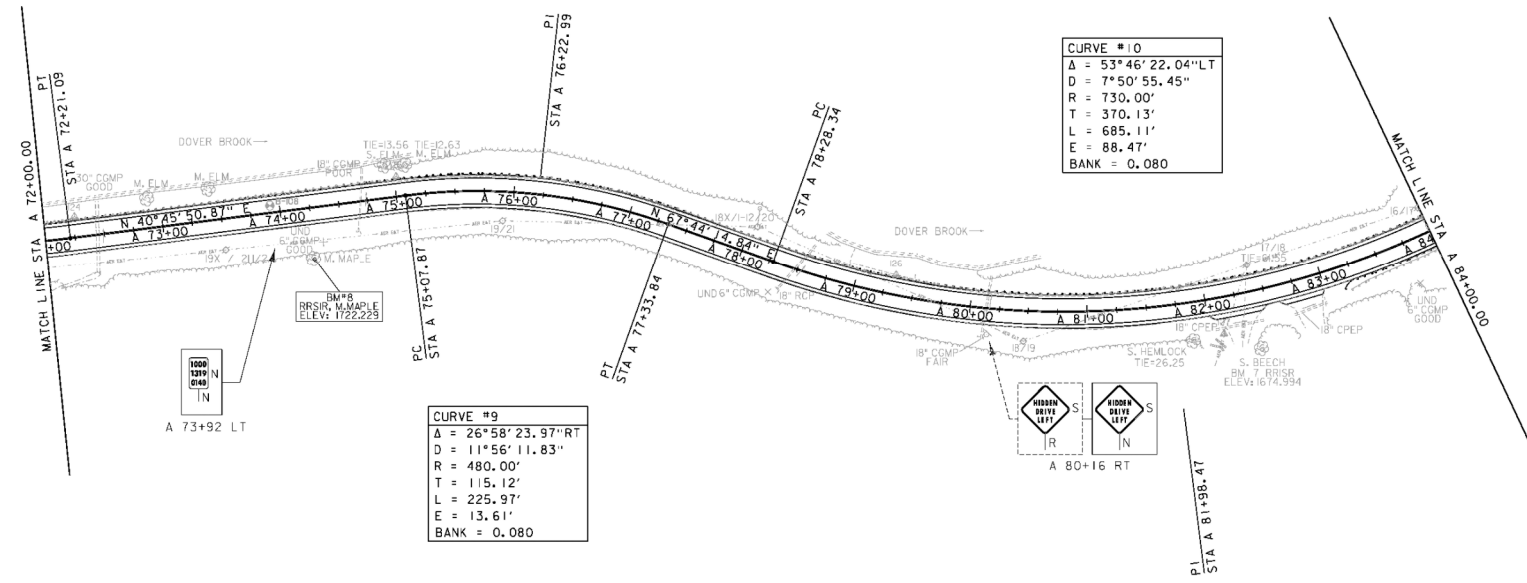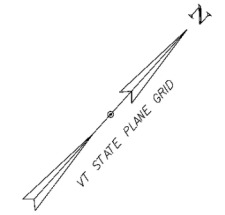

**CURVE #10**  
 Δ = 53°46' 22.04" LT  
 D = 7°50' 55.45"  
 R = 730.00'  
 T = 370.13'  
 L = 685.11'  
 E = 88.47'  
 BANK = 0.080

**CURVE #9**  
 Δ = 26°58' 23.97" RT  
 D = 11°56' 11.83"  
 R = 480.00'  
 T = 115.12'  
 L = 225.97'  
 E = 13.61'  
 BANK = 0.080

**DURABLE 4 INCH WHITE LINE (SEE OPTION ITEMS)**  
 STA A 0+00 - STA A 112+31 (SOLID LT)  
 STA A 48+58 - STA A 118+63 (SOLID RT)

**DURABLE 4 INCH YELLOW LINE (SEE OPTION ITEMS)**  
 STA A 48+68 - STA A 112+19 (SOLID LT + RT)

**TEMPORARY 4 INCH WHITE LINE**  
 STA A 0+00 - STA A 112+31 (SOLID LT)  
 STA A 48+58 - STA A 118+63 (SOLID RT)

**TEMPORARY 4 INCH YELLOW LINE**  
 STA A 48+68 - STA A 112+19 (SOLID LT + RT)

**SIGN LEGEND**

R	= REMOVE
S	= SALVAGE
N	= NEW
RET	= RETAIN
T&T	= THINNING & TRIMMING
B-B	= BACK TO BACK
EXISTING	-----
NEW	-----



PROJECT NAME:	WARDSBORO-JAMAICA
PROJECT NUMBER:	ER STP 013-1(17)
FILE NAME:	d2b236_bdr.dgn
PROJECT LEADER:	K, UPVAL
DESIGNED BY:	B, KIPP
PLAN SHEET 7	
PLOT DATE:	2/26/2014
DRAWN BY:	B, KIPP
CHECKED BY:	A, KEMPTON
SHEET	68 OF 444