

STEEL BEAM GUARDRAIL, GALVANIZED W/ 8 FT POSTS
 STA A 63+06 - STA A 84+14 LT
 STA A 83+29 - STA A 101+00 RT

STEEL BEAM GUARDRAIL, GALVANIZED
 STA A 84+14 - STA A 84+27 LT

ANCHOR FOR STEEL BEAM RAIL
 STA A 84+18 LT



DELINEATOR WITH STEEL POSTS
 STA A 83+27 LT

REMOVE AND DISPOSE OF GUARDRAIL
 STA A 62+97 - STA A 84+37 LT
 STA A 83+21 - STA A 101+10 RT

STONE FILL, TYPE I
~~STA A 90+30 - STA A 91+00 LT~~
~~STA A 92+00 - STA A 93+50 LT~~
STA A 90+5 - STA A 90+77 LT
STA A 92+00 - STA A 93+83 LT
STA A 94+09 - STA A 98+39 LT
STA A 84+75 - STA A 87+70 LT

GRUBBING MATERIAL
 STA A 90+30 - STA A 91+00 LT
 STA A 92+00 - STA A 93+50 LT

GEOTEXTILE FOR SILT FENCE
 STA A 90+30 - STA A 91+00 LT
 STA A 92+00 - STA A 93+50 LT

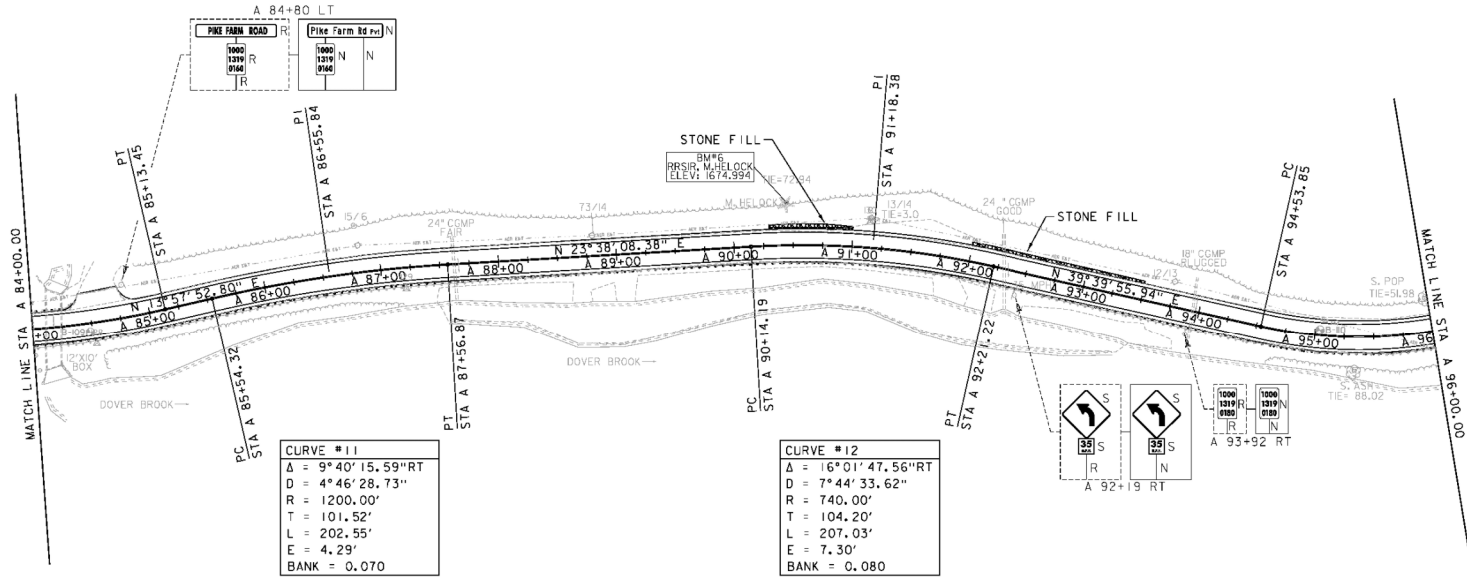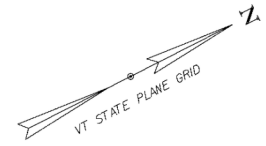

DURABLE 4 INCH WHITE LINE (SEE OPTION ITEMS)
 STA A 0+00 - STA A 112+31 (SOLID LT)
 STA A 48+58 - STA A 118+63 (SOLID RT)

DURABLE 4 INCH YELLOW LINE (SEE OPTION ITEMS)
 STA A 48+68 - STA A 112+19 (SOLID LT + RT)

TEMPORARY 4 INCH WHITE LINE
 STA A 0+00 - STA A 112+31 (SOLID LT)
 STA A 48+58 - STA A 118+63 (SOLID RT)

TEMPORARY 4 INCH YELLOW LINE
 STA A 48+68 - STA A 112+19 (SOLID LT + RT)

SIGN LEGEND
 R = REMOVE
 S = SALVAGE
 N = NEW
 RET = RETAIN
 I&T = THINNING & TRIMMING
 E-B = BACK TO BACK
 EXISTING = DASHED
 NEW = SOLID



PROJECT NAME:	WARSDSBORO-JAMAICA	FILE NAME:	d2b236_bdr.dgn	PLOT DATE:	2/26/2014
PROJECT NUMBER:	ER STP 013-I(17)	PROJECT LEADER:	K. UPWAL	DRAWN BY:	B. KIPP
		DESIGNED BY:	B. KIPP	CHECKED BY:	A. KEMPTON
		PLAN SHEET 8		SHEET	70 OF 444