

STA A 109+00.00
END RECLAIM
BEGIN COLD PLANE
BEGIN OVERLAY

STEEL BEAM GUARDRAIL, GALVANIZED W/ 8 FT POSTS
STA A 107+95 - STA A 111+48 RT
STA A 117+44 - STA A 118+62 RT

REMOVE AND DISPOSE OF GUARDRAIL
STA A 107+96 - STA A 111+50 RT
STA A 112+80 - STA A 115+02 LT
STA A 117+34 - STA A 118+77 RT

STEEL BEAM GUARDRAIL, GUARDRAIL
STA A 111+48 - STA A 111+61 RT
STA A 117+31 - STA A 117+44 RT
STA A 118+62 - STA A 118+75 RT

ANCHOR FOR STEEL BEAM RAIL
STA A 111+52 RT
STA A 117+31 RT
STA A 118+75 RT

DELINEATOR WITH STEEL POSTS
STA A 111+61 RT
STA A 112+82 LT
STA A 115+06 LT
STA A 107+31 RT
STA A 118+75 RT

REHAB. DROP INLETS,
CATCH BASINS OR MANHOLES,
CLASS II
STA A 111+23 LT
STA A 115+65 LT

DURABLE 4 INCH WHITE LINE (SEE OPTION ITEMS)
STA A 0+00 - STA A 112+31 (SOLID LT)
STA A 112+49 - STA A 121+07 (SOLID LT)
STA A 48+58 - STA A 121+07 (SOLID RT)

DURABLE 4 INCH YELLOW LINE (SEE OPTION ITEMS)
STA A 48+68 - STA A 112+19 (SOLID LT + RT)
STA A 112+40 LT (CENTERLINES TH #1)
STA A 112+60 - STA A 119+00 (SOLID LT + RT)

TEMPORARY 4 INCH WHITE LINE
STA A 0+00 - STA A 112+31 (SOLID LT)
STA A 112+49 - STA A 121+07 (SOLID LT)
STA A 48+58 - STA A 121+07 (SOLID RT)


TEMPORARY 4 INCH YELLOW LINE
STA A 48+68 - STA A 112+19 (SOLID LT + RT)
STA A 112+40 LT (CENTERLINES TH #1)
STA A 112+60 - STA A 119+00 (SOLID LT + RT)

DURABLE 24 INCH STOP BAR (SEE OPTION ITEMS)
STA A 112+38 LT
STA A 112+75 LT

DURABLE LETTERS OR SYMBOLS (SEE OPTION ITEMS)
STA A 112+38 LT "STOP"
STA A 112+75 LT "STOP"

SIGN LEGEND

R	= REMOVE
S	= SALVAGE
N	= NEW
RET	= RETAIN
T&T	= THINNING & TRIMMING
B-B	= BACK TO BACK
EXISTING	-----
NEW	_____

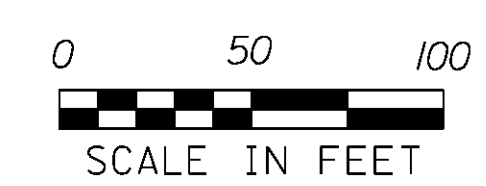

PROJECT NAME:	WARSDBORO-JAMAICA	PLOT DATE:	2/26/2014
PROJECT NUMBER:	ER STP 013-1(17)	DRAWN BY:	B. KIPP
FILE NAME:	d12b236_bdr.dgn	CHECKED BY:	A. KEMPTON
PROJECT LEADER:	K. UPMAL	SHEET	74 OF 444
DESIGNED BY:	B. KIPP		
PLAN SHEET	10		