


PROFILE

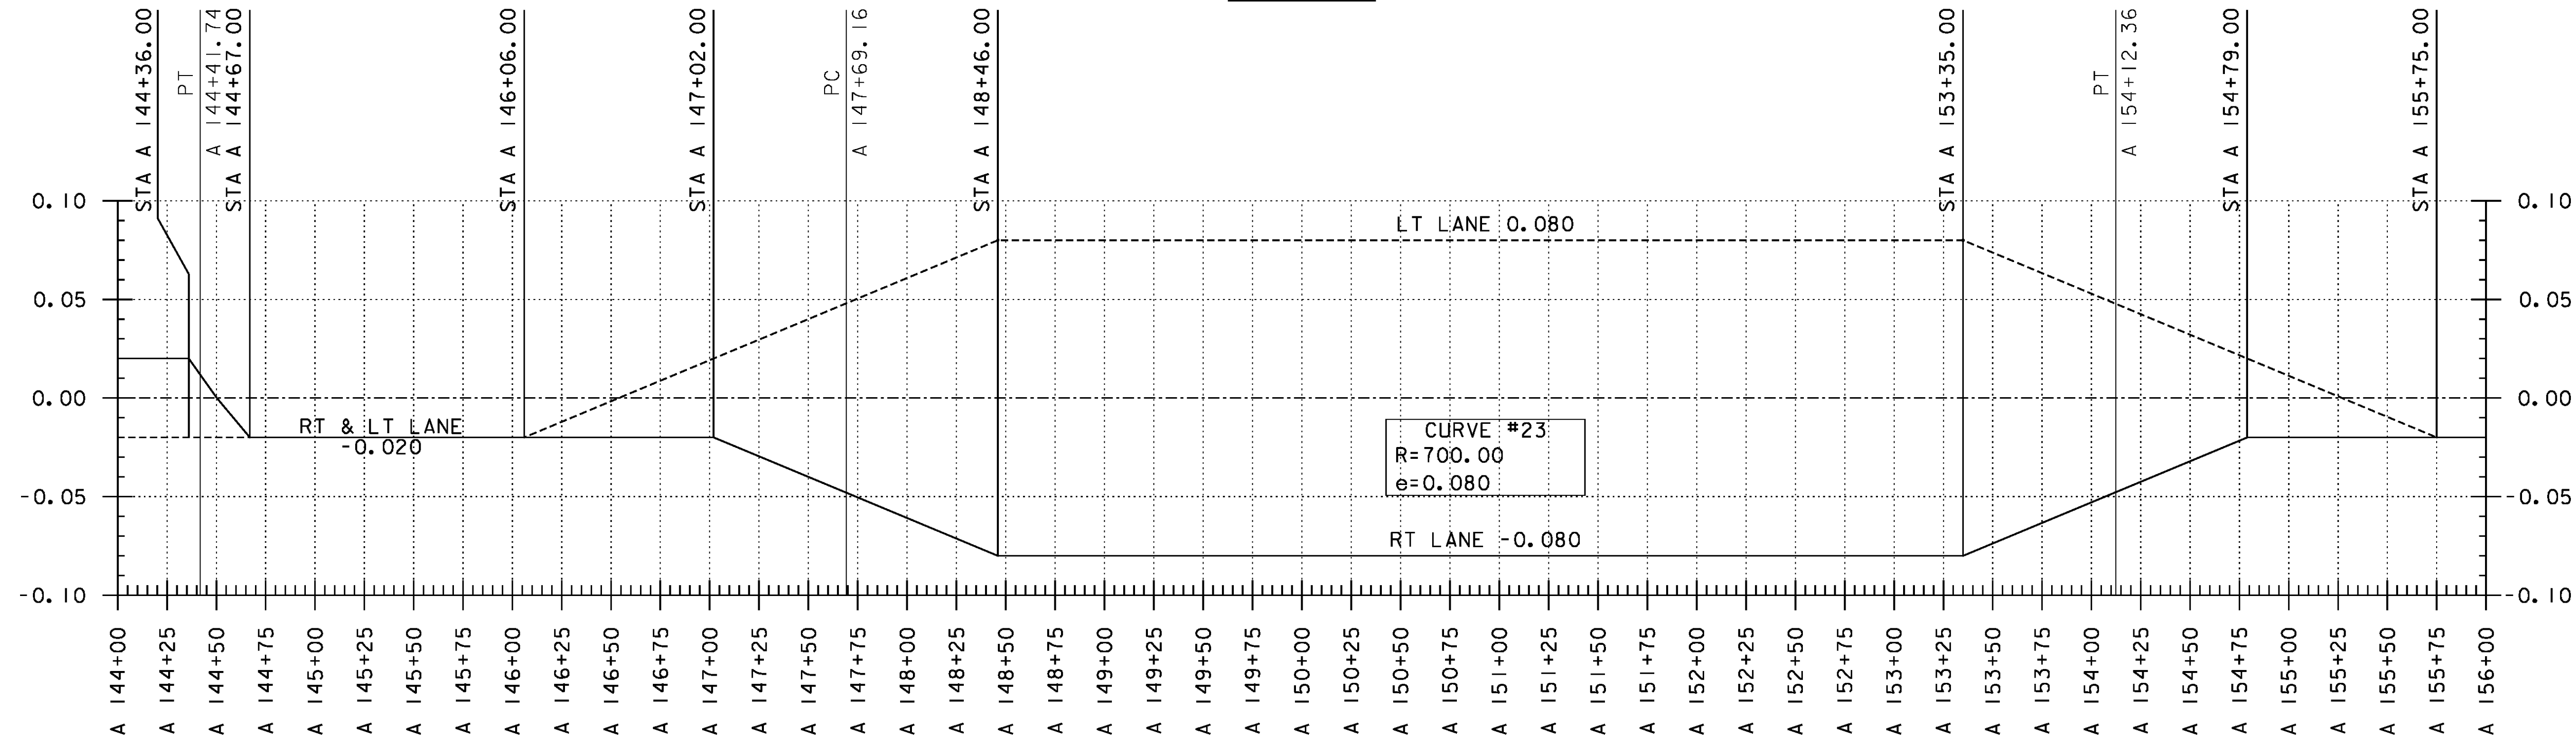

BANKING DIAGRAM

THE GRADES SHOWN TO THE NEAREST TENTH OF A FOOT ARE THE ORIGINAL GROUND ELEVATIONS ALONG THE PROPOSED ALIGNMENT. THE GRADES SHOWN TO THE NEAREST HUNDRETH OF A FOOT ARE FINISH GRADES FOR THE PROPOSED ALIGNMENT. SUPERELEVATIONS ARE SHOWN IN PERCENTAGES.

PROJECT NAME:	WARDSBORO-JAMAICA	PLOT DATE:	2/26/2014
PROJECT NUMBER:	ER STP 013-K(17)	DRAWN BY:	B. KIPP
FILE NAME:	d12b236_pro_bnk	CHECKED BY:	A. KEMPTON
PROJECT LEADER:	K. UPMAL	SHEET	80 OF 444
DESIGNED BY:	B. KIPP	VT 100 PROFILE & BANKING DIAGRAM	