

STEEL BEAM GUARDRAIL, GALVANIZED W/ 8 FT POSTS
 STA A 189+13 - STA A 189+87 LT
 STA A 190+83 - STA A 200+23 RT

REMOVE AND DISPOSE OF GUARDRAIL
 STA A 190+84 - STA A 200+23 RT

EROSION LOG
 STA A 180+50 - STA A 182+50 LT
 STA A 186+75 - STA A 190+75 LT

STEEL BEAM GUARDRAIL, GALVANIZED
 STA A 189+00 - STA A 189+13 LT
 STA A 189+70 - STA A 189+83 RT
 STA A 189+87 - STA A 190+00 LT

STONE FILL, TYPE I
~~STA A 186+00 - STA A 187+50 RT~~

BARRIER FENCE
 STA A 180+50 - STA A 182+50 LT
 STA A 186+75 - STA A 190+75 LT



ANCHOR FOR STEEL BEAM RAIL
 STA A 189+09 LT
 STA A 189+79 RT
 STA A 189+91 LT

GRUBBING MATERIAL
 STA A 186+00 - STA A 187+50 RT

STONE FILL, TYPE I
 STA A 183+70 - STA A 184+16 LT
 STA A 186+27 - STA A 187+30 RT
 STA A 190+20 RT

DELINEATOR WITH STEEL POSTS
 STA A 189+00 LT
 STA A 189+70 RT
 STA A 190+00 LT

GEOTEXTILE FOR SILT FENCE
 STA A 186+00 - STA A 187+50 RT

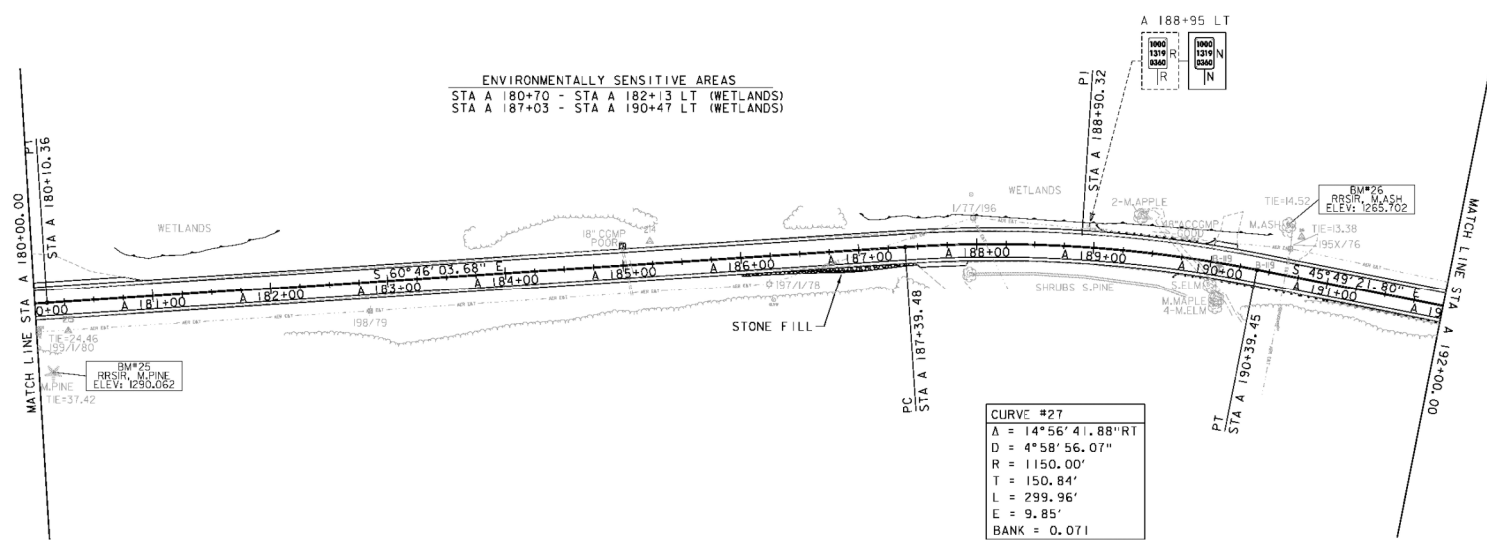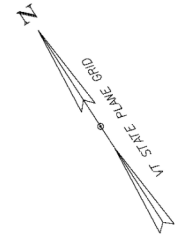

ENVIRONMENTALLY SENSITIVE AREAS
 STA A 180+70 - STA A 182+13 LT (WETLANDS)
 STA A 187+03 - STA A 190+47 LT (WETLANDS)

DURABLE 4 INCH WHITE LINE (SEE OPTION ITEMS)
 STA A 171+06 - STA A 254+52 (SOLID LT)
 STA A 124+12 - STA A 200+24 (SOLID RT)

DURABLE 4 INCH YELLOW LINE (SEE OPTION ITEMS)
 STA A 171+04 - STA A 200+16 (SOLID LT + RT)

TEMPORARY 4 INCH WHITE LINE
 STA A 171+06 - STA A 254+52 (SOLID LT)
 STA A 124+12 - STA A 200+24 (SOLID RT)

TEMPORARY 4 INCH YELLOW LINE
 STA A 171+04 - STA A 200+16 (SOLID LT + RT)

CURVE #27
 A = 14°56'41.88"RT
 D = 4°58'56.07"
 R = 1150.00'
 T = 150.84'
 L = 299.96'
 E = 9.85'
 BANK = 0.071

SIGN LEGEND
 R = REMOVE
 S = SALVAGE
 N = NEW
 RET = RETAIN
 T&T = THINNING & TRIMMING
 E-B = BACK TO BACK
 EXISTING = - - - - -
 NEW = _____



PROJECT NAME:	WARSDBORO-JAMAICA
PROJECT NUMBER:	ER STP 013-1(17)
FILE NAME:	d2b236.bdr.dgn
PROJECT LEADER:	K. UPWAL
DESIGNED BY:	B. KIPP
PLAN SHEET 16	
PLAT DATE:	2/26/2014
DRAWN BY:	B. KIPP
CHECKED BY:	A. KEMPTON
SHEET	85 OF 444