


PROFILE

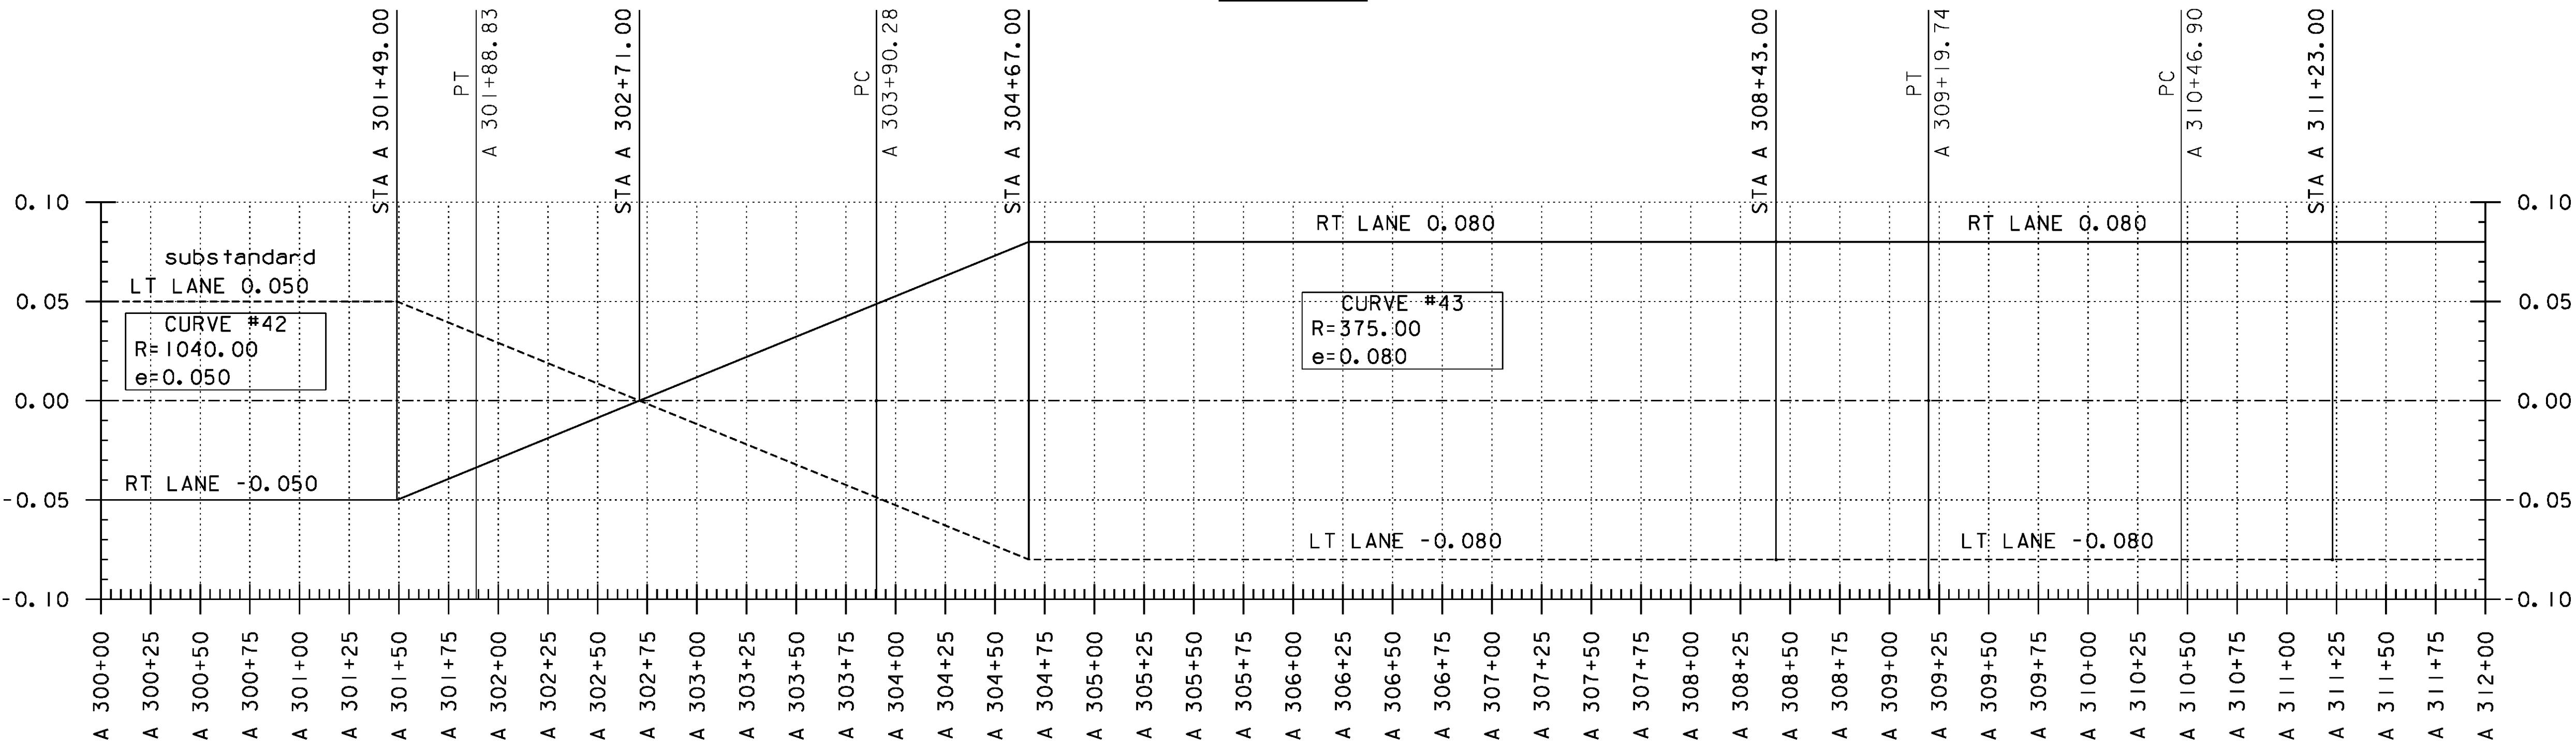

BANKING DIAGRAM

THE GRADES SHOWN TO THE NEAREST TENTH OF A FOOT ARE THE ORIGINAL GROUND ELEVATIONS ALONG THE PROPOSED ALIGNMENT. THE GRADES SHOWN TO THE NEAREST HUNDRETH OF A FOOT ARE FINISH GRADES FOR THE PROPOSED ALIGNMENT. SUPERELEVATIONS ARE SHOWN IN PERCENTAGES.

PROJECT NAME: WARDBORO-JAMAICA	PLOT DATE: 2/26/2014
PROJECT NUMBER: ER STP 013-K(17)	DRAWN BY: B. KIPP
FILE NAME: d12b236_pro_bnk	CHECKED BY: A. KEMPTON
PROJECT LEADER: K. UPMAL	SHEET 106 OF 444
DESIGNED BY: B. KIPP	
VT 100 PROFILE & BANKING DIAGRAM	