

STEEL BEAM GUARDRAIL, GALVANIZED W/ 8 FT POSTS  
 STA A 318+60 - STA A 326+97 RT  
 STA A 332+13 - STA A 340+12 RT

REMOVE AND DISPOSE OF GUARDRAIL  
 STA A 318+60 - STA A 327+00 RT  
 STA A 335+54 - STA A 340+21 RT

EROSION LOG  
 STA A 331+25 - STA A 336+00 RT  
 STA A 332+00 - STA A 335+25 LT

STEEL BEAM GUARDRAIL, GALVANIZED  
 STA A 326+97 - STA A 327+10 RT  
 STA A 332+00 - STA A 332+13 RT

STONE FILL, TYPE I  
 STA A 323+75 - STA A 324+25 RT  
 STA A 326+00 - STA A 327+00 RT

BARRIER FENCE  
 STA A 331+25 - STA A 336+00 RT  
 STA A 332+00 - STA A 335+25 LT


ANCHOR FOR STEEL BEAM RAIL  
 STA A 327+01 RT  
 STA A 332+09 RT

GRUBBING MATERIAL  
 STA A 323+75 - STA A 324+25 RT  
 STA A 326+00 - STA A 327+00 RT

RELOCATE MAILBOX, SINGLE SUPPORT  
 STA A 330+02 LT

DELINEATOR WITH STEEL POSTS  
 STA A 327+10 RT  
 STA A 332+00 RT


GEOTEXTILE FOR SILT FENCE  
 STA A 323+75 - STA A 324+25 RT  
 STA A 326+00 - STA A 327+00 RT

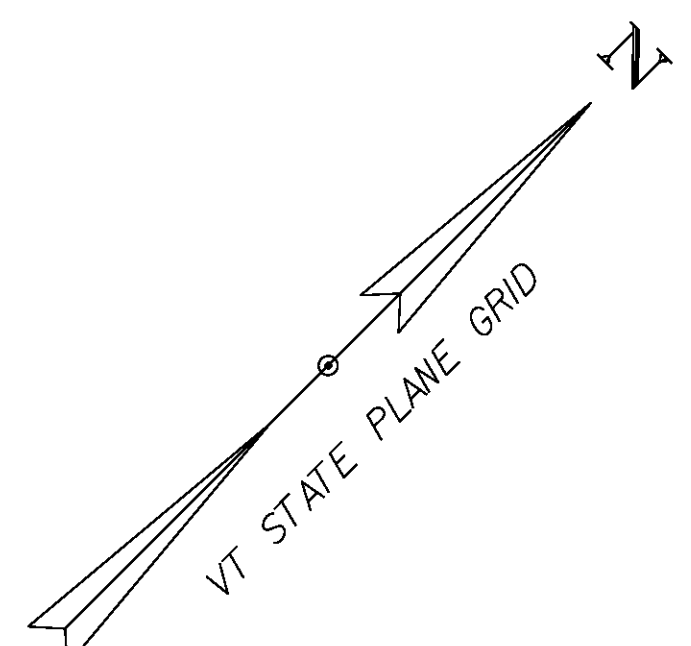

**CURVE #48**  
 $\Delta = 9^{\circ}22'51.24''$  LT  
 $D = 4^{\circ}46'28.73''$   
 $R = 1200.00'$   
 $T = 98.46'$   
 $L = 196.47'$   
 $E = 4.03'$   
 $BANK = 0.070$

**CURVE #49**  
 $\Delta = 1^{\circ}53'05.93''$  LT  
 $D = 0^{\circ}59'59.73''$   
 $R = 5730.00'$   
 $T = 94.26'$   
 $L = 188.51'$   
 $E = 0.78'$   
 $BANK = 0.021$

**CURVE #50**  
 $\Delta = 17^{\circ}58'10.86''$  LT  
 $D = 6^{\circ}59'14.24''$   
 $R = 820'$   
 $T = 129.65'$   
 $L = 257.18'$   
 $E = 10.19'$   
 $BANK = 0.056$

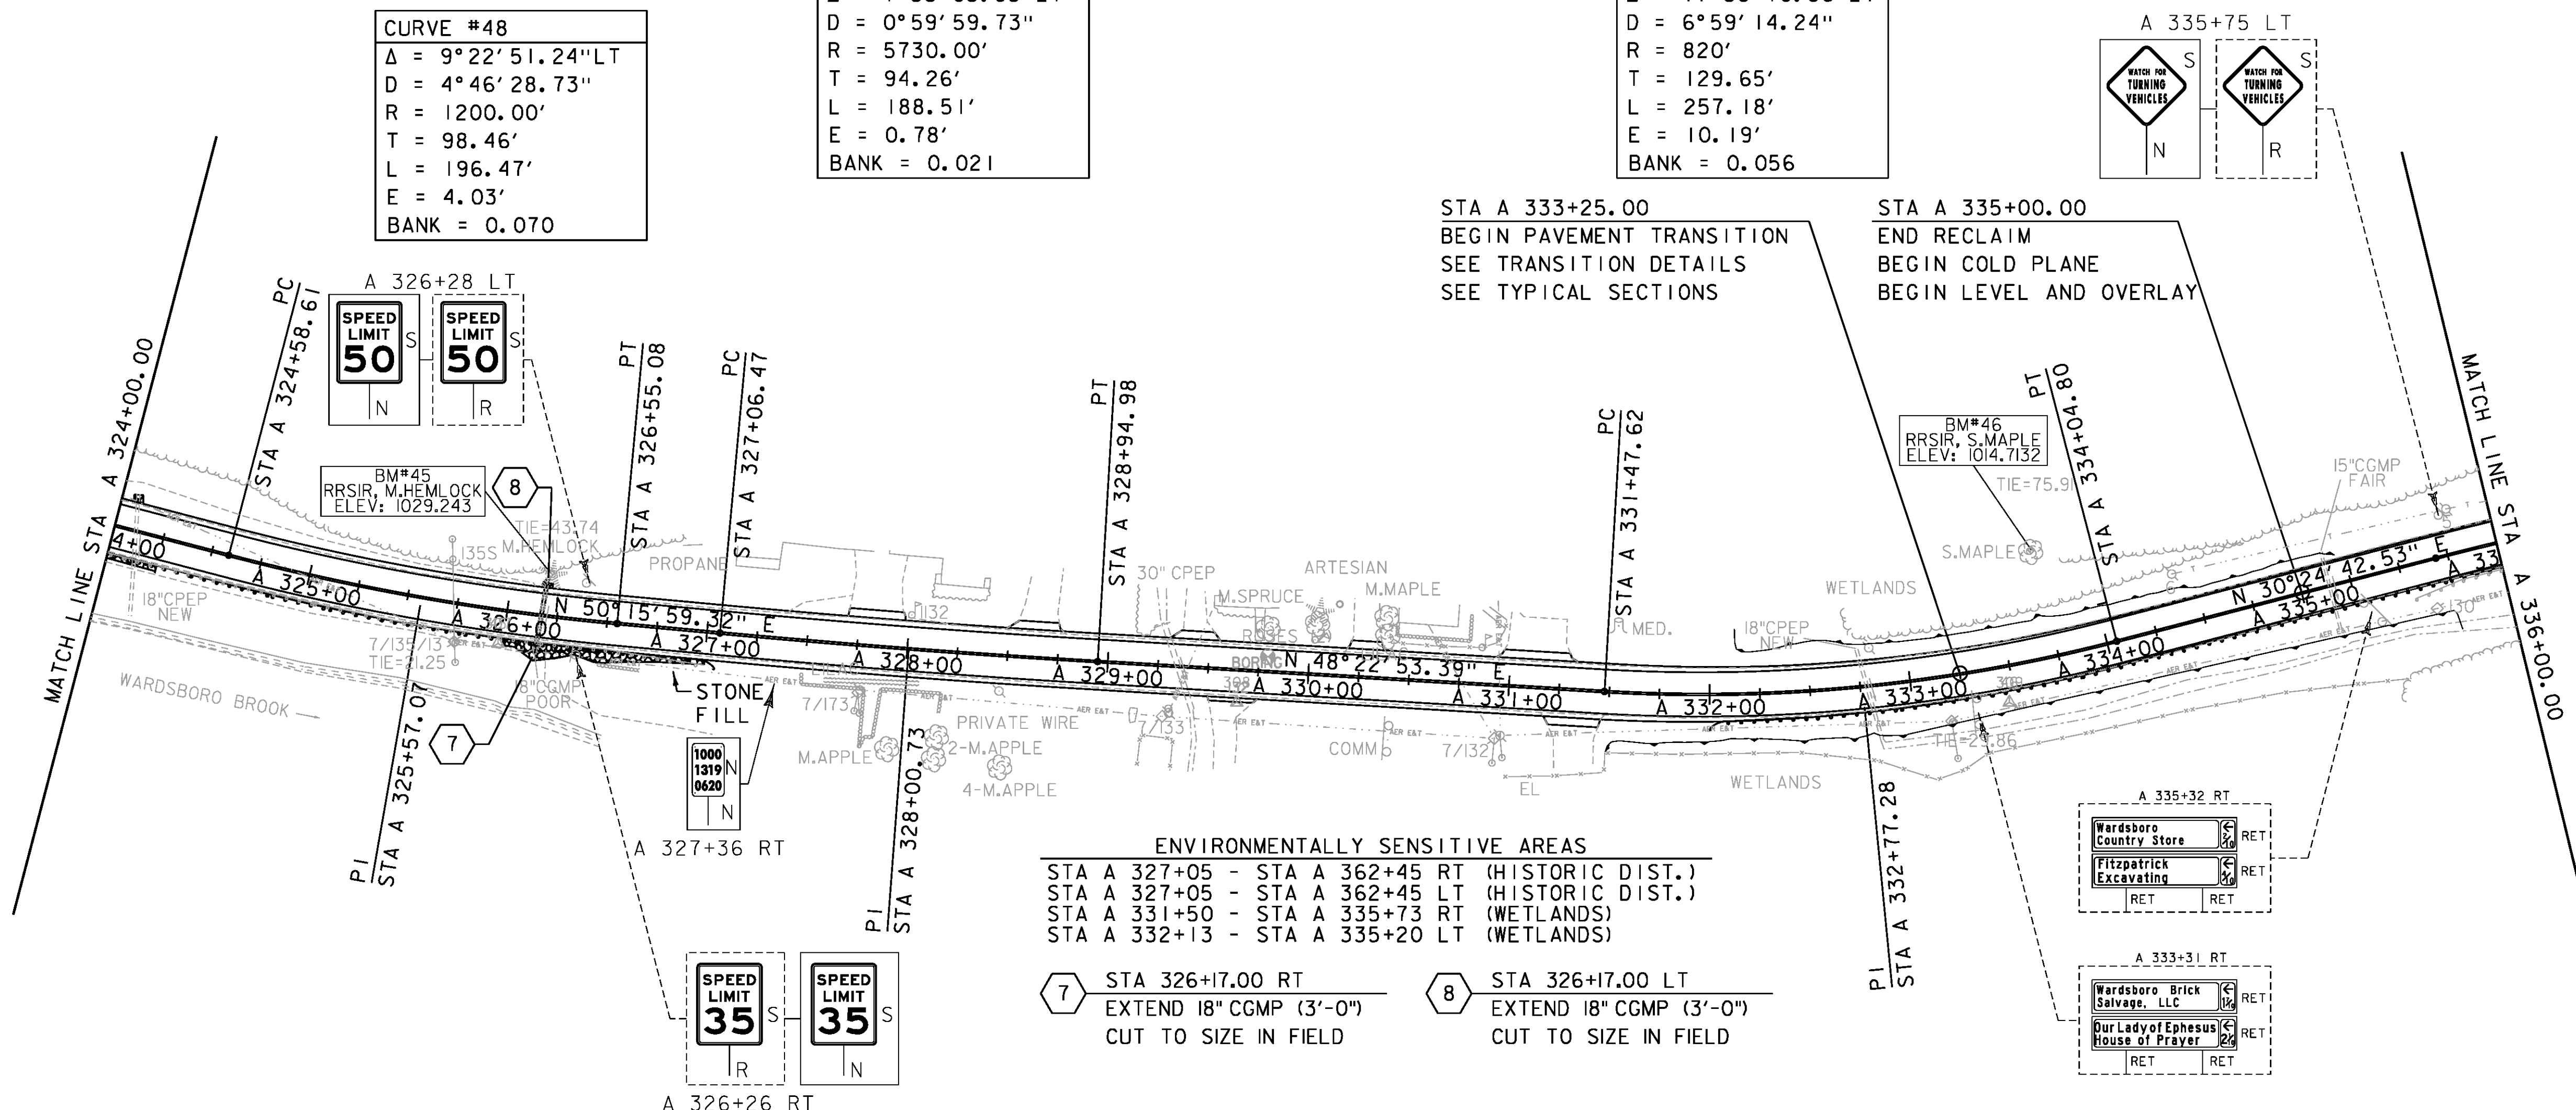

STA A 333+25.00  
 BEGIN PAVEMENT TRANSITION  
 SEE TRANSITION DETAILS  
 SEE TYPICAL SECTIONS

STA A 335+00.00  
 END RECLAIM  
 BEGIN COLD PLANE  
 BEGIN LEVEL AND OVERLAY

**ENVIRONMENTALLY SENSITIVE AREAS**  
 STA A 327+05 - STA A 362+45 RT (HISTORIC DIST.)  
 STA A 327+05 - STA A 362+45 LT (HISTORIC DIST.)  
 STA A 331+50 - STA A 335+73 RT (WETLANDS)  
 STA A 332+13 - STA A 335+20 LT (WETLANDS)

7 STA 326+17.00 RT  
 EXTEND 18" CGMP (3'-0")  
 CUT TO SIZE IN FIELD

8 STA 326+17.00 LT  
 EXTEND 18" CGMP (3'-0")  
 CUT TO SIZE IN FIELD

DURABLE 4 INCH WHITE LINE (SEE OPTION ITEMS)  
 STA A 273+32 - STA A 342+19 (SOLID LT)  
 STA A 273+11 - STA A 346+85 (SOLID RT)

DURABLE 4 INCH YELLOW LINE (SEE OPTION ITEMS)  
 STA A 273+41 - STA A 342+22 (SOLID LT + RT)

TEMPORARY 4 INCH WHITE LINE  
 STA A 273+32 - STA A 342+19 (SOLID LT)  
 STA A 273+11 - STA A 346+85 (SOLID RT)

TEMPORARY 4 INCH YELLOW LINE  
 STA A 273+41 - STA A 342+22 (SOLID LT + RT)

**SIGN LEGEND**  
 R = REMOVE  
 S = SALVAGE  
 N = NEW  
 RET = RETAIN  
 T&T = THINNING & TRIMMING  
 B-B = BACK TO BACK  
 EXISTING = DASHED LINE  
 NEW = SOLID LINE



PROJECT NAME: WARDBORO-JAMAICA  
 PROJECT NUMBER: ER STP 013-1(17)

FILE NAME: dl2b236\_bdr.dgn  
 PROJECT LEADER: K. UPMAL  
 DESIGNED BY: B. KIPP  
 PLAN SHEET 28

PLOT DATE: 2/26/2014  
 DRAWN BY: B. KIPP  
 CHECKED BY: A. KEMPTON  
 SHEET 109 OF 444