


STEEL BEAM GUARDRAIL, GALVANIZED W/ 8 FT POSTS  
 STA A 332+13 - STA A 340+12 RT  
 STA A 346+97 - STA A 347+90 RT

STEEL BEAM GUARDRAIL, GALVANIZED  
 STA A 340+07 - STA A 340+20 RT  
 STA A 347+90 - STA A 348+03 RT

ANCHOR FOR STEEL BEAM RAIL  
 STA A 340+11 RT  
 STA A 347+94 RT

DELINEATOR WITH STEEL POSTS  
 STA A 340+20 RT

REMOVE AND DISPOSE OF GUARDRAIL  
 STA A 335+54 - STA A 340+21 RT  
 STA A 346+97 - STA A 348+01 RT

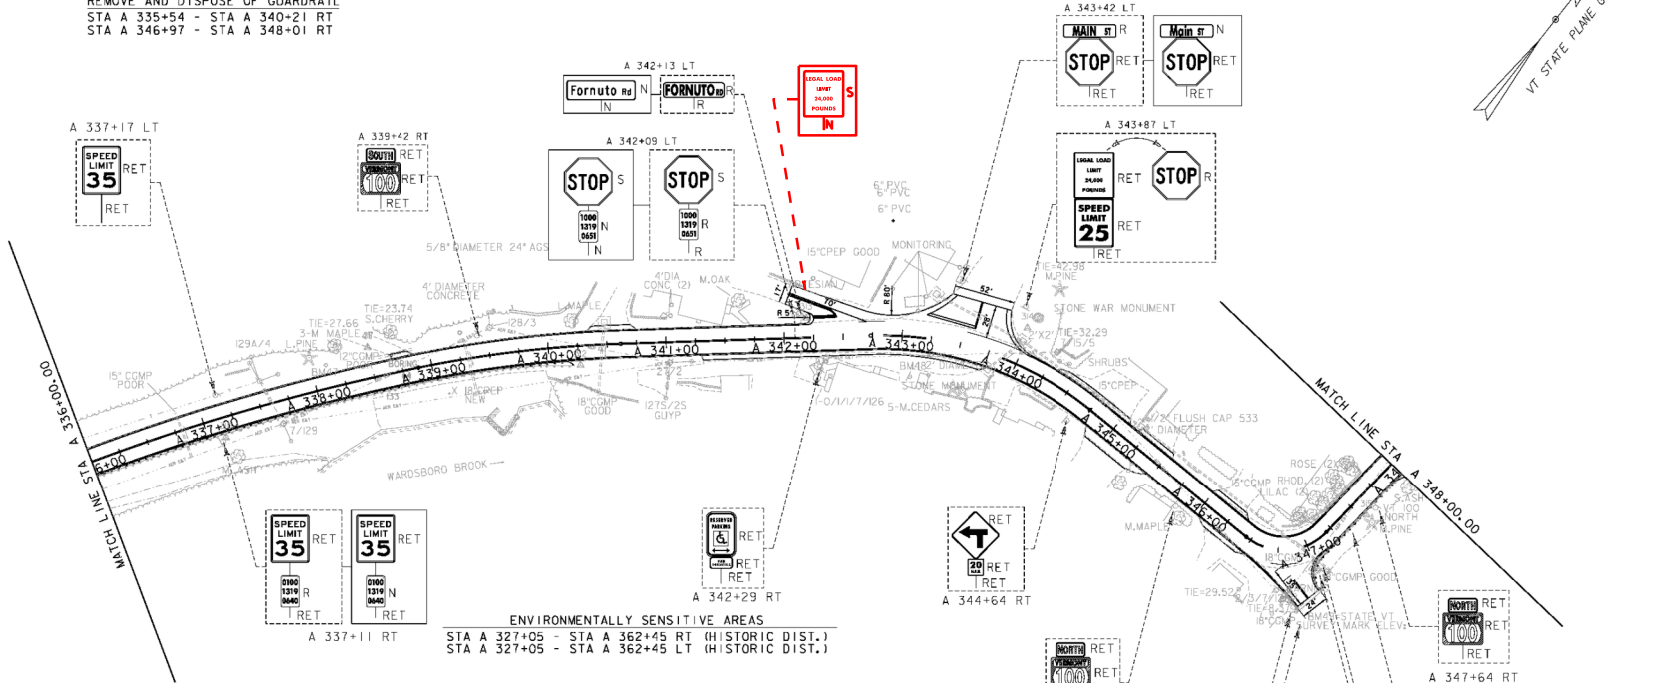

ENVIRONMENTALLY SENSITIVE AREAS  
 STA A 327+05 - STA A 362+45 RT (HISTORIC DIST.)  
 STA A 327+05 - STA A 362+45 LT (HISTORIC DIST.)

DURABLE 4 INCH WHITE LINE (SEE OPTION ITEMS)  
 STA A 273+32 - STA A 342+19 (SOLID LT)  
 STA A 343+18 - STA A 343+39 (SOLID LT)  
 STA A 343+77 - STA A 373+47 (SOLID LT)  
 STA A 273+11 - STA A 346+85 (SOLID RT)  
 STA A 346+96 - STA B 118+68 (SOLID RT)

TEMPORARY 4 INCH WHITE LINE  
 STA A 273+32 - STA A 342+19 (SOLID LT)  
 STA A 343+18 - STA A 343+39 (SOLID LT)  
 STA A 343+77 - STA A 373+47 (SOLID LT)  
 STA A 273+11 - STA A 346+85 (SOLID RT)  
 STA A 346+96 - STA B 118+68 (SOLID RT)

DURABLE 4 INCH YELLOW LINE (SEE OPTION ITEMS)  
 STA A 273+41 - STA A 342+22 (SOLID LT + RT)  
 STA A 342+44 LT (CENTER LINES TH #14)  
 STA A 342+84 - STA A 343+20 (SOLID LT + RT)  
 STA A 343+58 LT (CENTER LINES TH #5)  
 STA A 343+87 - STA A 346+62 (SOLID LT + RT)  
 STA A 346+85 RT (CENTER LINES TH #2)  
 STA A 346+97 - STA A 373+40 (SOLID LT + RT)

TEMPORARY 4 INCH YELLOW LINE  
 STA A 273+41 - STA A 342+22 (SOLID LT + RT)  
 STA A 342+44 LT (CENTER LINES TH #14)  
 STA A 342+84 - STA A 343+20 (SOLID LT + RT)  
 STA A 343+58 LT (CENTER LINES TH #5)  
 STA A 343+87 - STA A 346+62 (SOLID LT + RT)  
 STA A 346+85 RT (CENTER LINES TH #2)  
 STA A 346+97 - STA A 373+40 (SOLID LT + RT)

DURABLE 24 IN STOP BAR (SEE OPTION ITEMS)  
 STA A 342+86 LT  
 STA A 343+49 LT  
 STA A 346+90 RT

DURABLE LETTER OR SYMBOL (SEE OPTION ITEMS)  
 STA A 342+86 LT "STOP"  
 STA A 343+49 LT "STOP"  
 STA A 346+90 RT "STOP"

REHAB. DROP INLETS,  
 CATCH BASINS OR MANHOLES, CLASS II  
 STA A 340+48 LT  
 STA A 343+25 LT  
 STA A 343+79 RT  
 STA A 343+97 LT  
 STA A 345+17 LT  
 STA A 346+82 RT  
 STA A 346+97 RT

SIGN LEGEND  
 R = REMOVE  
 S = SALVAGE  
 N = NEW  
 RET = RETAIN  
 T&T = THINNING & TRIMMING  
 B-B = BACK TO BACK  
 EXISTING = DASHED  
 NEW = SOLID



PROJECT NAME: WARDSBORO-JAMAICA  
 PROJECT NUMBER: ER STP 013-1(17)  
 FILE NAME: d2b236\_bdr.dgn  
 PROJECT LEADER: K. UPWAL  
 DESIGNED BY: B. KIPP  
 PLAN SHEET 29  
 PLOT DATE: 2/26/2014  
 DRAWN BY: B. KIPP  
 CHECKED BY: A. KEMPTON  
 SHEET III OF 444