


PROFILE

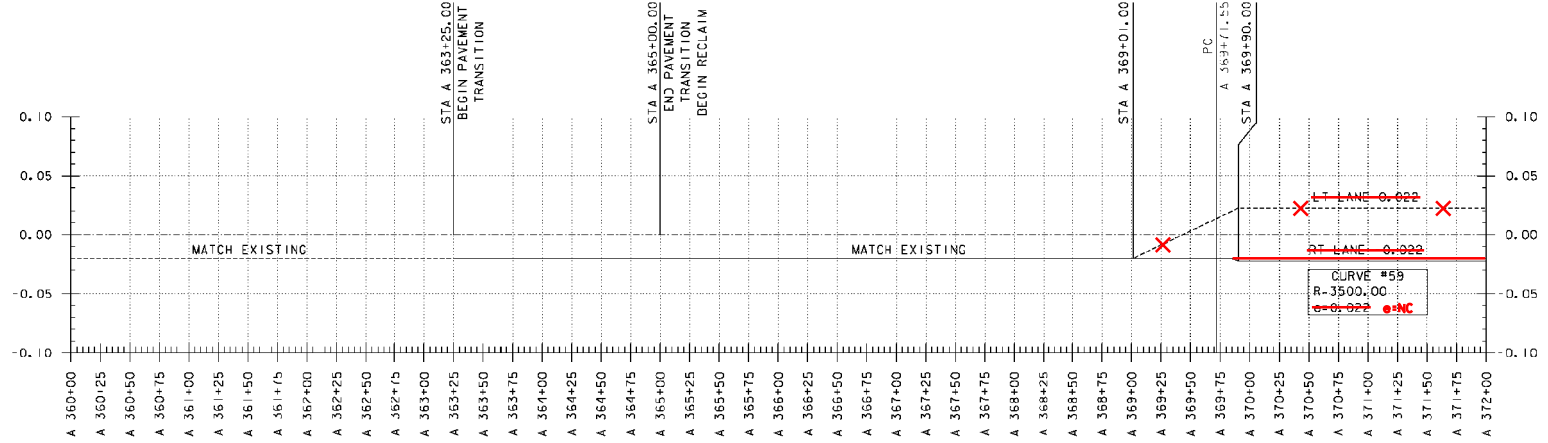

BANKING DIAGRAM

THE GRADES SHOWN TO THE NEAREST TENTH OF A FOOT ARE THE ORIGINAL GROUND ELEVATIONS ALONG THE PROPOSED ALIGNMENT. THE GRADES SHOWN TO THE NEAREST HUNDRETH OF A FOOT ARE FINISH GRADES FOR THE PROPOSED ALIGNMENT. SUPERELEVATIONS ARE SHOWN IN PFCFGTAGFS.

PROJECT NAME:	WARDSBORO-JAMAICA
PROJECT NUMBER:	ER STP 013-1(I7)
FILE NAME:	c12b235.pro.bnk
PROJECT LEADER:	K.LPWAL
DESIGNED BY:	E.KJPP
VT 100 PROFILE & BANKING DIAGRAM	
PLOT DATE:	2/26/2014
DRAWN BY:	E.KJPP
CHECKED BY:	A.KEMPTON
SHEET	14 OF 444