


PROFILE

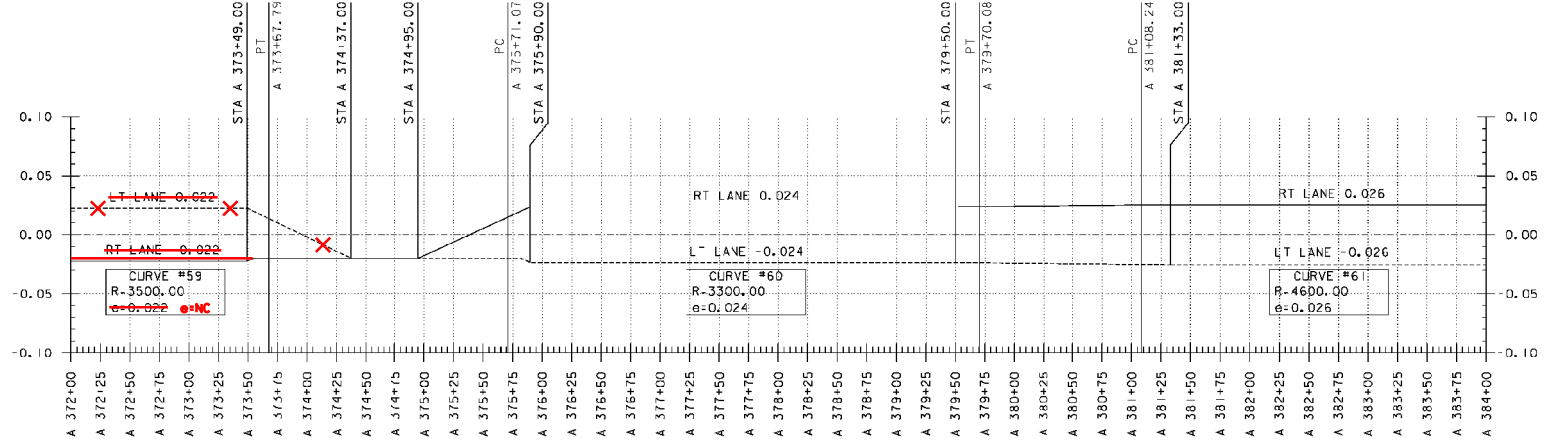

BANKING DIAGRAM

THE GRADES SHOWN TO THE NEAREST TENTH OF A FOOT ARE THE ORIGINAL GROUND ELEVATIONS ALONG THE PROPOSED ALIGNMENT. THE GRADES SHOWN TO THE NEAREST HUNDRETH OF A FOOT ARE FINISH GRADES FOR THE PROPOSED ALIGNMENT. SUPERELEVATIONS ARE SHOWN IN PFCRGNTAGFS.

| | |
|----------------------------------|-------------------|
| PROJECT NAME: | WARDSBORO-JAMAICA |
| PROJECT NUMBER: | ER STP 013-1(17) |
| FILE NAME: | c12b235.pro.bnk |
| PROJECT LEADER: | K. LPMAL |
| DESIGNED BY: | E. KJPP |
| VT 100 PROFILE & BANKING DIAGRAM | |
| PLOT DATE: | 2/26/2014 |
| DRAWN BY: | B. KJPP |
| CHECKED BY: | A. KEMPTON |
| SHEET | 16 OF 444 |