

STEEL BEAM GUARDRAIL, GALVANIZED W/ 8 FT POSTS  
STA A 384+92 - STA B 0+43 RT

REMOVE AND DISPOSE OF GUARDRAIL  
STA A 384+89 - STA B 0+51 RT

RELOCATE MAILBOX, SINGLE SUPPORT  
STA B 4+34 LT

STEEL BEAM GUARDRAIL, GALVANIZED  
STA A 384+79 - STA A 384+92 RT  
STA B 0+43 - STA B 0+53 RT



STONE FILL, TYPE I  
STA A 381+00 - STA A 387+00 RT  
STA B 3+70 - STA B 4+25 LT  
STA B 5+50 - STA B 7+00 LT

ANCHOR FOR STEEL BEAM RAIL  
STA B 0+47 RT

GRUBBING MATERIAL  
STA A 381+00 - STA A 387+00 RT  
STA B 3+70 - STA B 4+25 LT  
STA B 5+50 - STA B 7+00 LT

DELINEATOR WITH STEEL POSTS  
STA A 384+79 RT  
STA B 0+53 RT

GEOTEXTILE FOR SILT FENCE  
STA A 381+00 - STA A 387+00 RT  
STA B 3+70 - STA B 4+25 LT  
STA B 5+50 - STA B 7+00 LT

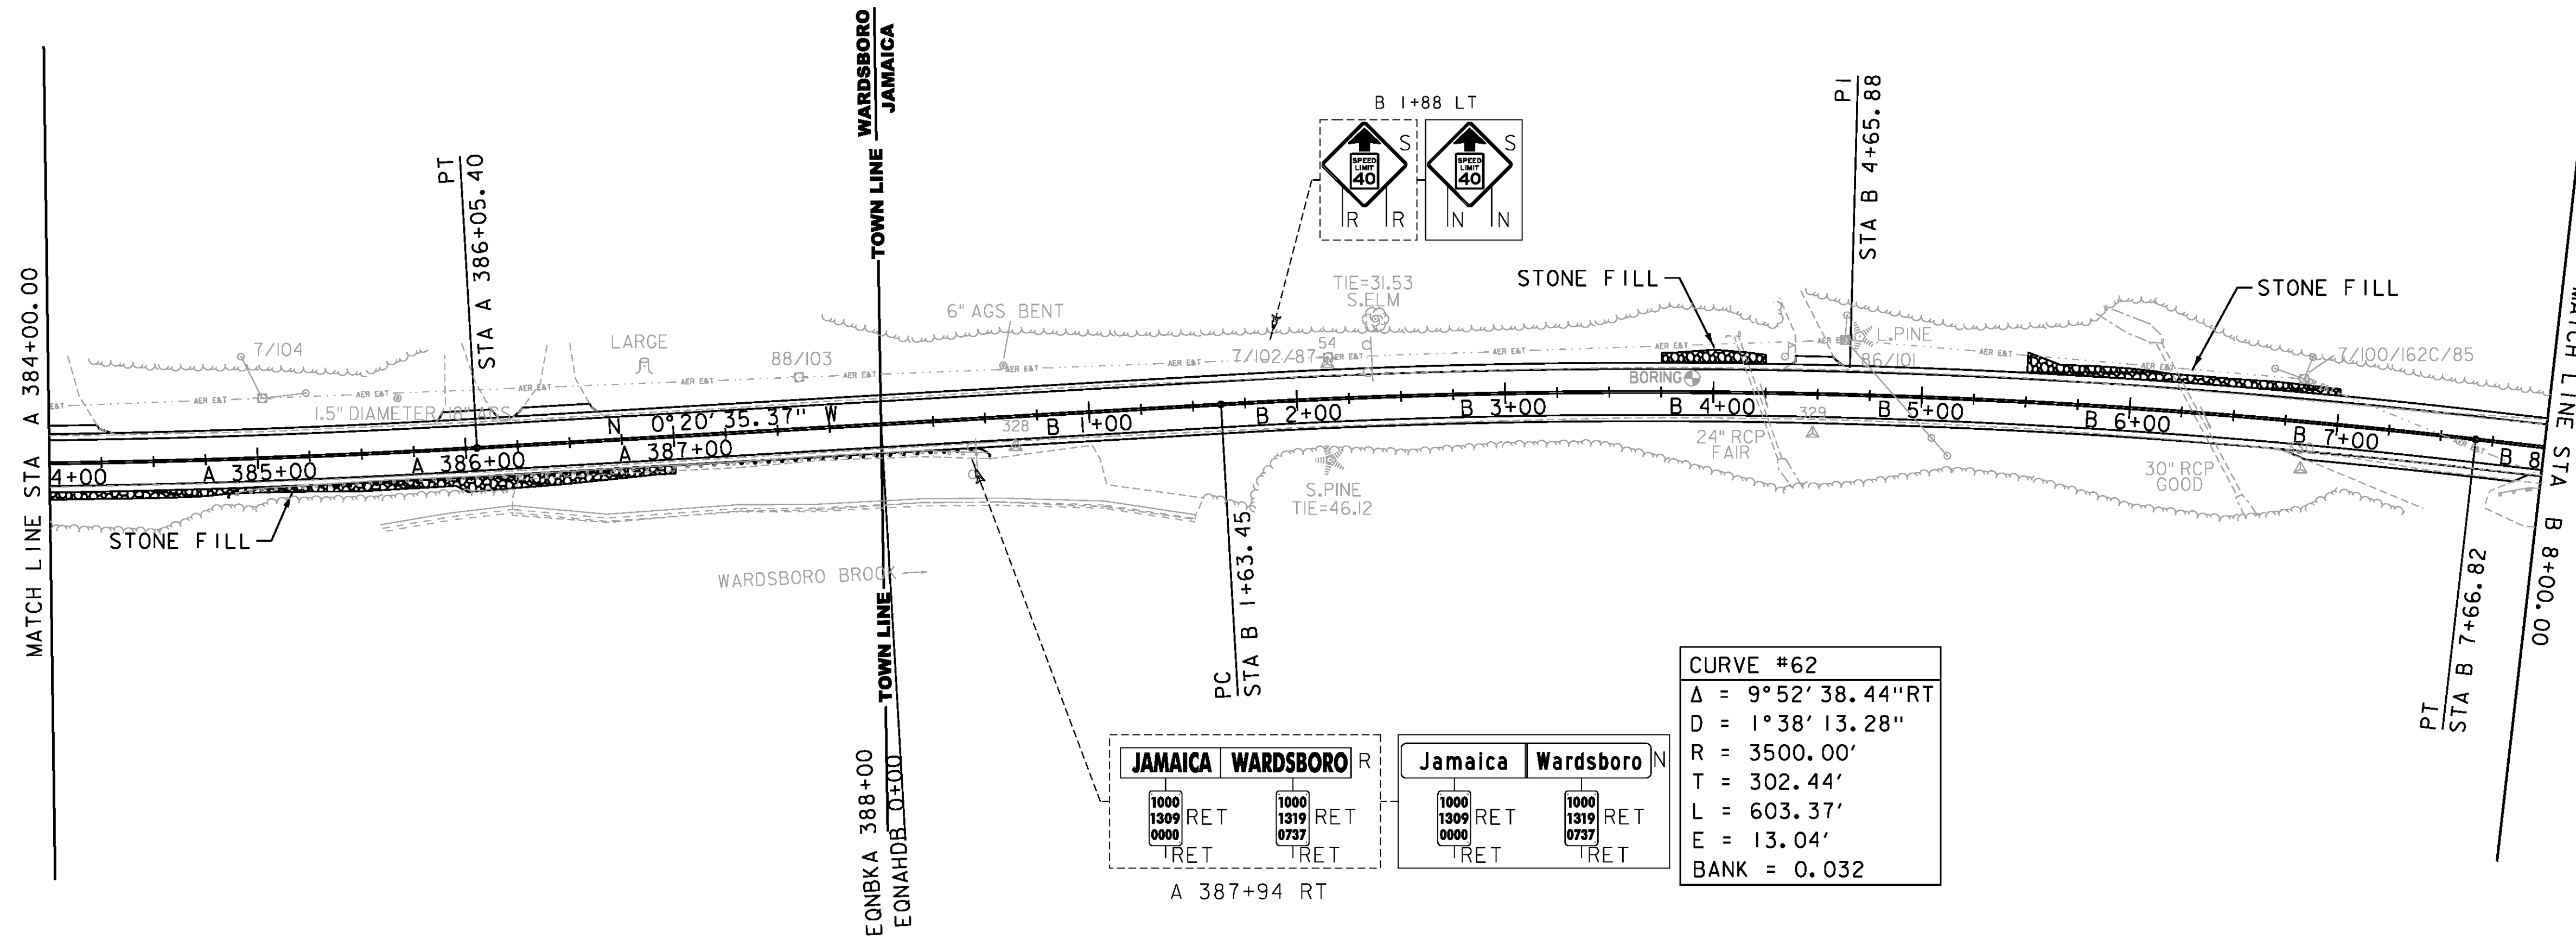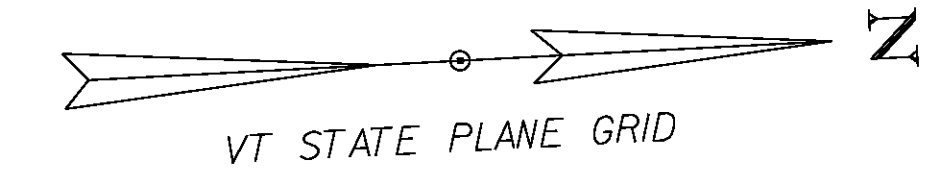


DURABLE 4 INCH WHITE LINE (SEE OPTION ITEMS)  
STA A 373+69 - STA B 119+24 (SOLID LT)  
STA A 346+96 - STA B 118+68 (SOLID RT)

DURABLE 4 INCH YELLOW LINE (SEE OPTION ITEMS)  
STA A 373+76 - STA B 118+58 (SOLID LT + RT)

TEMPORARY 4 INCH WHITE LINE  
STA A 373+69 - STA B 119+24 (SOLID LT)  
STA A 346+96 - STA B 118+68 (SOLID RT)

TEMPORARY 4 INCH YELLOW LINE  
STA A 373+76 - STA B 118+58 (SOLID LT + RT)

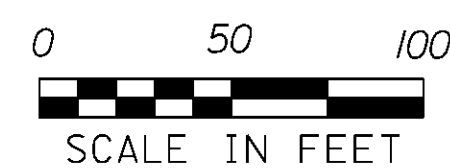

SIGN LEGEND	
R	= REMOVE
S	= SALVAGE
N	= NEW
RET	= RETAIN
T&T	= THINNING & TRIMMING
B-B	= BACK TO BACK
EXISTING	
NEW	

PROJECT NAME:	WARDSBORO-JAMAICA	PLOT DATE:	2/26/2014
PROJECT NUMBER:	ER STP 013-K(17)	DRAWN BY:	B. KIPP
FILE NAME:	dl2b236_bdr.dgn	CHECKED BY:	A. KEMPTON
PROJECT LEADER:	K. UPMAL	SHEET	117 OF 444
DESIGNED BY:	B. KIPP		
PLAN SHEET	33		