

STEEL BEAM GUARDRAIL, GALVANIZED W/ 8 FT POSTS  
STA B 12+87 - STA B 25+00 LT

STEEL BEAM GUARDRAIL, GALVANIZED  
STA B 25+00 - B STA 25+13 LT

ANCHOR FOR STEEL BEAM RAIL  
STA B 25+04 LT



DELINEATOR WITH STEEL POSTS  
STA B 25+13 LT

REMOVE AND DISPOSE OF GUARDRAIL  
STA B 12+73 - STA B 25+06 LT

STONE FILL, TYPE I  
STA B 13+65 - STA B 20+05 LT  
STA B 23+25 - STA B 24+00 LT  
~~STA B 27+55 - STA B 29+50 LT~~  
**STA B 27+52 - STA B 28+75 LT**

GRUBBING MATERIAL  
STA B 13+65 - STA B 20+05 LT  
STA B 23+25 - STA B 24+00 LT  
STA B 27+55 - STA B 29+50 LT

GEOTEXTILE FOR SILT FENCE  
STA B 13+65 - STA B 20+05 LT  
STA B 23+25 - STA B 24+00 LT  
STA B 27+55 - STA B 29+50 LT

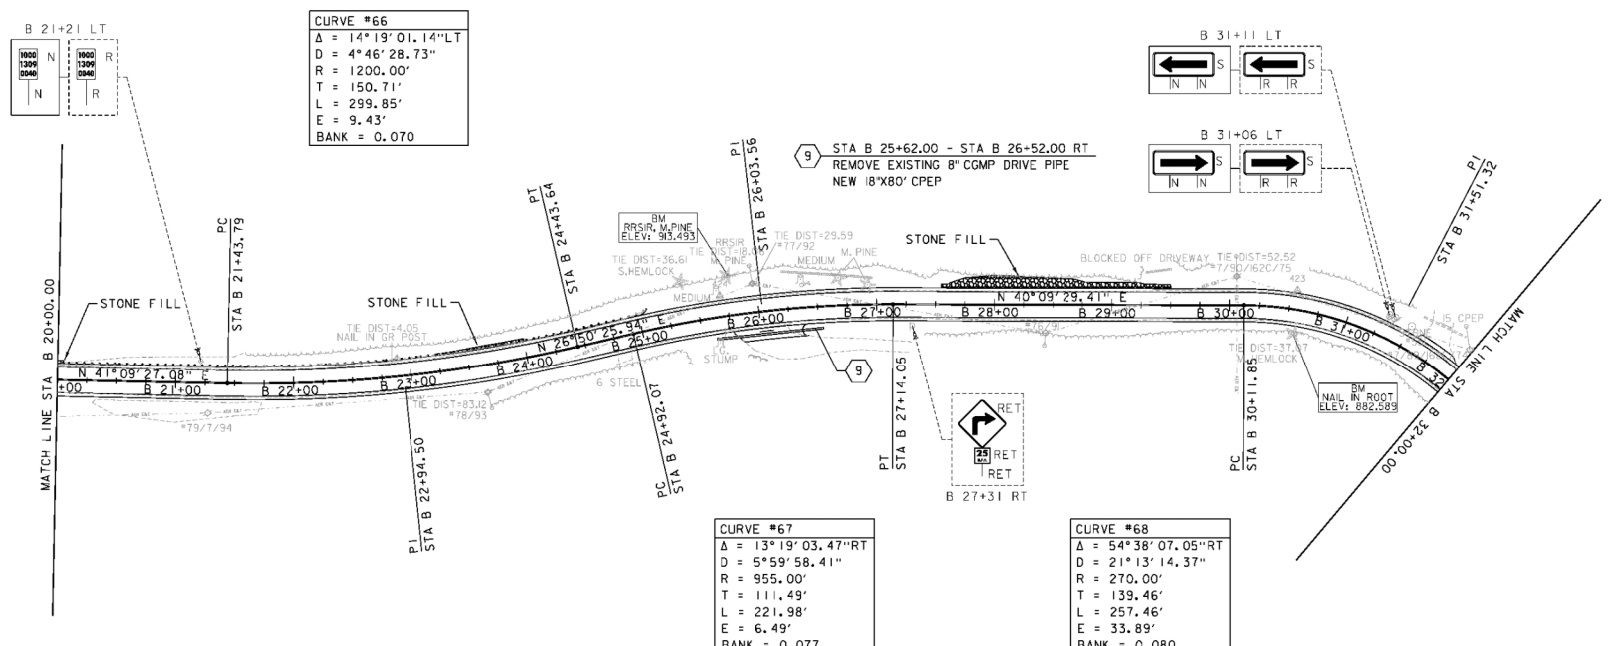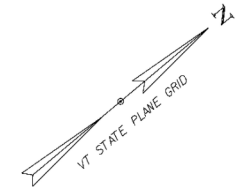

**CURVE #66**  
 $\Delta = 14^\circ 19' 01.14'' \text{ LT}$   
 $D = 4^\circ 46' 28.73''$   
 $R = 1200.00'$   
 $T = 150.71'$   
 $L = 299.85'$   
 $E = 9.43'$   
 $BANK = 0.070$

**CURVE #67**  
 $\Delta = 13^\circ 19' 03.47'' \text{ RT}$   
 $D = 5^\circ 59' 58.41''$   
 $R = 955.00'$   
 $T = 111.49'$   
 $L = 221.98'$   
 $E = 6.49'$   
 $BANK = 0.077$

**CURVE #68**  
 $\Delta = 54^\circ 38' 07.05'' \text{ RT}$   
 $D = 21^\circ 13' 14.37''$   
 $R = 270.00'$   
 $T = 139.46'$   
 $L = 257.46'$   
 $E = 33.89'$   
 $BANK = 0.080$

**DURABLE 4 INCH WHITE LINE (SEE OPTION ITEMS)**  
 STA A 373+69 - STA B 119+24 (SOLID LT)  
 STA A 346+96 - STA B 118+68 (SOLID RT)

**DURABLE 4 INCH YELLOW LINE (SEE OPTION ITEMS)**  
 STA A 373+76 - STA B 118+58 (SOLID LT + RT)

**TEMPORARY 4 INCH WHITE LINE**  
 STA A 373+69 - STA B 119+24 (SOLID LT)  
 STA A 346+96 - STA B 118+68 (SOLID RT)

**TEMPORARY 4 INCH YELLOW LINE**  
 STA A 373+76 - STA B 118+58 (SOLID LT + RT)



**SIGN LEGEND**

R	= REMOVE
S	= SALVAGE
N	= NEW
RET	= RETAIN
T&T	= THINNING & TRIMMING
B-B	= BACK TO BACK
EXISTING	_____
NEW	_____

PROJECT NAME:	WARDSBORO-JAMAICA
PROJECT NUMBER:	ER STP 013-1(I17)
FILE NAME:	d2b236_bdr.dgn
PROJECT LEADER:	K. UPWAL
DESIGNED BY:	B. KIPP
PLAN SHEET 35	
PLOT DATE:	2/26/2014
DRAWN BY:	B. KIPP
CHECKED BY:	A. KEMPTON
SHEET	121 OF 444